


Match Mark for Sheet #27

7128+00 I.C. 112815

 


CROSSING  
NO. 135, 99-IN.

Year	Change
1951	Exchange
1952	"
1953	"
1954	"
1955	"
1956	"
1957	"
1958	"
1959	"
1960	"


### RIGHT-OF-WAY AND TRACK MAP

THE CLEVELAND, CINCINNATI, CHICAGO & ST. LOUIS RY. CO.  
THE CLEVELAND, CINCINNATI, CHICAGO & ST. LOUIS RY.  
Operated by  
**THE CLEVELAND, CINCINNATI, CHICAGO & ST. LOUIS RY. CO.**  
INDIANAPOLIS DIVISION - MAIN LINE  
Sta. 7128+00 To Sta. 7233+60  
Scale 1 in. = 200 Ft.  
June 30th, 1915.  
Office of Valuation Engineer, Cincinnati, O.

Sheet No. 88. V. 4. I. C. & S. T. L. Ry. Co.  
From Survey Station 7128+00  
Valuation Engineer  
Checked by  
Approved by  
Connects to Sheet #134  
Connects to Sheet #135

Match Mark for Sheet #29

7233+60 I.C. 112815

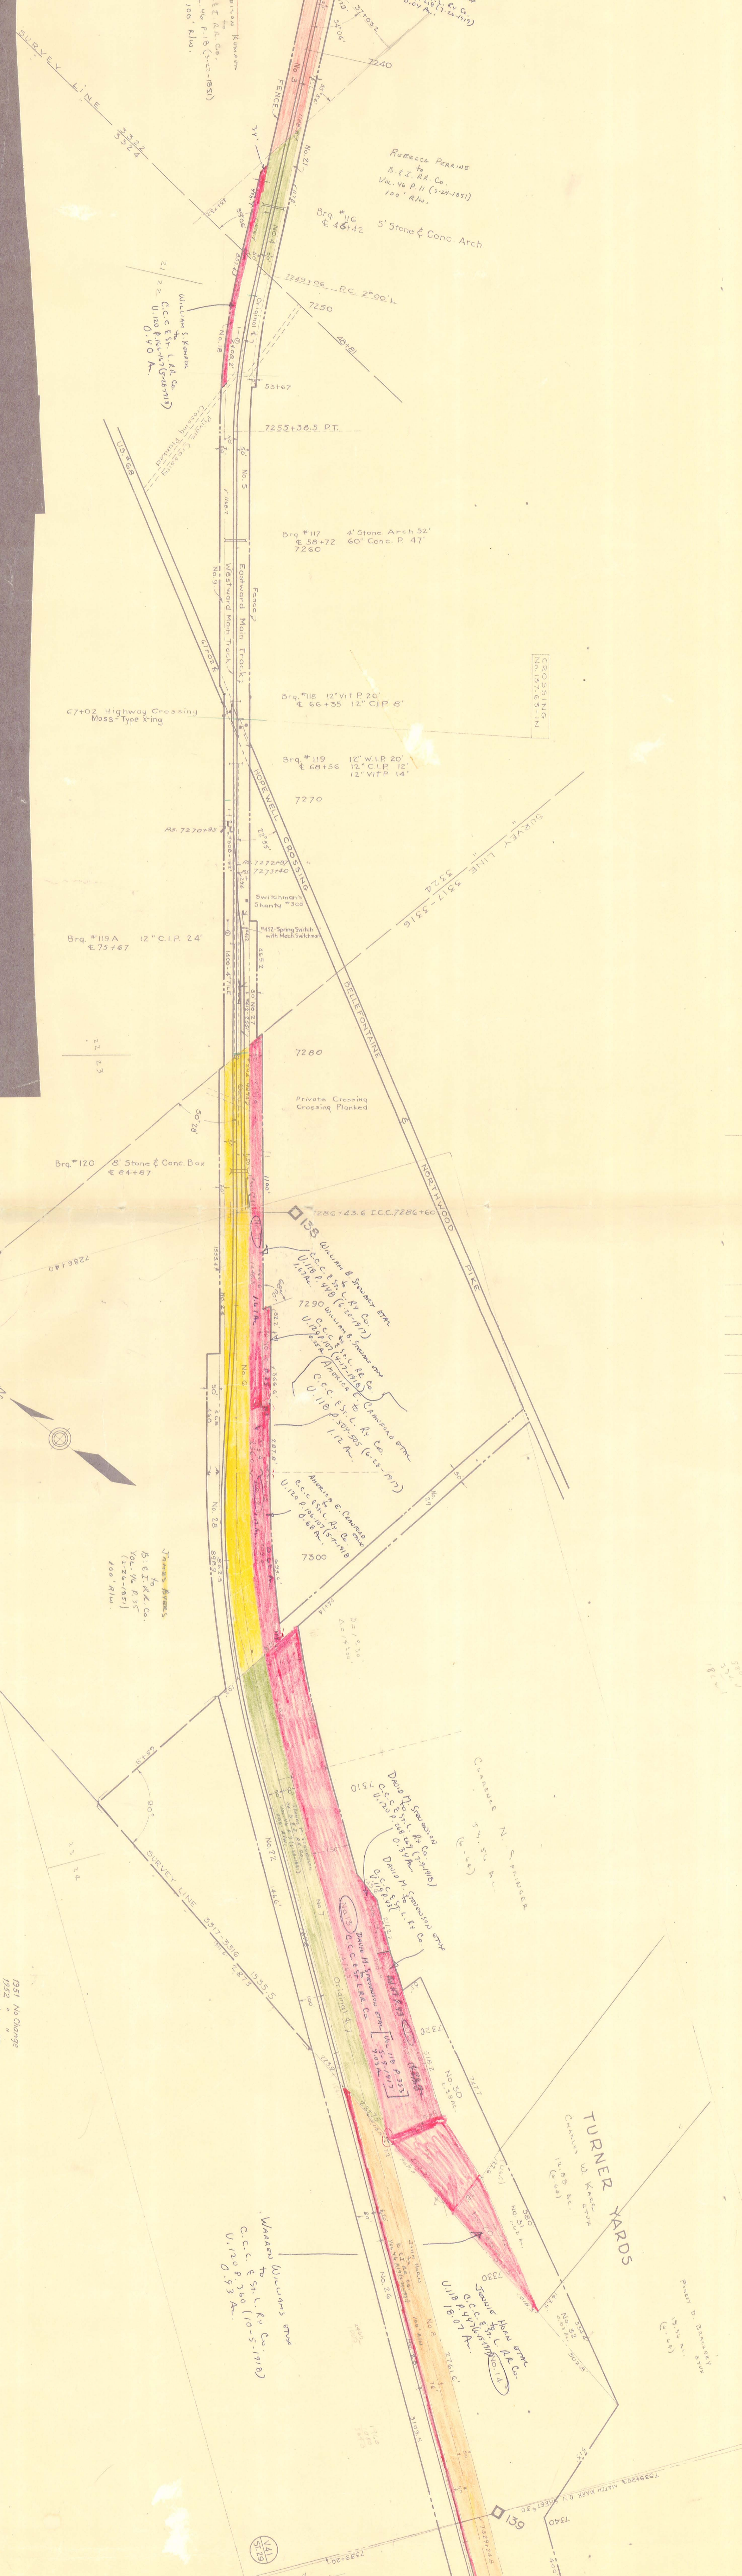


- See N.E. Sheet 28
- 1 - 51.50a
- 1 - 51.50b
- 1 - 51.50c
1951 No Change  
 1952 " "  
 1953 1-2-57  
 1954 No Change  
 1955 4-3-58  
 1956 No Change  
 1957 " "  
 1958 " "

CORRECTED TO DECEMBER 31, 1950.  
 Sheet No. 28, of A.C. & S.L.R. Co.,  
 From Survey Station 7233160  
 Valuation Engineer

**RIGHT-OF-WAY AND TRACK MAP**  
 CLEVELAND, CINCINNATI, CHICAGO & ST. LOUIS RY.  
 OPERATED BY  
**THE CLEVELAND, CINCINNATI, CHICAGO & ST. LOUIS RY. CO.**  
 INDIANAPOLIS DIVISION - MAIN LINE  
 STA. 7233160 TO STA. 7339120  
 SCALE 1 IN. = 200 FT. JUNE 30TH, 1915  
 Office of Valuation Engineer, Cincinnati, O.



Match Mark for Sheet #29.



BELLEFONTAINE, O.

1921, No Change  
 1923 " "  
 1924 " "  
 1925 " "  
 1926 " "  
 1927 " "  
 1928 " "  
 1929 " "


CONNECTED TO DECEMBER, 1919.  

Sheet No. 30 of V-41  
 From Survey Station 7339+20 to Sta. 7444+80  
 THE CLEVELAND, CINCINNATI, CHICAGO & ST. LOUIS RY. CO.  
 THE CLEVELAND, CINCINNATI, CHICAGO & ST. LOUIS DIVISION - MAIN LINE  
 INDIANAPOLIS  
 Scale 1 in. = 200 ft.  
 June 30th, 1916  
 Office of Assistant Engineer, Cincinnati, O.

V-41  
 30

Match Mark for Sheet #29

ROSLING  
NO. 13923-IN

 


**STATION MAP—TRACKS AND STRUCTURES**

THE CLEVELAND, CINCINNATI, CINCINNATI & ST. LOUIS RR.  
 THE CLEVELAND, CINCINNATI, CINCINNATI & ST. LOUIS RR. CO.

INDIANAPOLIS DIVISION—MAIN LINE  
 Office of Valuation Engineer, Cincinnati, O.


1951 4-27-53  
 1952 8-9-53  
 1953 5-5-53  
 1954 5-5-53  
 1955 No Change  
 1956 11-10-58  
 1957 No Change  
 1958 No Change

CONNECTED TO DEPARTMENT  
 CONDUCTED TO DEPARTMENT

V-41  
 1350

RACHEL S. JOSELYN ET AL.  
 C.C.C. & S.P. CO.  
 U.S. 94, P. 107 (3-22-1908)  
 15' E/W - CORNER OF  
 LAY 112 & 113

NOTE:  
 For All Street Water and Sewer Connections  
 See Plans P. 16-36, 37, 38,1000

 



STATION MAP - TRACKS AND STRUCTURES  
 THE CLEVELAND, CINCINNATI, CHICAGO & ST. LOUIS RR  
 THE CLEVELAND, CINCINNATI, CHICAGO & ST. LOUIS RR CO.  
 INDIANAPOLIS DIVISION - MAIN LINE  
 Scale: 1 inch = 100 feet  
 Date: June 20th, 1915  
 Office of Mechanical Engineers, Cincinnati, O.

1951 4-27-53  
 1952 9-3-55  
 1953 1-2-57  
 1954 5-2-57  
 1955 11-5-58  
 1957 2-4-60  
 1958 9-24-60  
 1959 11-19-60

