WARTHMAN PROPERTY
V. M. S. 6154
BOKES CREEK TOWNSHIP
LOGAN COUNTY, OHIO
MARCH, 1970
SCALE 1" = 200'

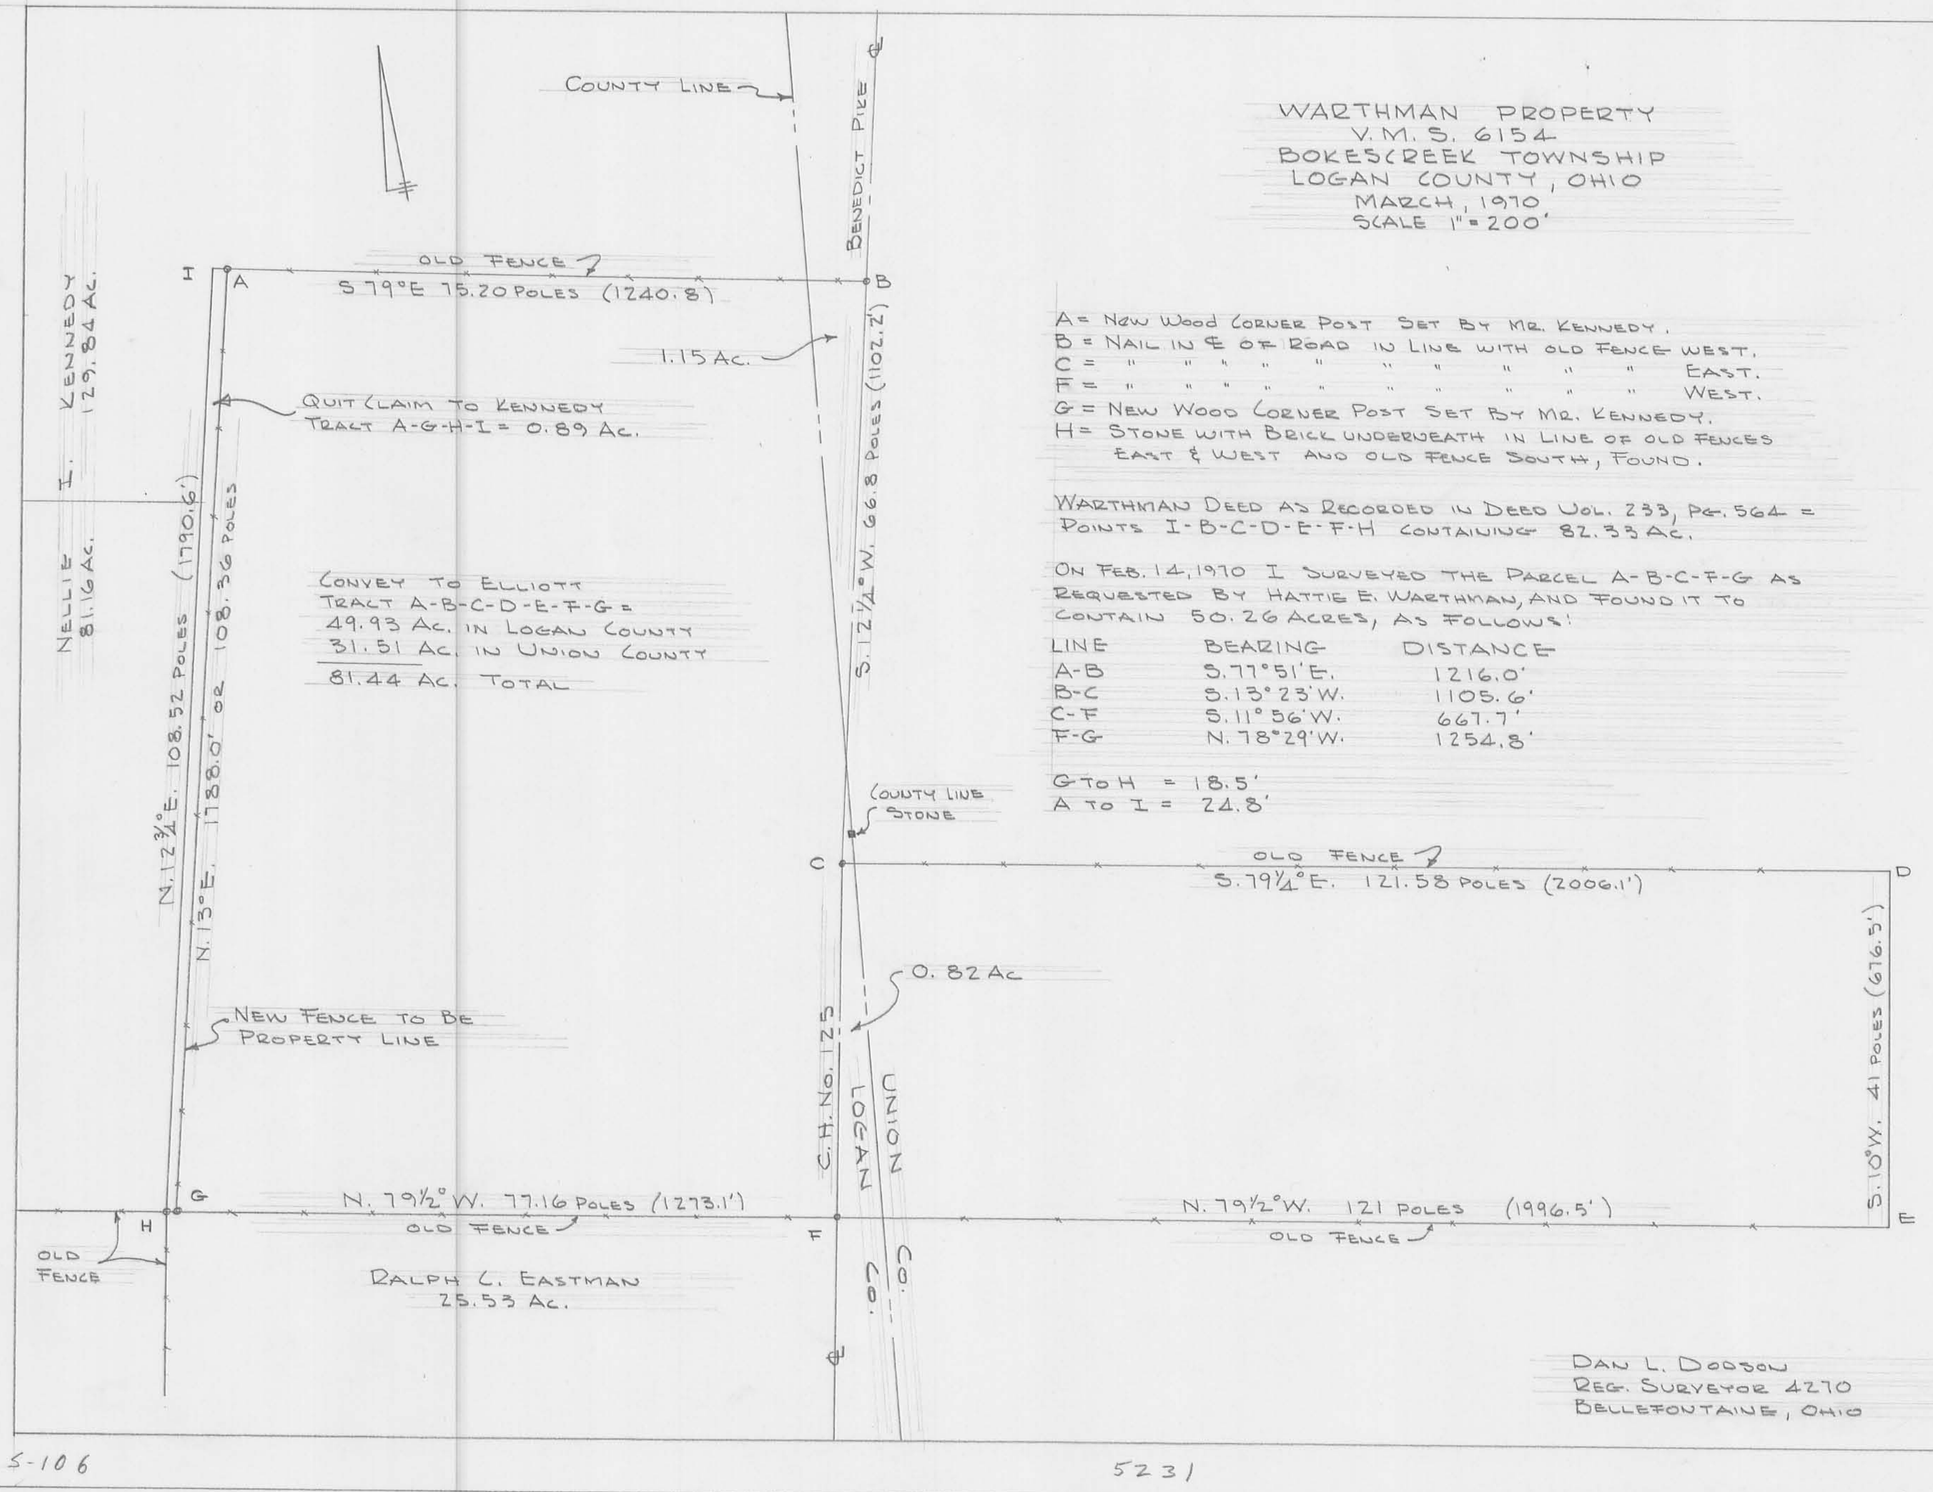

A = New Wood Corner Post Set By Mr. Kennedy.
B = Nail in ℄ of Road in Line with old fence West.
C = " " " " " " " " " " East.
F = " " " " " " " " " " West.
G = New Wood Corner Post Set By Mr. Kennedy.
H = Stone with Brick underneath in Line of old fences East & West and old fence South, Found.

Warthman Deed as Recorded in Deed Vol. 233, Pg. 564 = Points I-B-C-D-E-F-H containing 82.33 Ac.

On Feb. 14, 1970 I Surveyed the Parcel A-B-C-F-G as Requested by Hattie E. Warthman, and found it to contain 50.26 Acres, as follows:

LINE	BEARING	DISTANCE
A-B	S. 77° 51' E.	1216.0'
B-C	S. 13° 23' W.	1105.6'
C-F	S. 11° 56' W.	667.7'
F-G	N. 78° 29' W.	1254.8'

G to H = 18.5'
A to I = 24.8'

Dan L. Dodson
Reg. Surveyor 4270
Bellefontaine, Ohio

S-106

5231

S-106