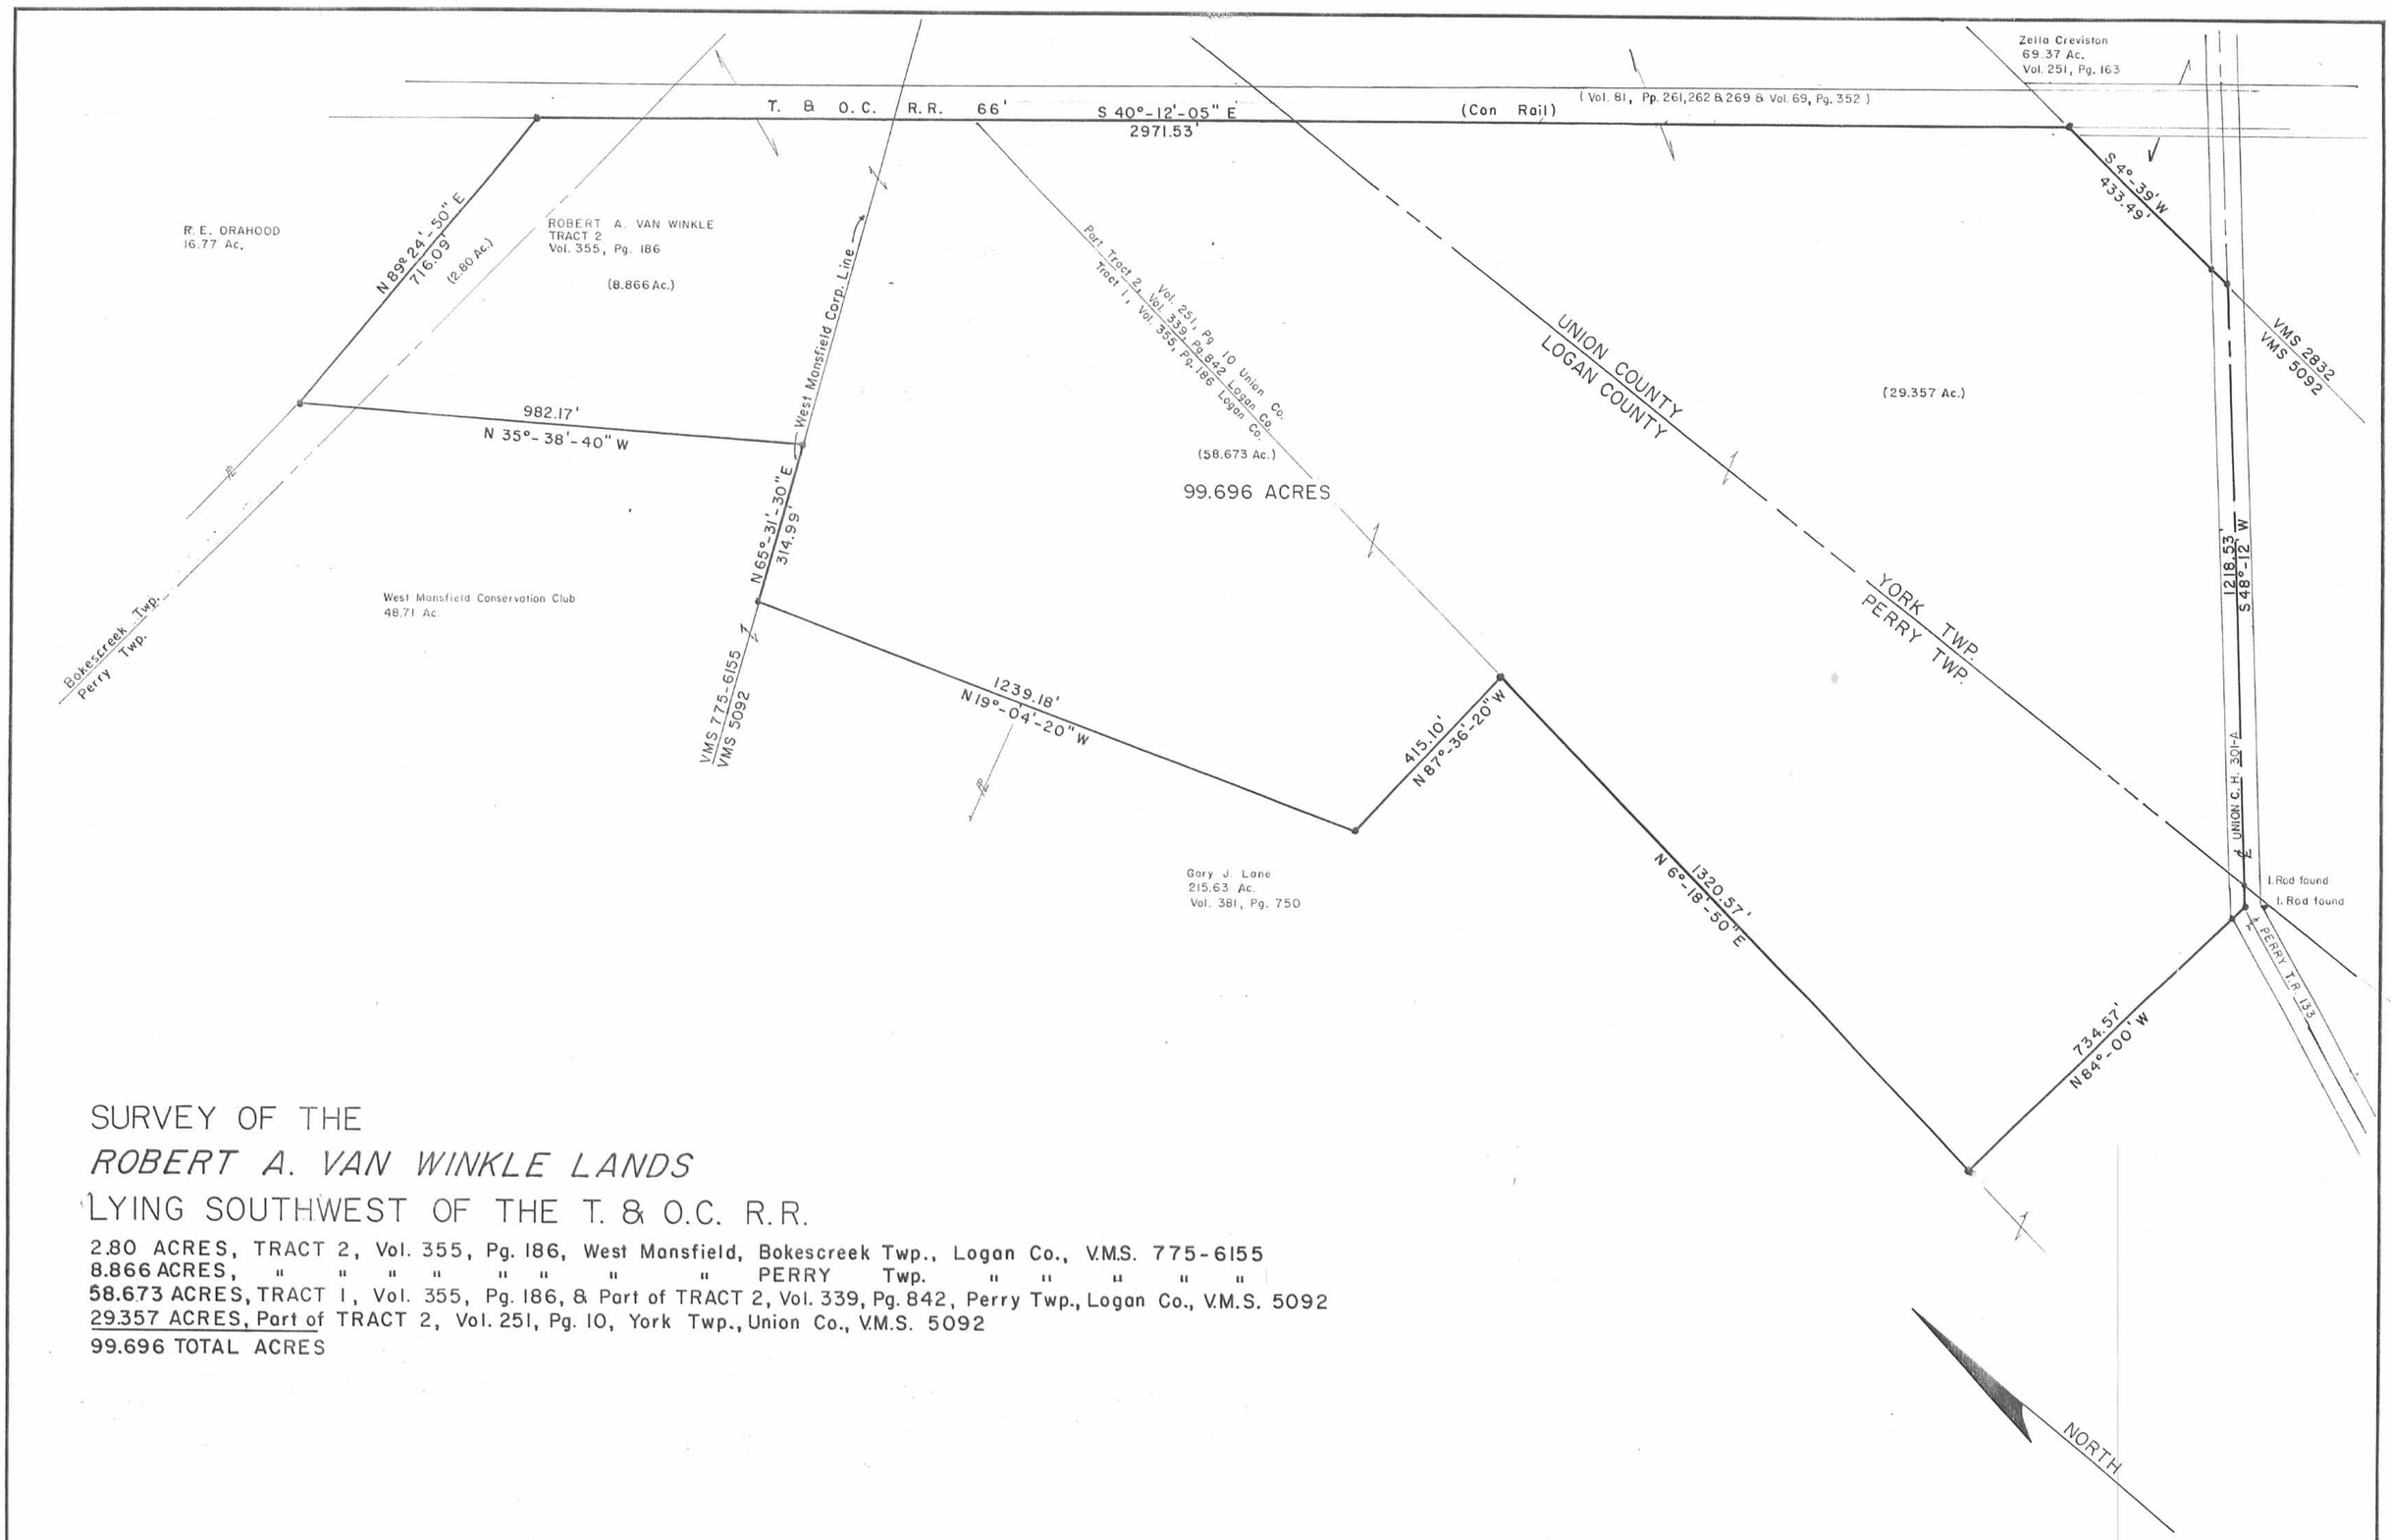

SURVEY OF THE

ROBERT A. VAN WINKLE LANDS

LYING SOUTHWEST OF THE T. & O.C. R.R.

2.80 ACRES, TRACT 2, Vol. 355, Pg. 186, West Mansfield, Bokescreek Twp., Logan Co., V.M.S. 775-6155
8.866 ACRES, " " " " " " " " PERRY Twp. " " " " "
58.673 ACRES, TRACT 1, Vol. 355, Pg. 186, & Part of TRACT 2, Vol. 339, Pg. 842, Perry Twp., Logan Co., V.M.S. 5092
29.357 ACRES, Part of TRACT 2, Vol. 251, Pg. 10, York Twp., Union Co., V.M.S. 5092
99.696 TOTAL ACRES

• Indicates Iron Rod set

STATE OF OHIO
JEFFREY I. LEE 6359
REGISTERED SURVEYOR

SURVEYED BY:
Jeffrey I. Lee
Jeffrey I. Lee
Reg. Surveyor 6359

LEE SURVEYING & MAPPING CO.
855 E. Sandusky Ave.
BELLEFONTAINE, OHIO 43311
(513) 593-5780

SCALE: 1" = 200'	APPROVED BY	DRAWN BY j.i.l.
DATE: Dec. 20, 1979		
		DRAWING NUMBER L 667-2

NO. 185A-18X24

S-267

S-267