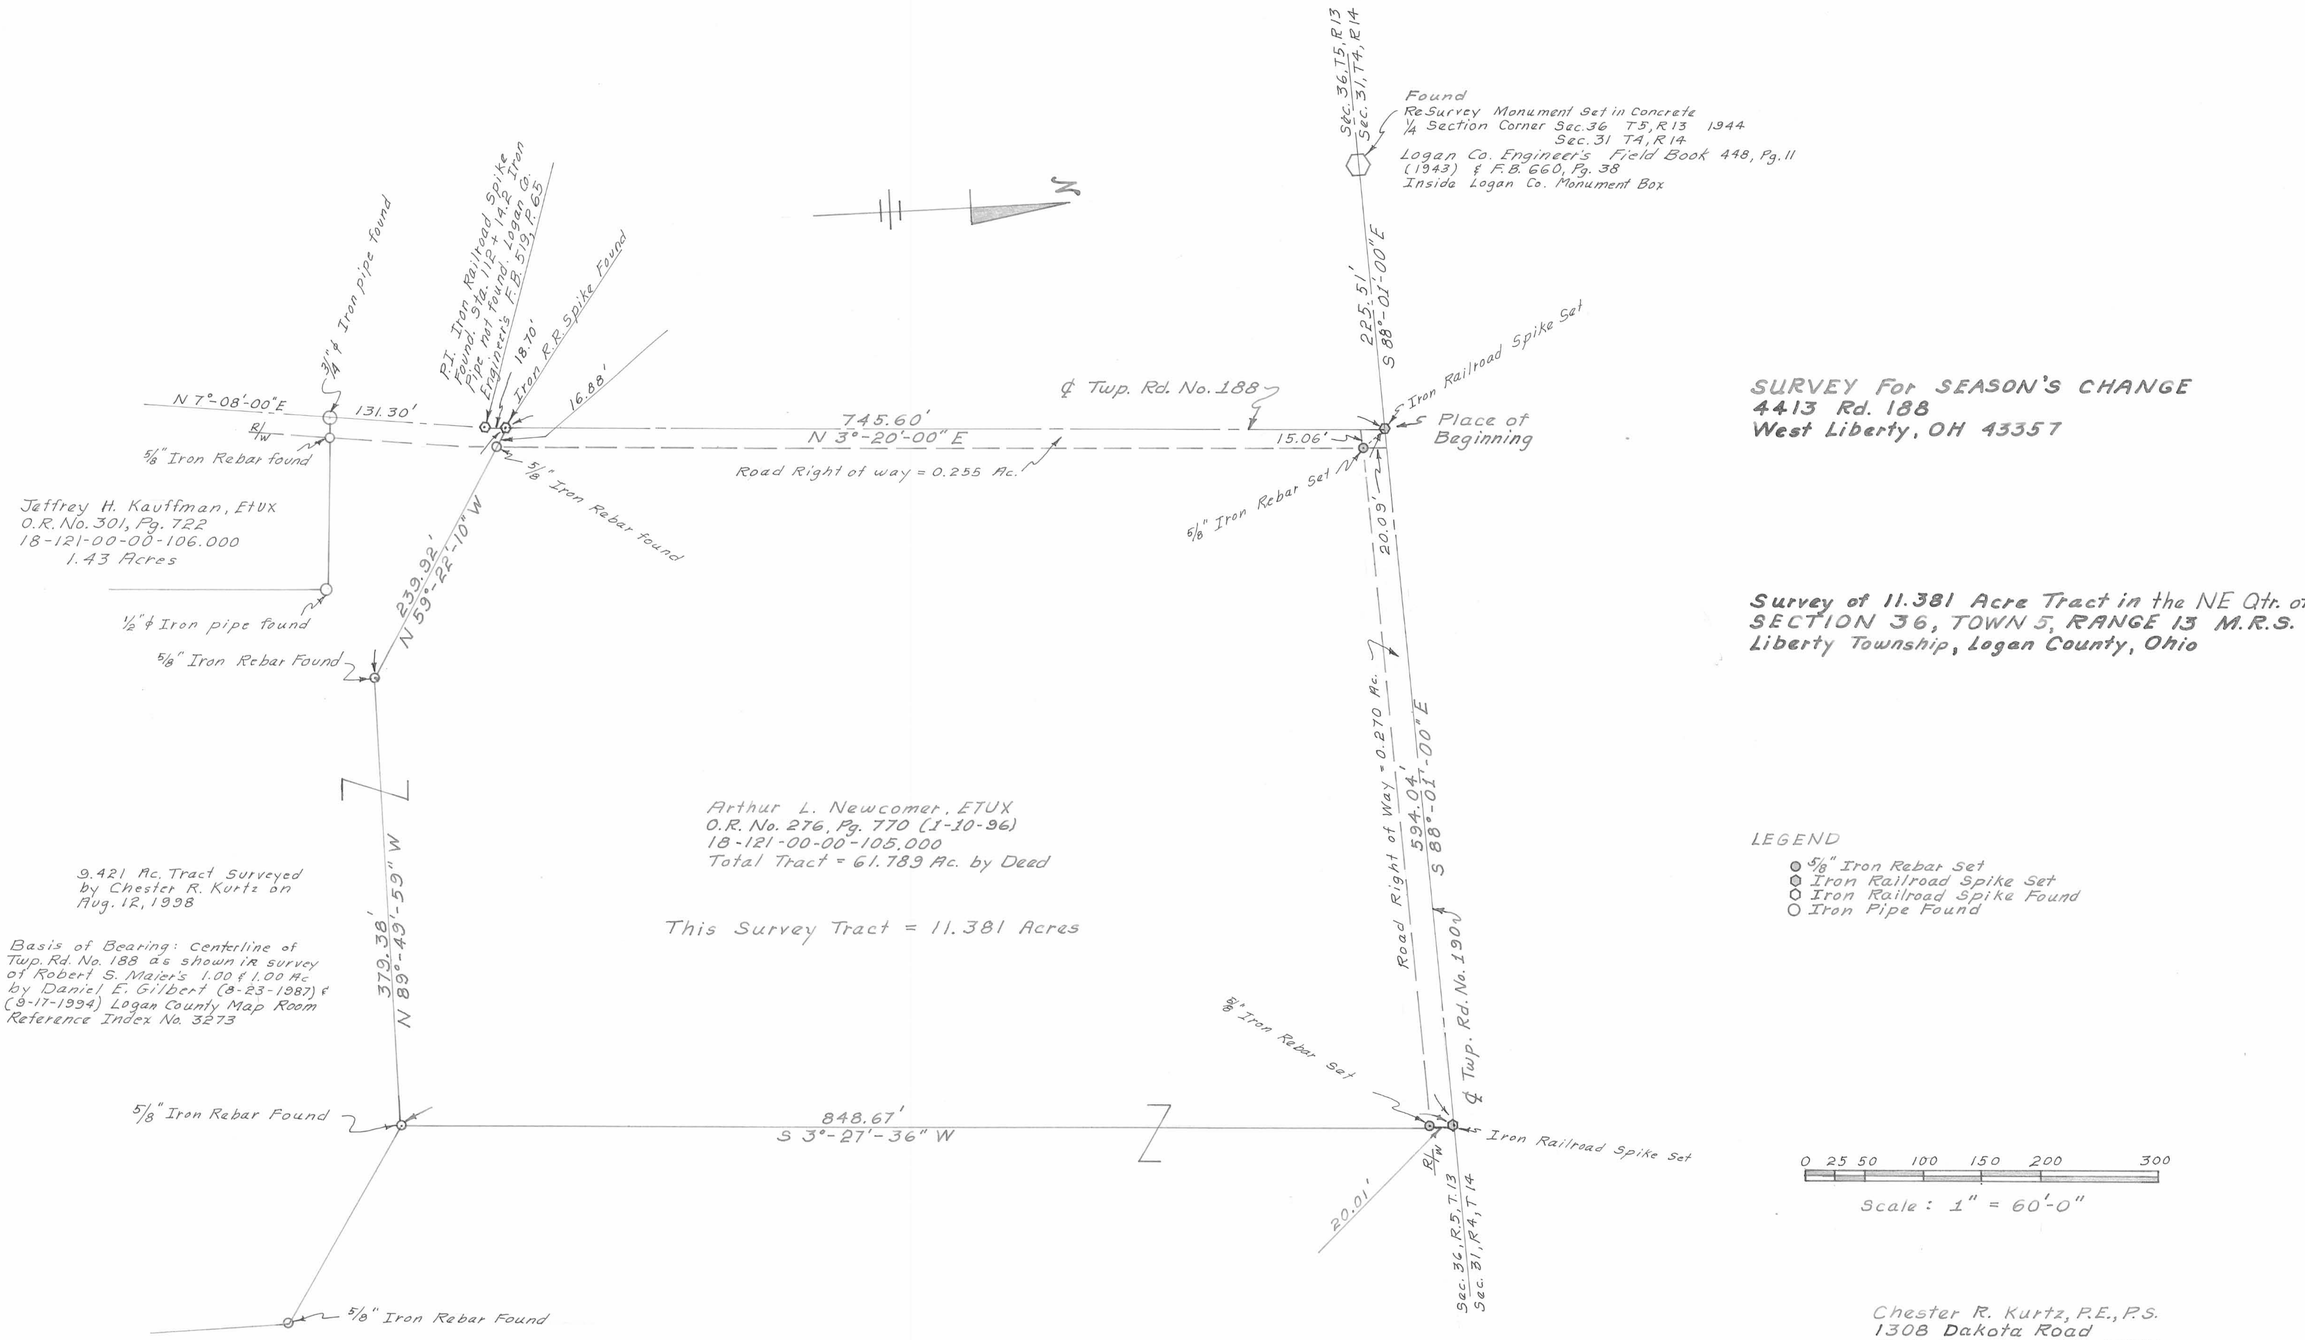

SURVEY For SEASON'S CHANGE
4413 Rd. 188
West Liberty, OH 43357

Survey of 11.381 Acre Tract in the NE Qtr. of SECTION 36, TOWN 5, RANGE 13 M.R.S.
Liberty Township, Logan County, Ohio

LEGEND

- 5/8" Iron Rebar Set
- Iron Railroad Spike Set
- Iron Railroad Spike Found
- Iron Pipe Found

0 25 50 100 150 200 300

Scale: 1" = 60'-0"

Chester R. Kurtz, P.E., P.S.
1308 Dakota Road
Bellefontaine, OH 43311
937-593-0167

Chester R. Kurtz

Chester R. Kurtz
Ohio Registration No. 4849
September 25, 1998

S-303

S-303