


VIRGINIA MILITARY SURVEY 3317  
LAKE TOWNSHIP  
LOGAN COUNTY, OHIO

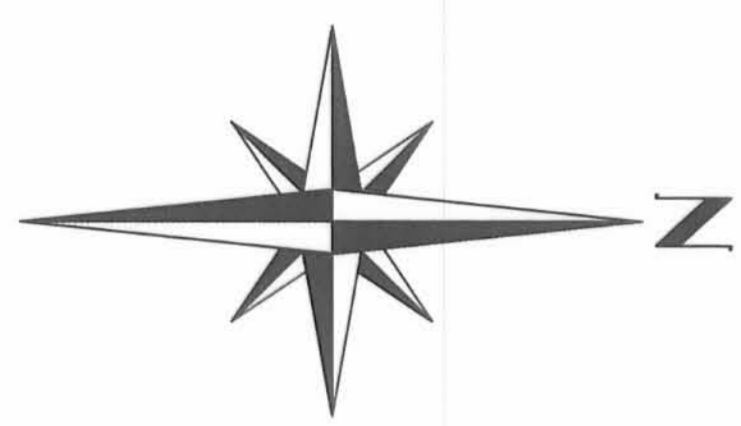

Nancy S. Hurley  
11.094 acres  
O.R. 550, pg. 612

Devinder and Damanjit Yakhmi  
Tract I, 98.212 acres  
Deed Volume 378, page 531

Devinder and Damanjit Yakhmi  
Tract II, 17.431 acres  
Deed Volume 378, page 531

1.958 Acres

2.203 Acres

2.443 Acres

NANCY S. HURLEY SURVEY

Being three tracts split out of Nancy S. Hurley's 11.094 acre tract described in Official Record 550, page 612.

I HEREBY CERTIFY THAT THIS PLAT WAS PREPARED FROM AN ACTUAL FIELD SURVEY AND THAT MONUMENTS WERE PLACED AS INDICATED HEREON.

*George A. Blackburn* 1-12-2003  
GEORGE A. BLACKBURN, R.S. 7873



COUNTY ROAD 9  
(VARIABLE RIGHT-OF-WAY WIDTH)

D=0°30'00"  
R=11459.16'  
L=523.67'  
T=261.88'  
Cd=523.62'  
Cb=N33°51'27"E  
Δ = 2°37'06"

CURVE C1  
D=0°30'00"  
R=11459.16'  
L=45.20'  
T=22.60'  
Cd=45.20'  
Cb=S35°03'13"W  
Δ=0°13'34"

- Magnetic nail set
- ⊗ 1 inch iron pin found
- 5/8 inch iron pin set
- ⊗ 5/8 inch iron pin found

REFERENCE:  
Highway Plan X-9c

SCALE IN FEET  
0 50 100

BLACKBURN SURVEYING

12125 GREEN STREET  
MIDDLEBURG, OHIO 43336  
(937) 666-5605

Filename: Hurley 12-02  
Scale: 1" = 50'  
Date: 1-12-2003  
F.B. 8, pg. 27

INDEXED ON MAP  
6427