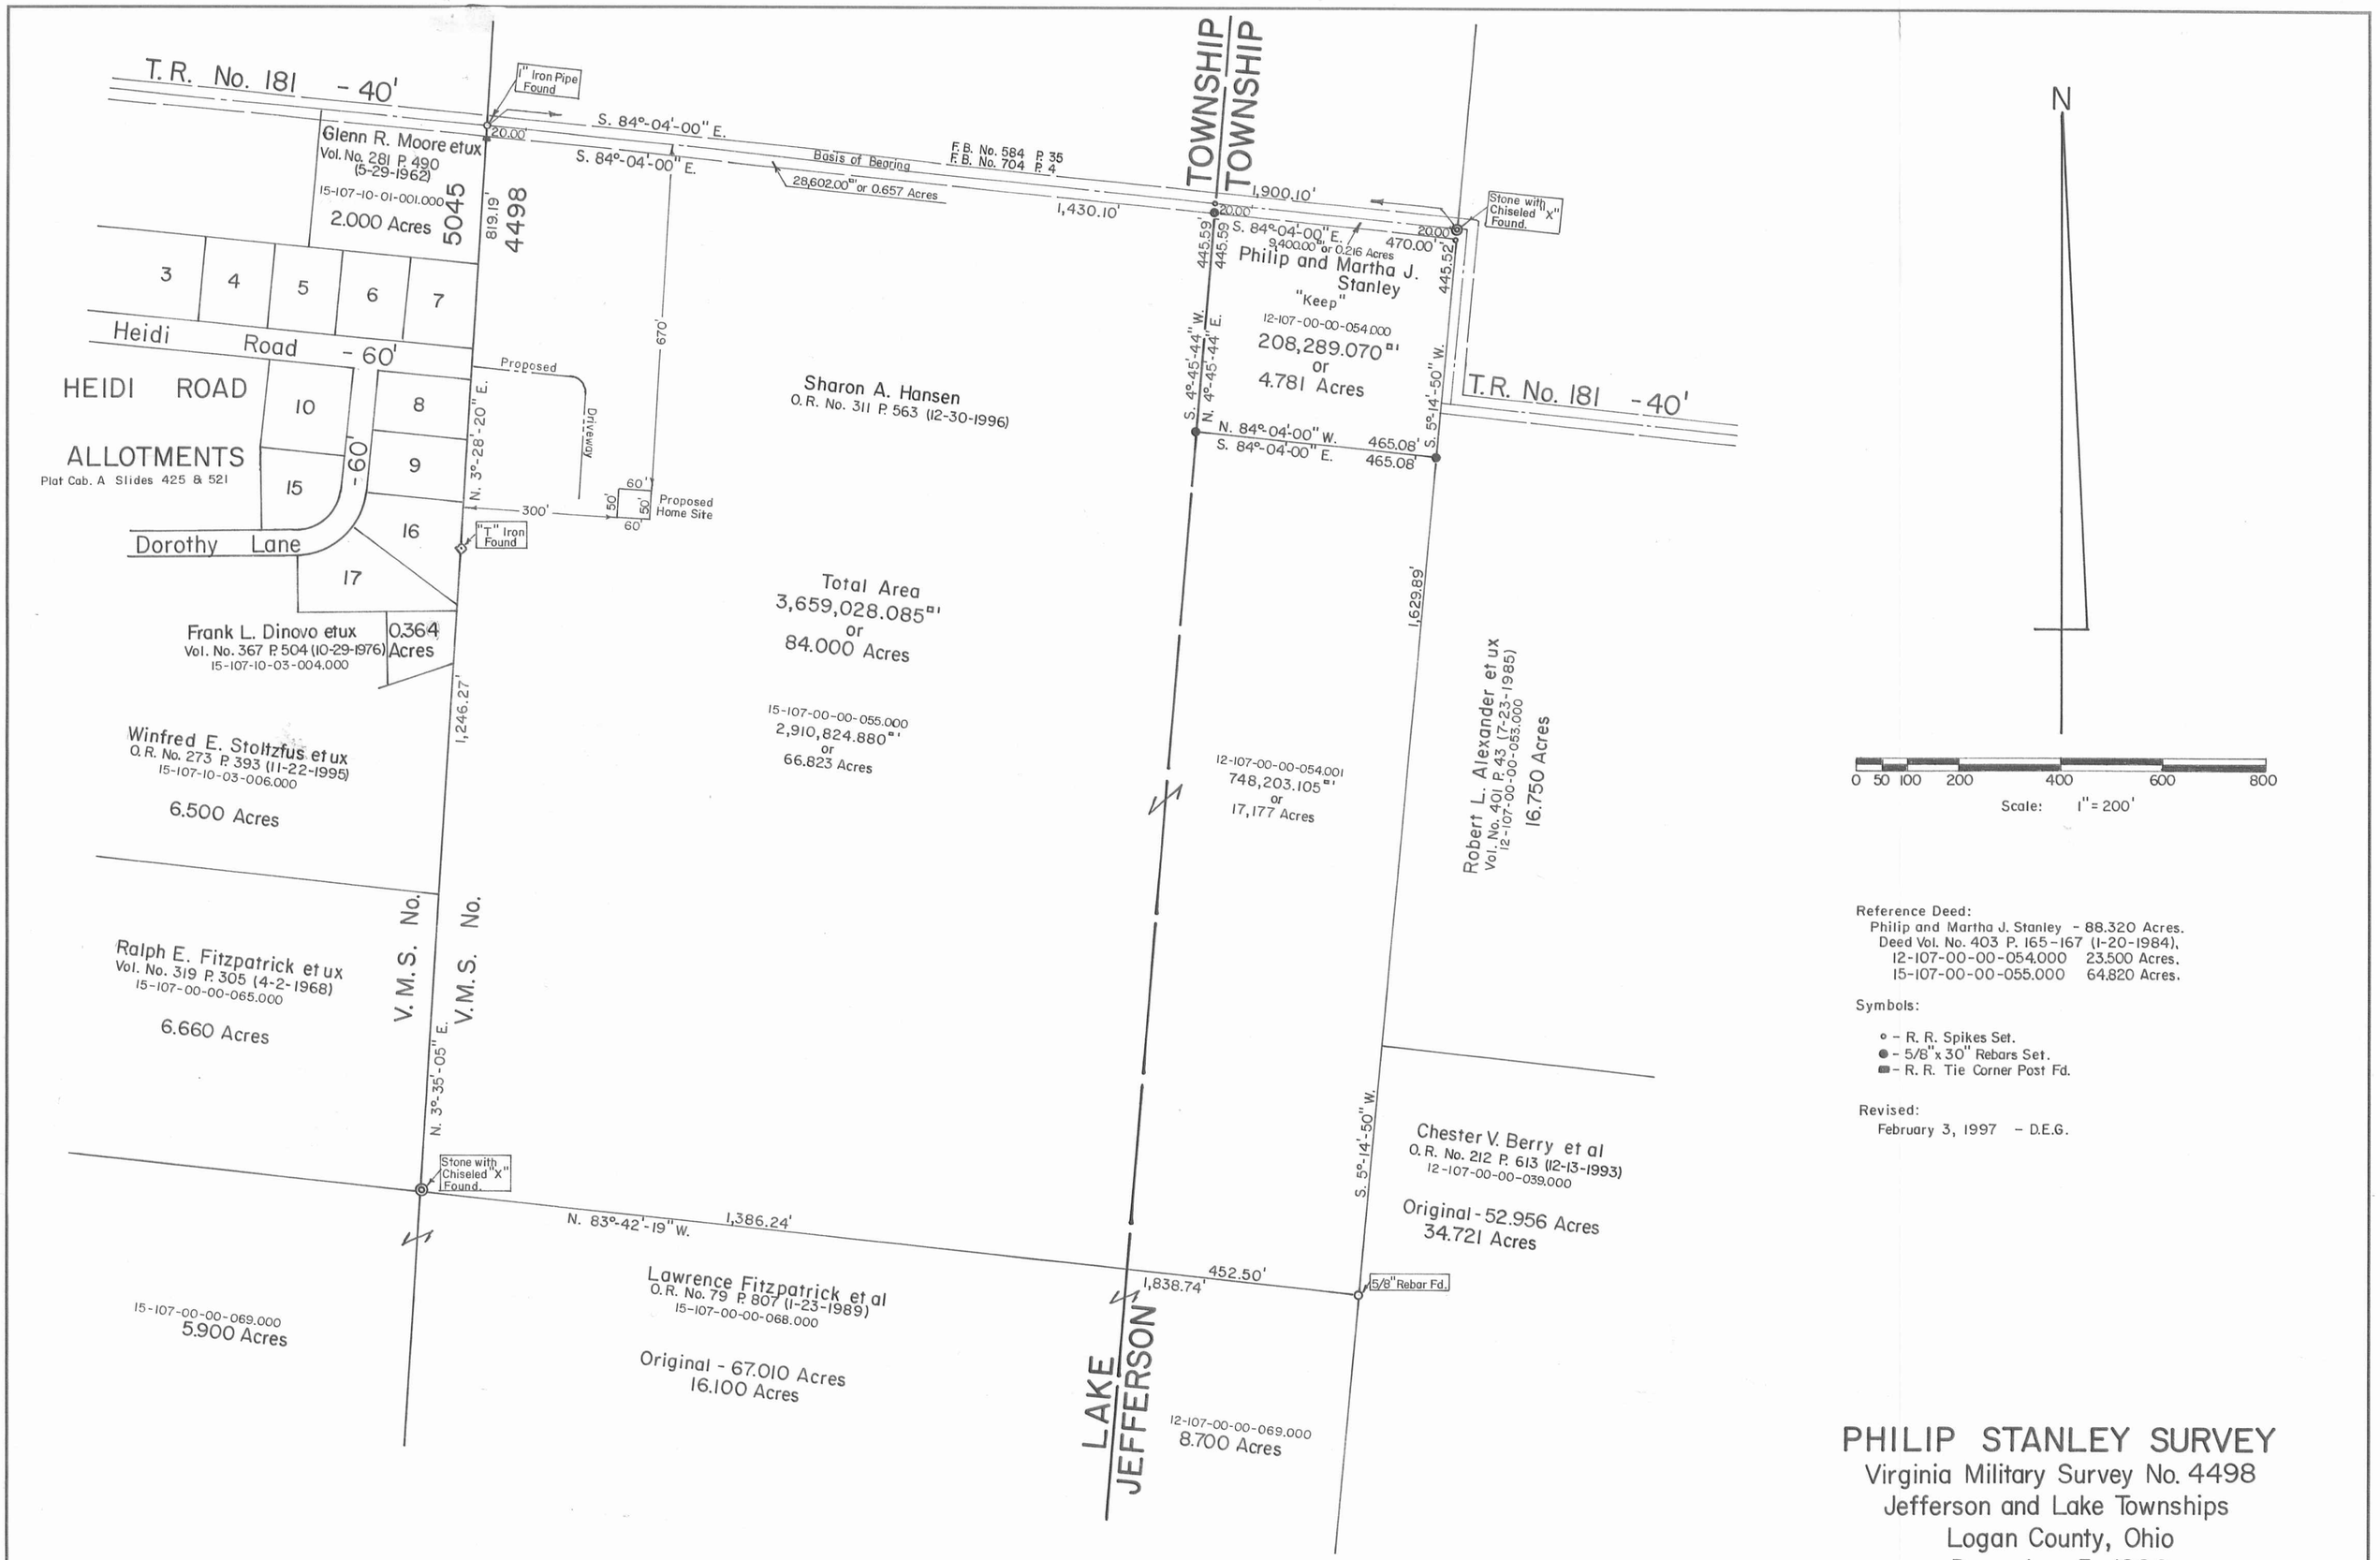

Reference Deed:
Philip and Martha J. Stanley - 88.320 Acres.
Deed Vol. No. 403 P. 165-167 (1-20-1984),
12-107-00-00-054.000 23.500 Acres.
15-107-00-00-055.000 64.820 Acres.

Symbols:

- ○ - R. R. Spikes Set.
- ● - 5/8" x 30" Rebars Set.
- ▬ - R. R. Tie Corner Post Fd.

Revised:
February 3, 1997 - D.E.G.

PHILIP STANLEY SURVEY

Virginia Military Survey No. 4498
Jefferson and Lake Townships
Logan County, Ohio
December 5, 1996

STATE OF OHIO
DANIEL E. GILBERT
5402
PROFESSIONAL SURVEYOR

Daniel E. Gilbert, P.S.
Reg. Sur. No. 5402
400 N. Park St.
Bellefontaine, Ohio 43311
(937) 593-1428

096-049

INDEXED ON MAP
6240

S-545