

Roberta Mae Graber
O.R. No. 56 P. 181 (1-18-1988)
19-135-00-00-037.000
35.19 Acres

Paul B. Harshbarger et al
O.R. No. 220 P. 737 (3-2-1994)
19-136-00-00-032.000
36.06 Acres

653,469.905^{sq}
or
15.002 Acres

647,020.215^{sq}
or
14.855 Acres

22.01 Acres

Jeffrey Vernon et al
O.R. No. 179 P. 926 (12-17-1992)
19-135-00-00-037.000



INDEXED ON MAP
5123

References:
Per. Par. No. 19-135-00-00-036.000
29.840 Acres.
Charles W. Sharp, Trust
O.R. No. 99 P. 448 (12-18-1989).
C.H. No. 5 - F.B. No. 509 P. 55.
T.R. No. 191- F.B. No. 552 P. 76.

Symbols:
● - R. R. Spikes Fd.
○ - R. R. Spike Set.
● - 5/8" Rebars Fd.
○ - 5/8 x 30 Rebars Set.

Charles W. Sharp Survey - Total Area 29.857 Acres
Section No. 29, T.5, R.13, B.M.R.S.
Liberty Township, Logan County, Ohio.

SCALE: 1" = 200'	APPROVED BY:	DRAWN BY DEG
DATE: 10-26-1994		REVISED 11-16-1994 DEG


Daniel E. Gilbert
Daniel E. Gilbert, P.S.
Reg. Sur. No. 5402

DRAWING NUMBER
094-060



Scale: 1" = 200'

N

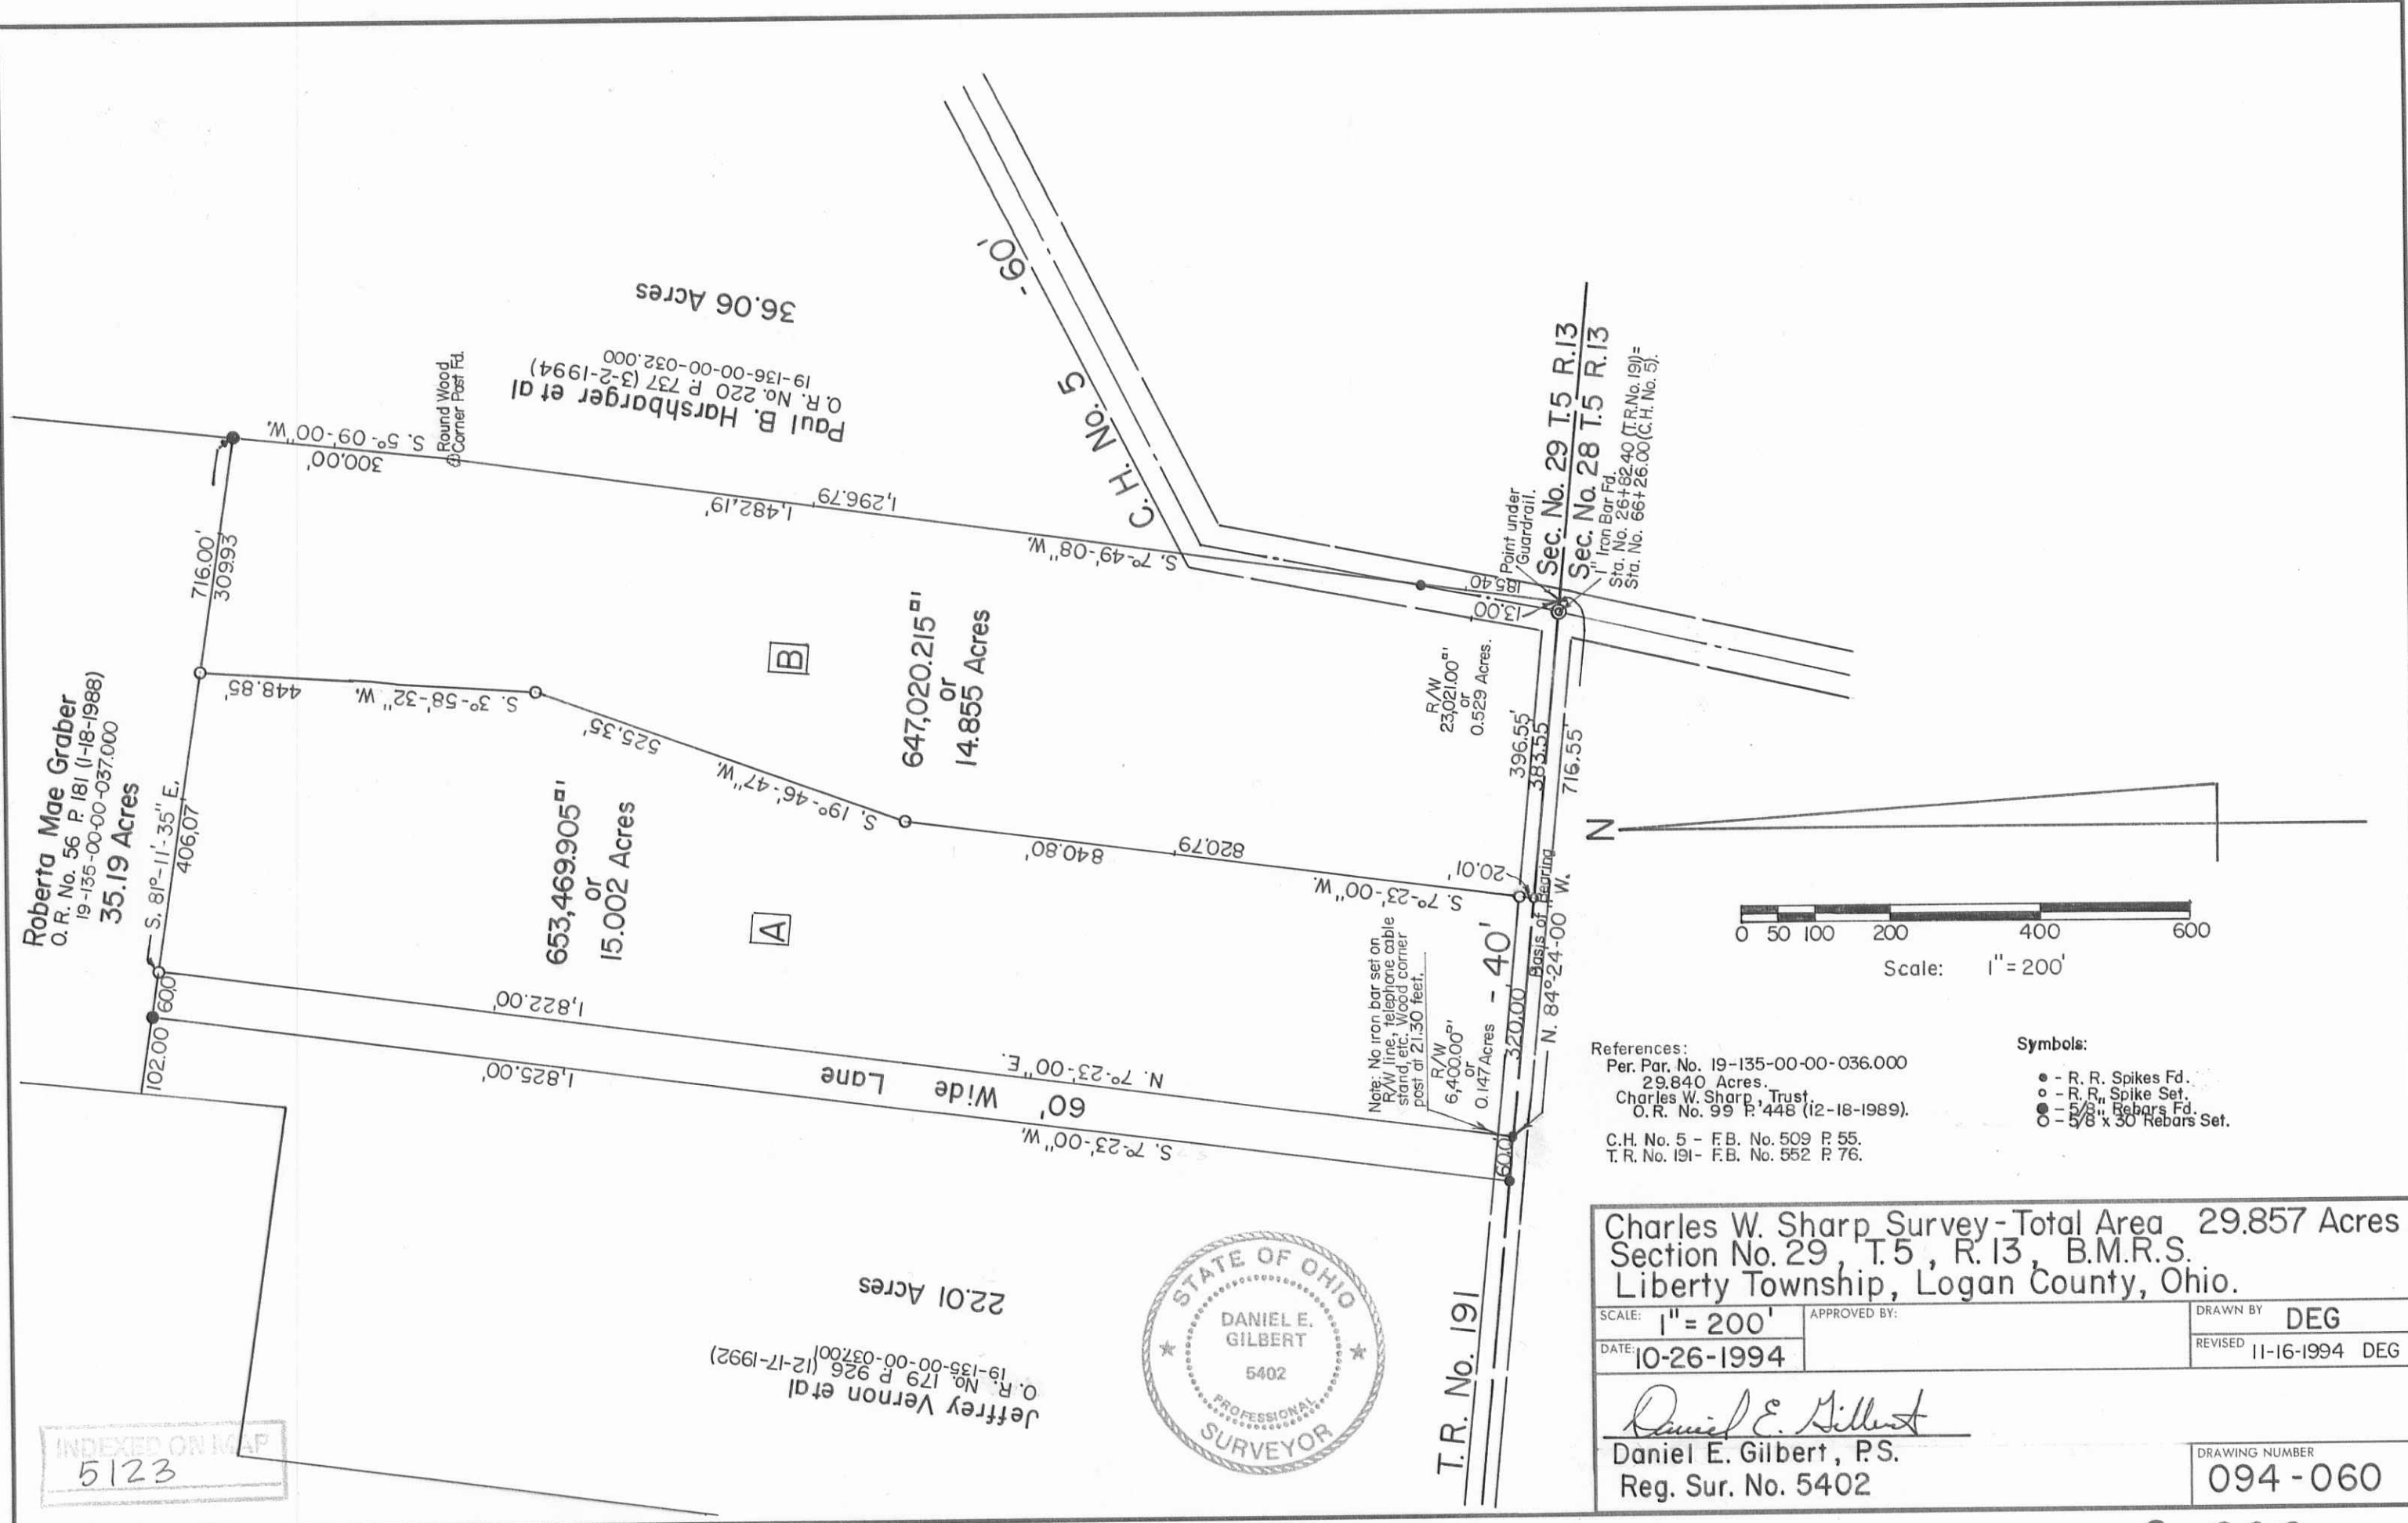

S-732