

Robert J. Milroy et ux  
O.R. No. 81 P. 164 (3-6-1989)  
23-035-00-00-028.000

99.248 Acres

Adin C. Miller et ux  
O.R. No. 82 P. 203 (3-11-1989)  
23-035-00-00-028.002

8.107 Acres

James R. Baier et ux  
O.R. No. 145 P. 767 (1-18-1992)  
23-034-00-00-035.001

14.164 Acres

Bennett to Gordon Tract  
103,554.275<sup>sq ft</sup> or 2.377 Acres

Total Area  
154,346.005<sup>sq ft</sup>  
or  
3.543 Acres

John P. Gordon  
Vol. 378 P. 745 (8-30-1978)  
23-034-00-00-034.000

(1.28 Acres)  
50,791.730<sup>sq ft</sup>  
or  
1.116 Acres

Gordon to Bennett Tract

Tract No. VII  
Total Area  
103,478.340<sup>sq ft</sup>  
or  
2.376 Acres

Tract No. VI  
Total Area  
102,013.540<sup>sq ft</sup>  
or  
2.342 Acres

Tract No. V  
236,070.195<sup>sq ft</sup>  
or  
5.419 Acres

POND  
AREA

Tract No. III  
185,507.635<sup>sq ft</sup>  
or  
4.259 Acres


POND  
AREA

Charles A. Bennett et al  
O.R. No. 134 P. 912 (8-23-1991)  
23-034-00-00-035.000

116.260 Acres

Reserved  
94,755.455<sup>sq ft</sup>  
or  
2.175 Acres

Tract No. IV  
131,423.175<sup>sq ft</sup>  
or  
3.017 Acres

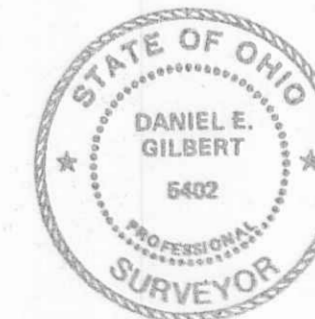

- SYMBOLS:
- - R. R. Spikes Fd.
  - - R. R. Spikes Set.
  - ✕ - 5/8" Rebars Fd.
  - ✕ - 5/8" x 30" Rebars Set.
  - - Concrete Corner Posts Fd.


BENNETT SURVEYS, V.M.S. No. 9929  
McArthur Township, Logan County, Ohio.

SCALE: 1" = 100' APPROVED BY: DRAWN BY: DEG  
DATE: 5-18-1992

Daniel E. Gilbert  
Daniel E. Gilbert, P.S.  
Reg. Sur. No. 5402

DRAWING NUMBER  
092-009

S-746

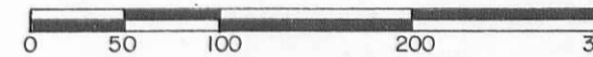

Scale: 1" = 100'



INDEXED ON MAP  
2041

Tracts No. III & IV Revised 11-30-1992 DEG.  
Tracts No. III & V Revised 12-18-1992 DEG.