


SEE SHEET 4

MATCH LINE

MATCH LINE

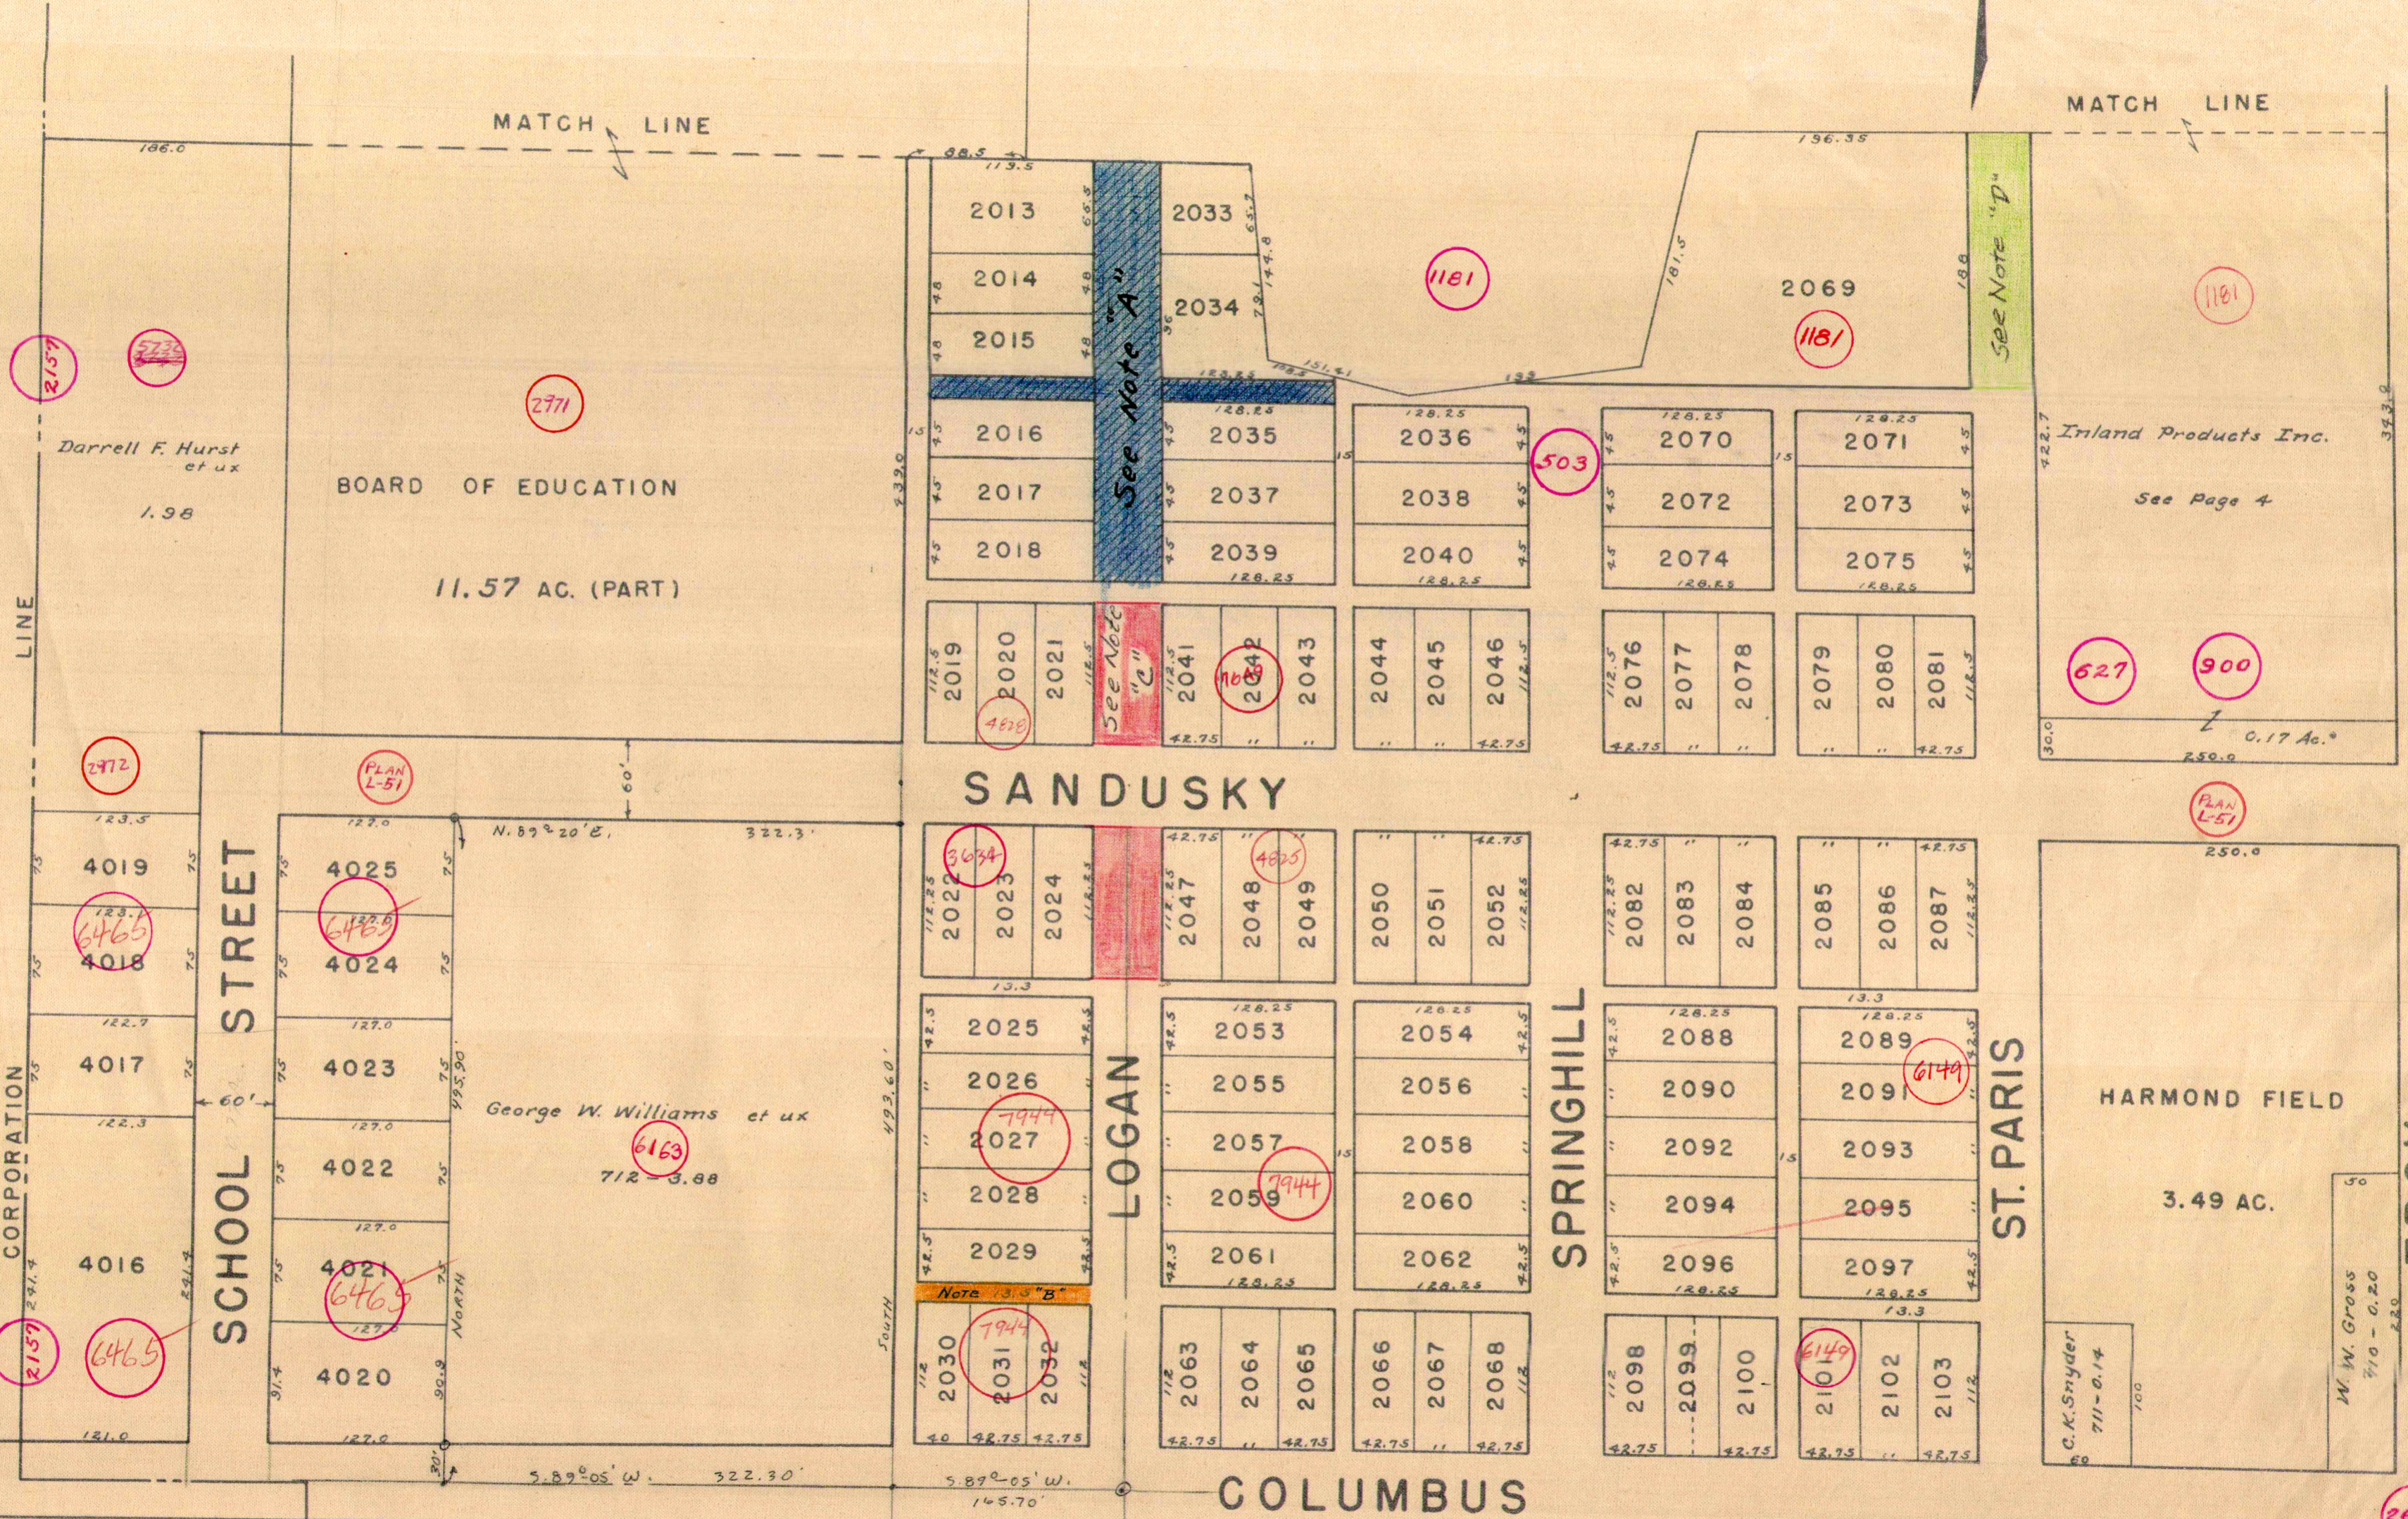

SHEET 8

SEE

TROY

SEE SHEET 2

DRAWN, NOVEMBER 27, 1956  
Corrected to Jan. 1-1957