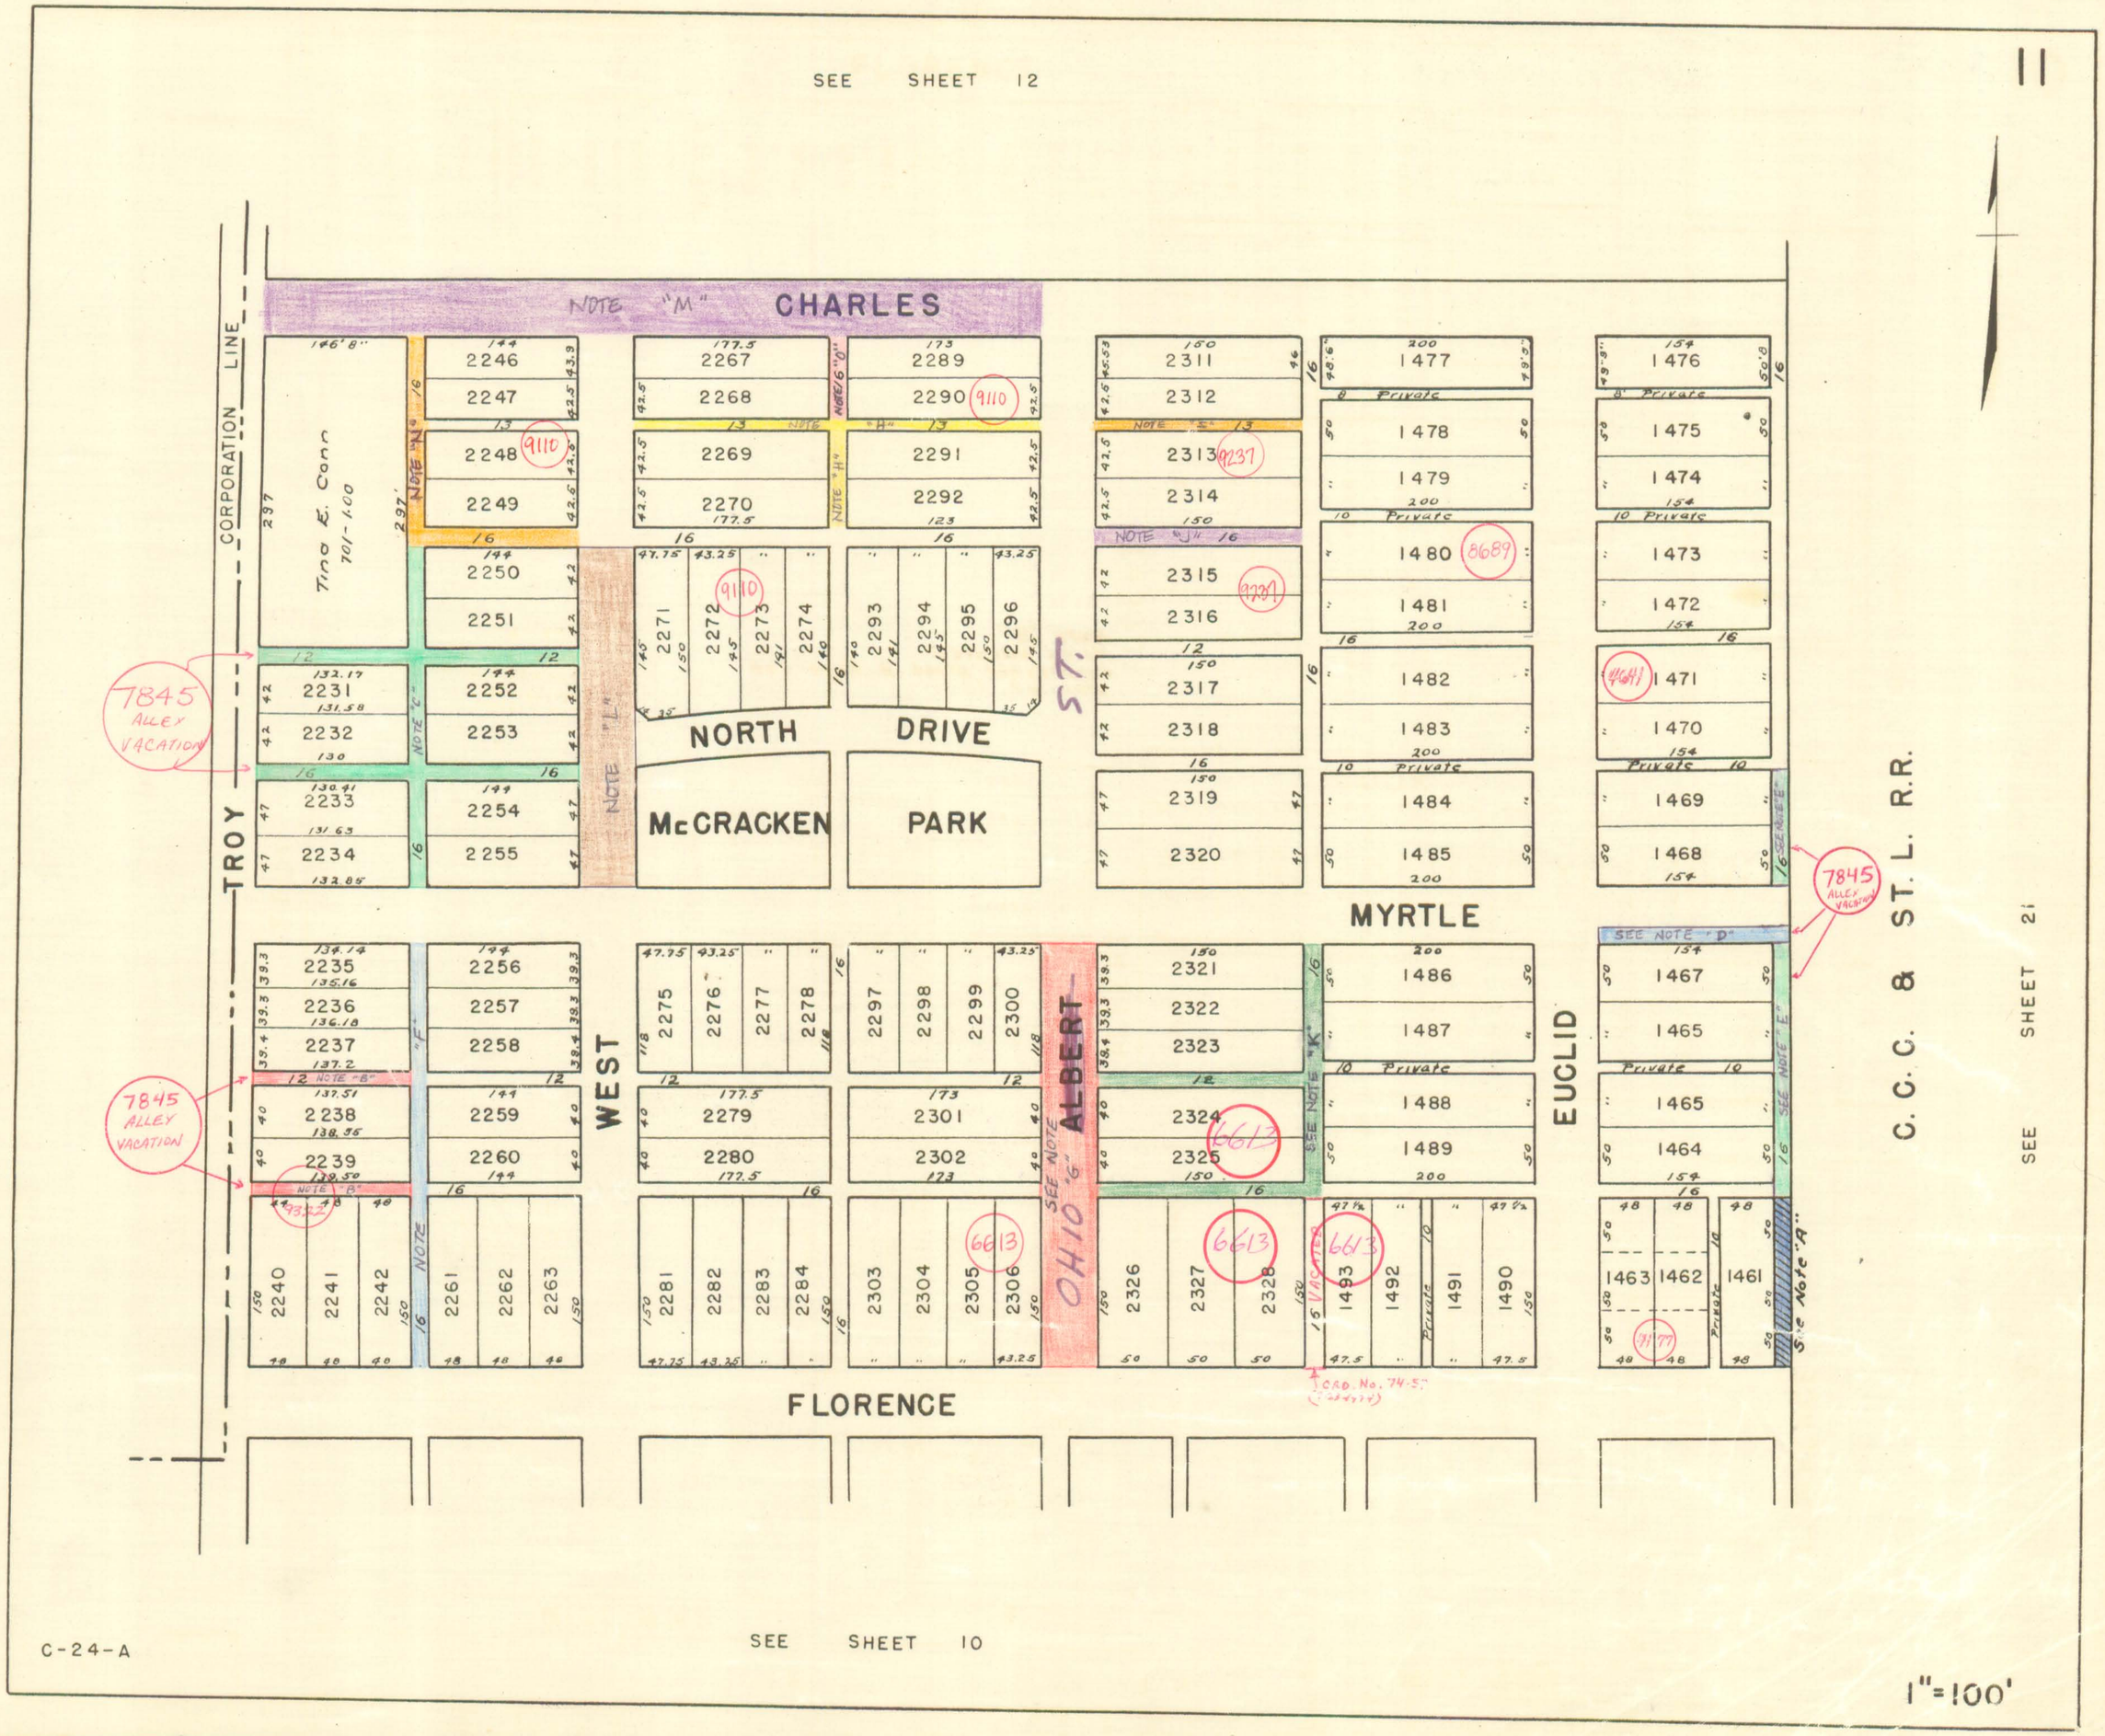
SEE SHEET 12
CHARLES
NOTE "M"
CORPORATION LINE
TROY
Tina E. Conn
701-1.00
NOTE "N"
NOTE "C"
NOTE "L"
NOTE "H"
NOTE "G"
NOTE "J"
NOTE "K"
NOTE "F"
NOTE "B"
NOTE "D"
NOTE "E"
NOTE "A"
NORTH DRIVE
McCRACKEN PARK
ST.
MYRTLE
WEST
ALBERT
EUCLID
FLORENCE
OHIO
C. C. C. & ST. L. R.R.
SEE SHEET 21
SEE SHEET 10
7845 ALLEY VACATION
9110
9237
8689
4641
6613
9322
9177
CRD. No. 74-5
1"=100'

C-24-A