


SEE PAGE 20

SEE PAGE 10

SEE PAGE 9

C-24-A

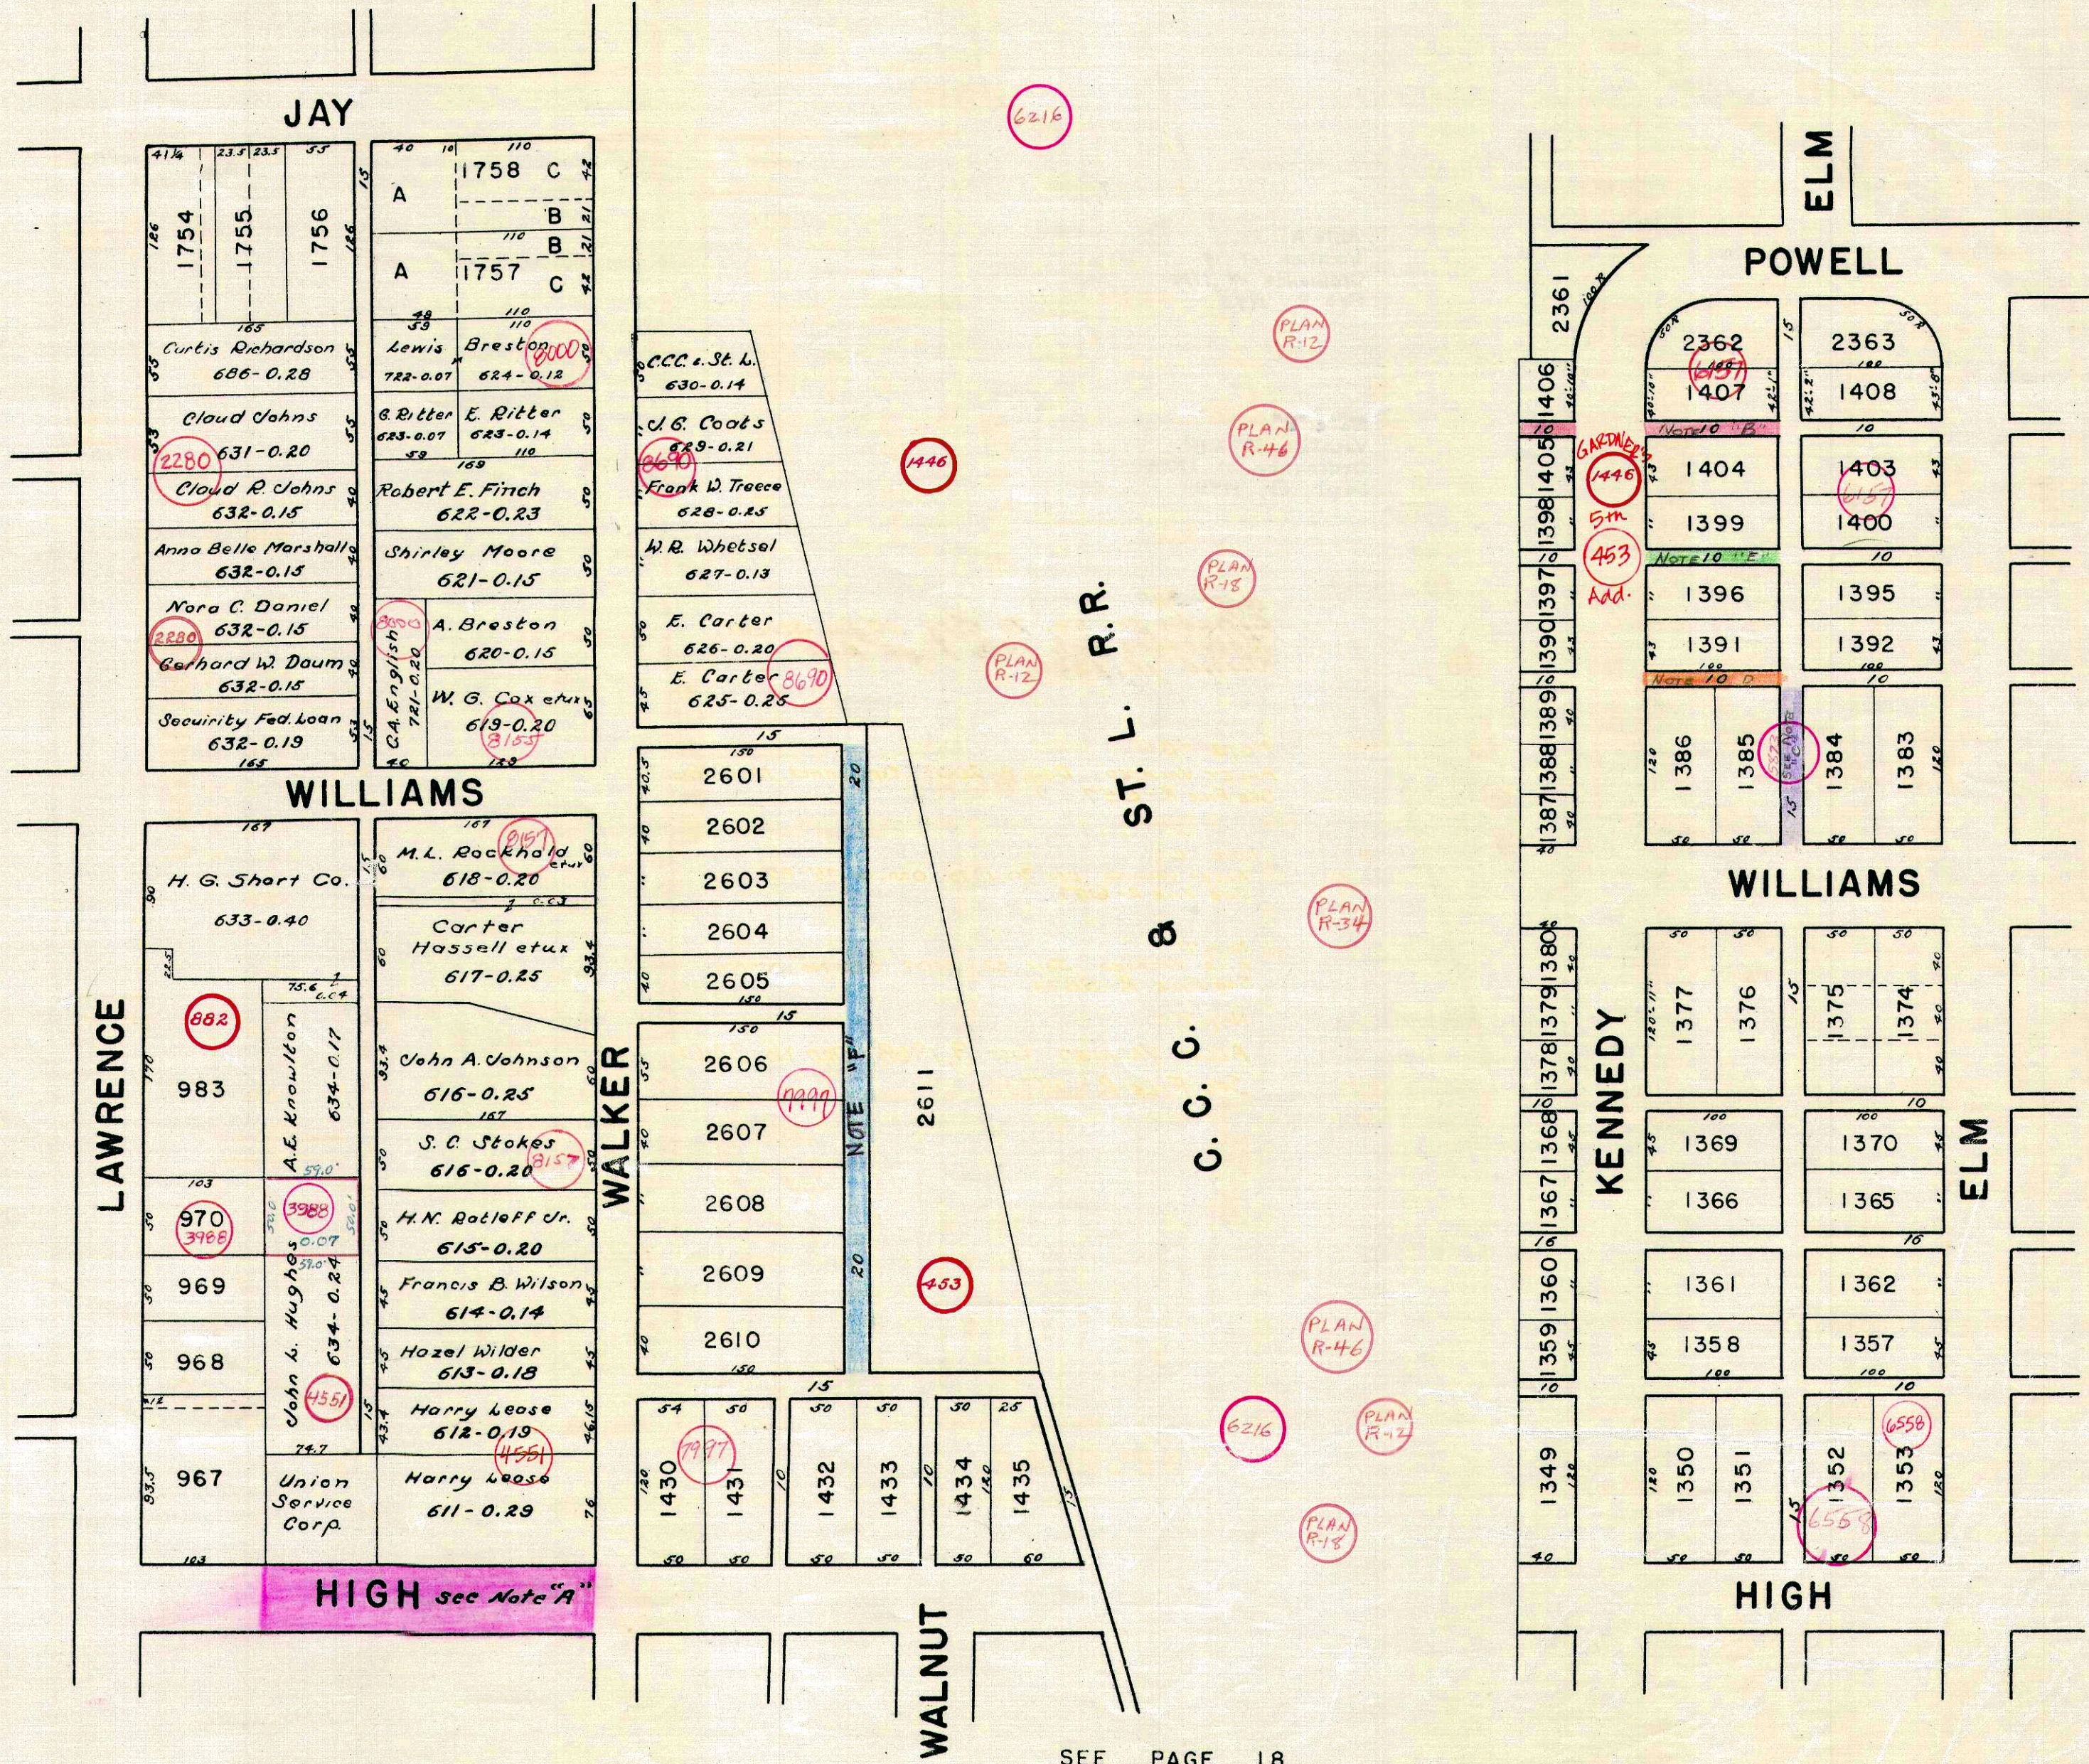

SEE PAGE 29

SEE PAGE 28

SEE PAGE 18

1" = 100'