


SEE PAGE 44

CORPORATION LINE

OLD CORPORATION LINE

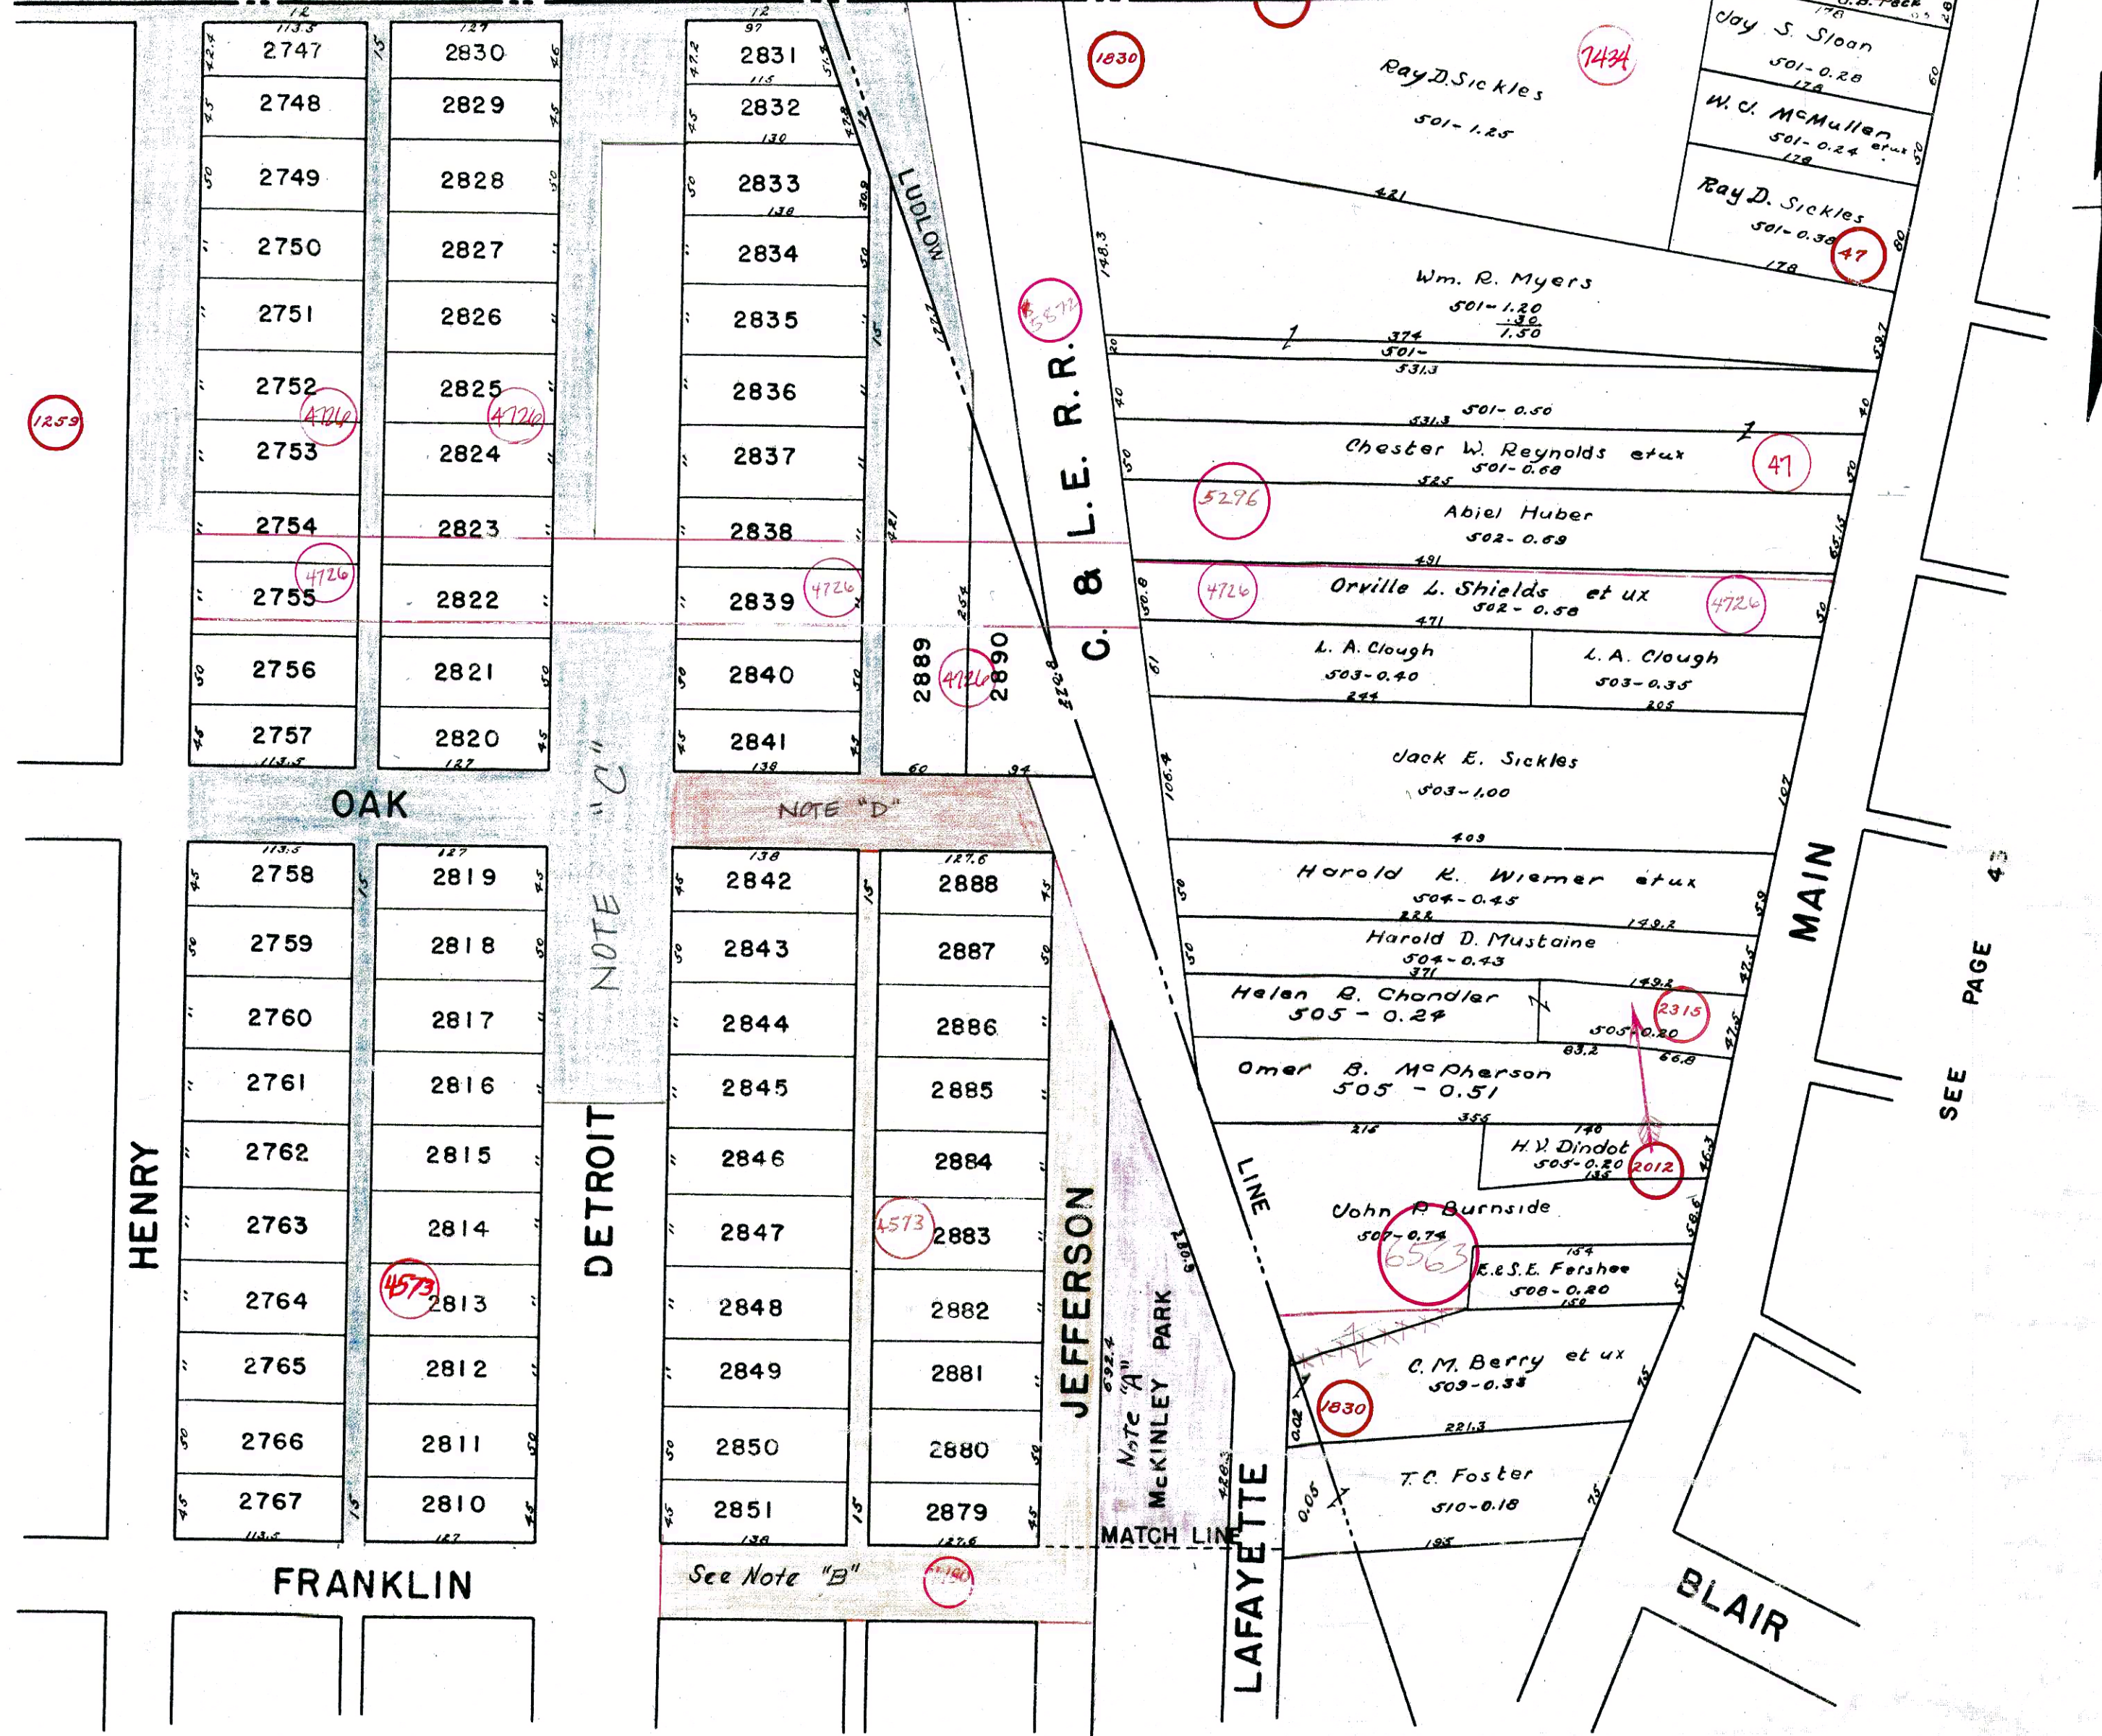

SEE PAGE 22

SEE PAGE 44

SEE PAGE 30