See Lake Twp. Page 2

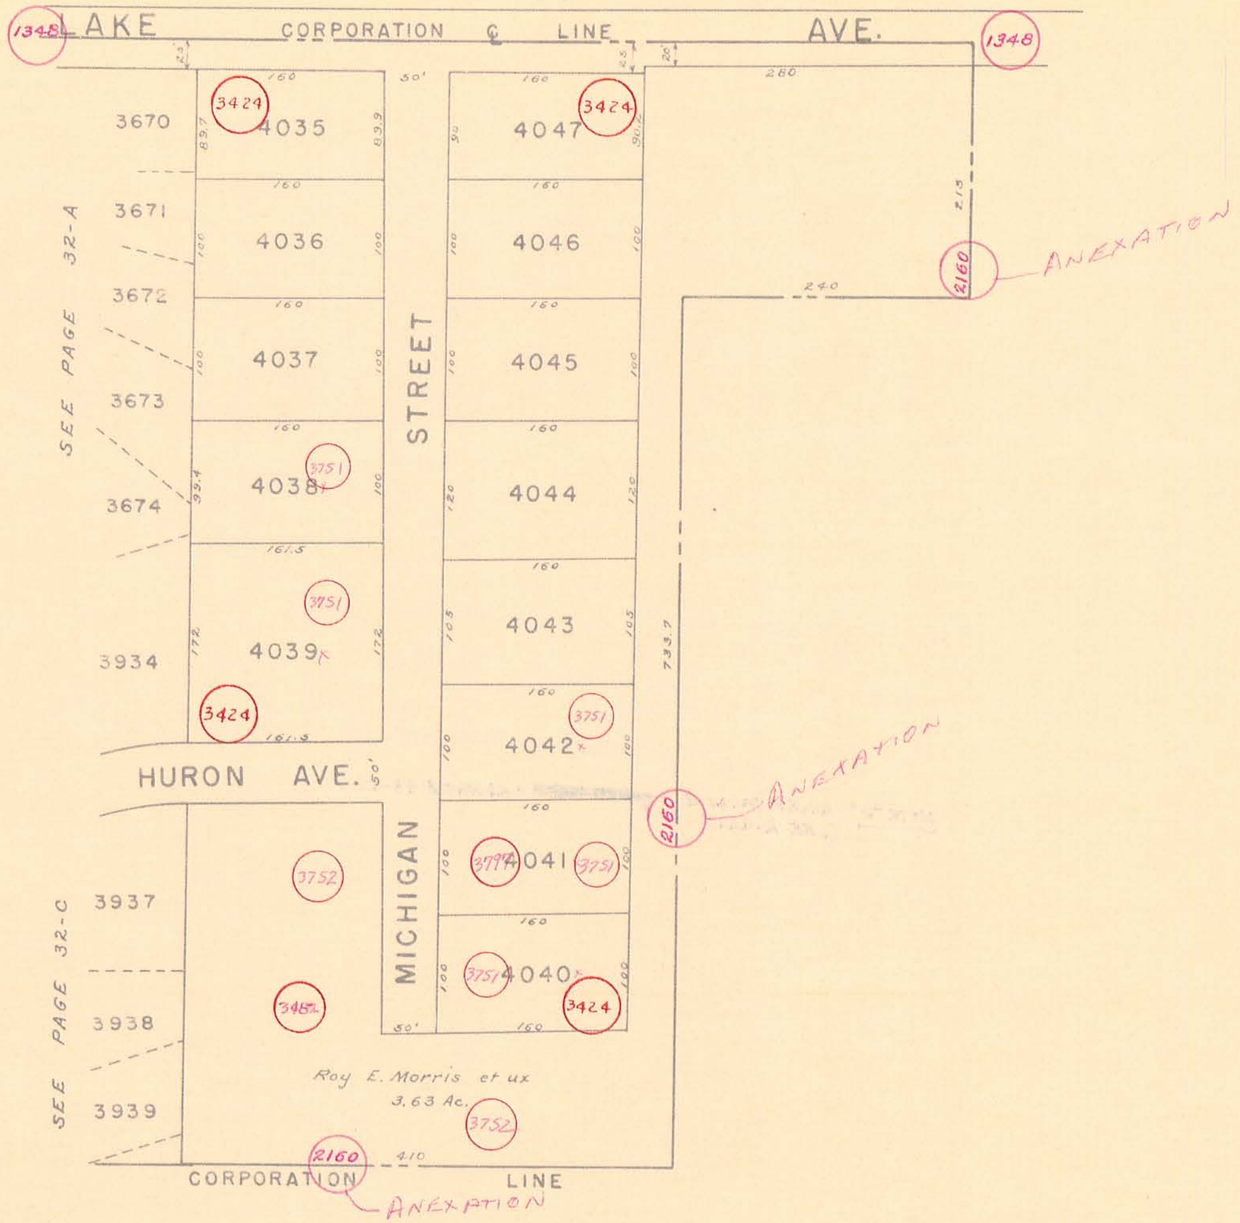

ANNEX 3742

C-24-A

1"=100'