SEE SHEET 40

SEE SHEET 39

SEE SHEET 51

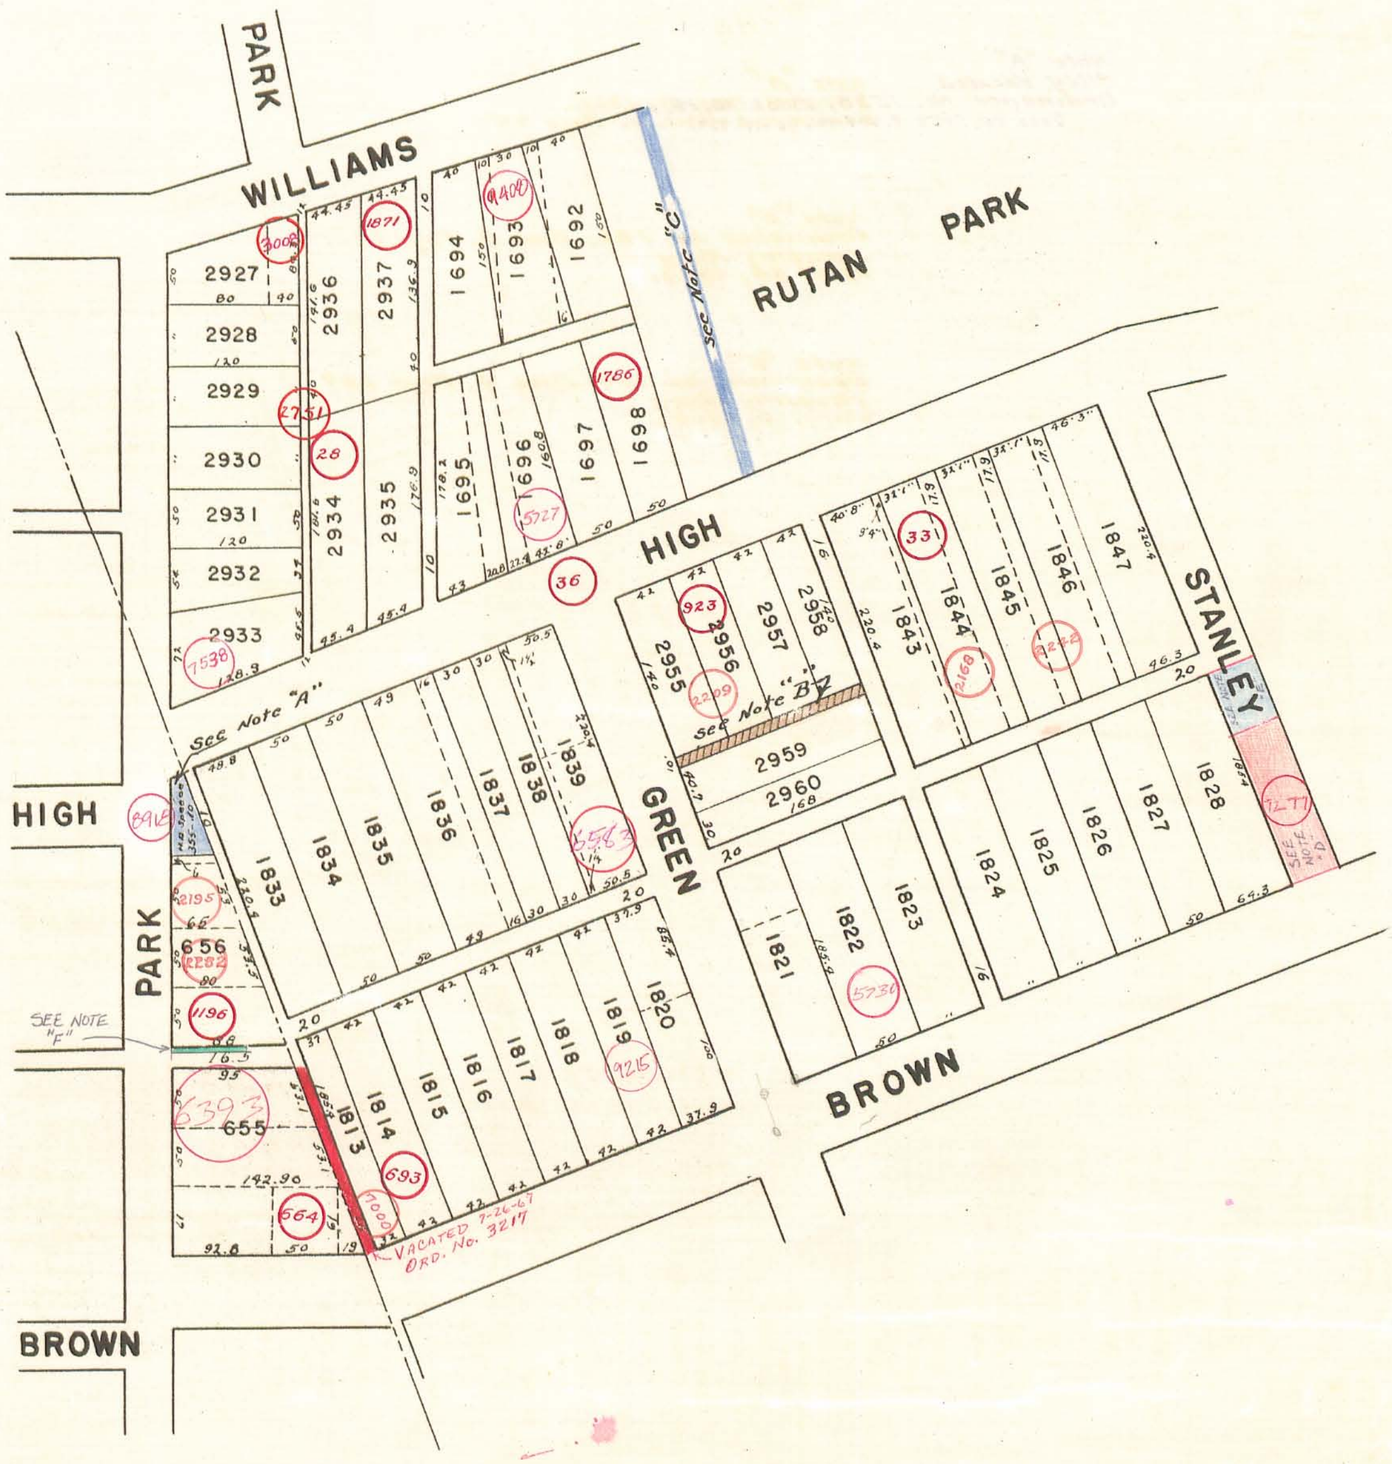

SEE SHEET 48

C-24-A

1"=100'