

NOTE 'A': vacated Ord. No. 20-79  
OR 1394, pg 1405 (FILE R-1707)

1271 MATHEW WHITES SUBDIVISION  
SEE FILE B-16 60


SEE PAGE 61

SEE PAGE 51

SEE PAGE 50

Revised To Jan. 1, 1961

C-24-A

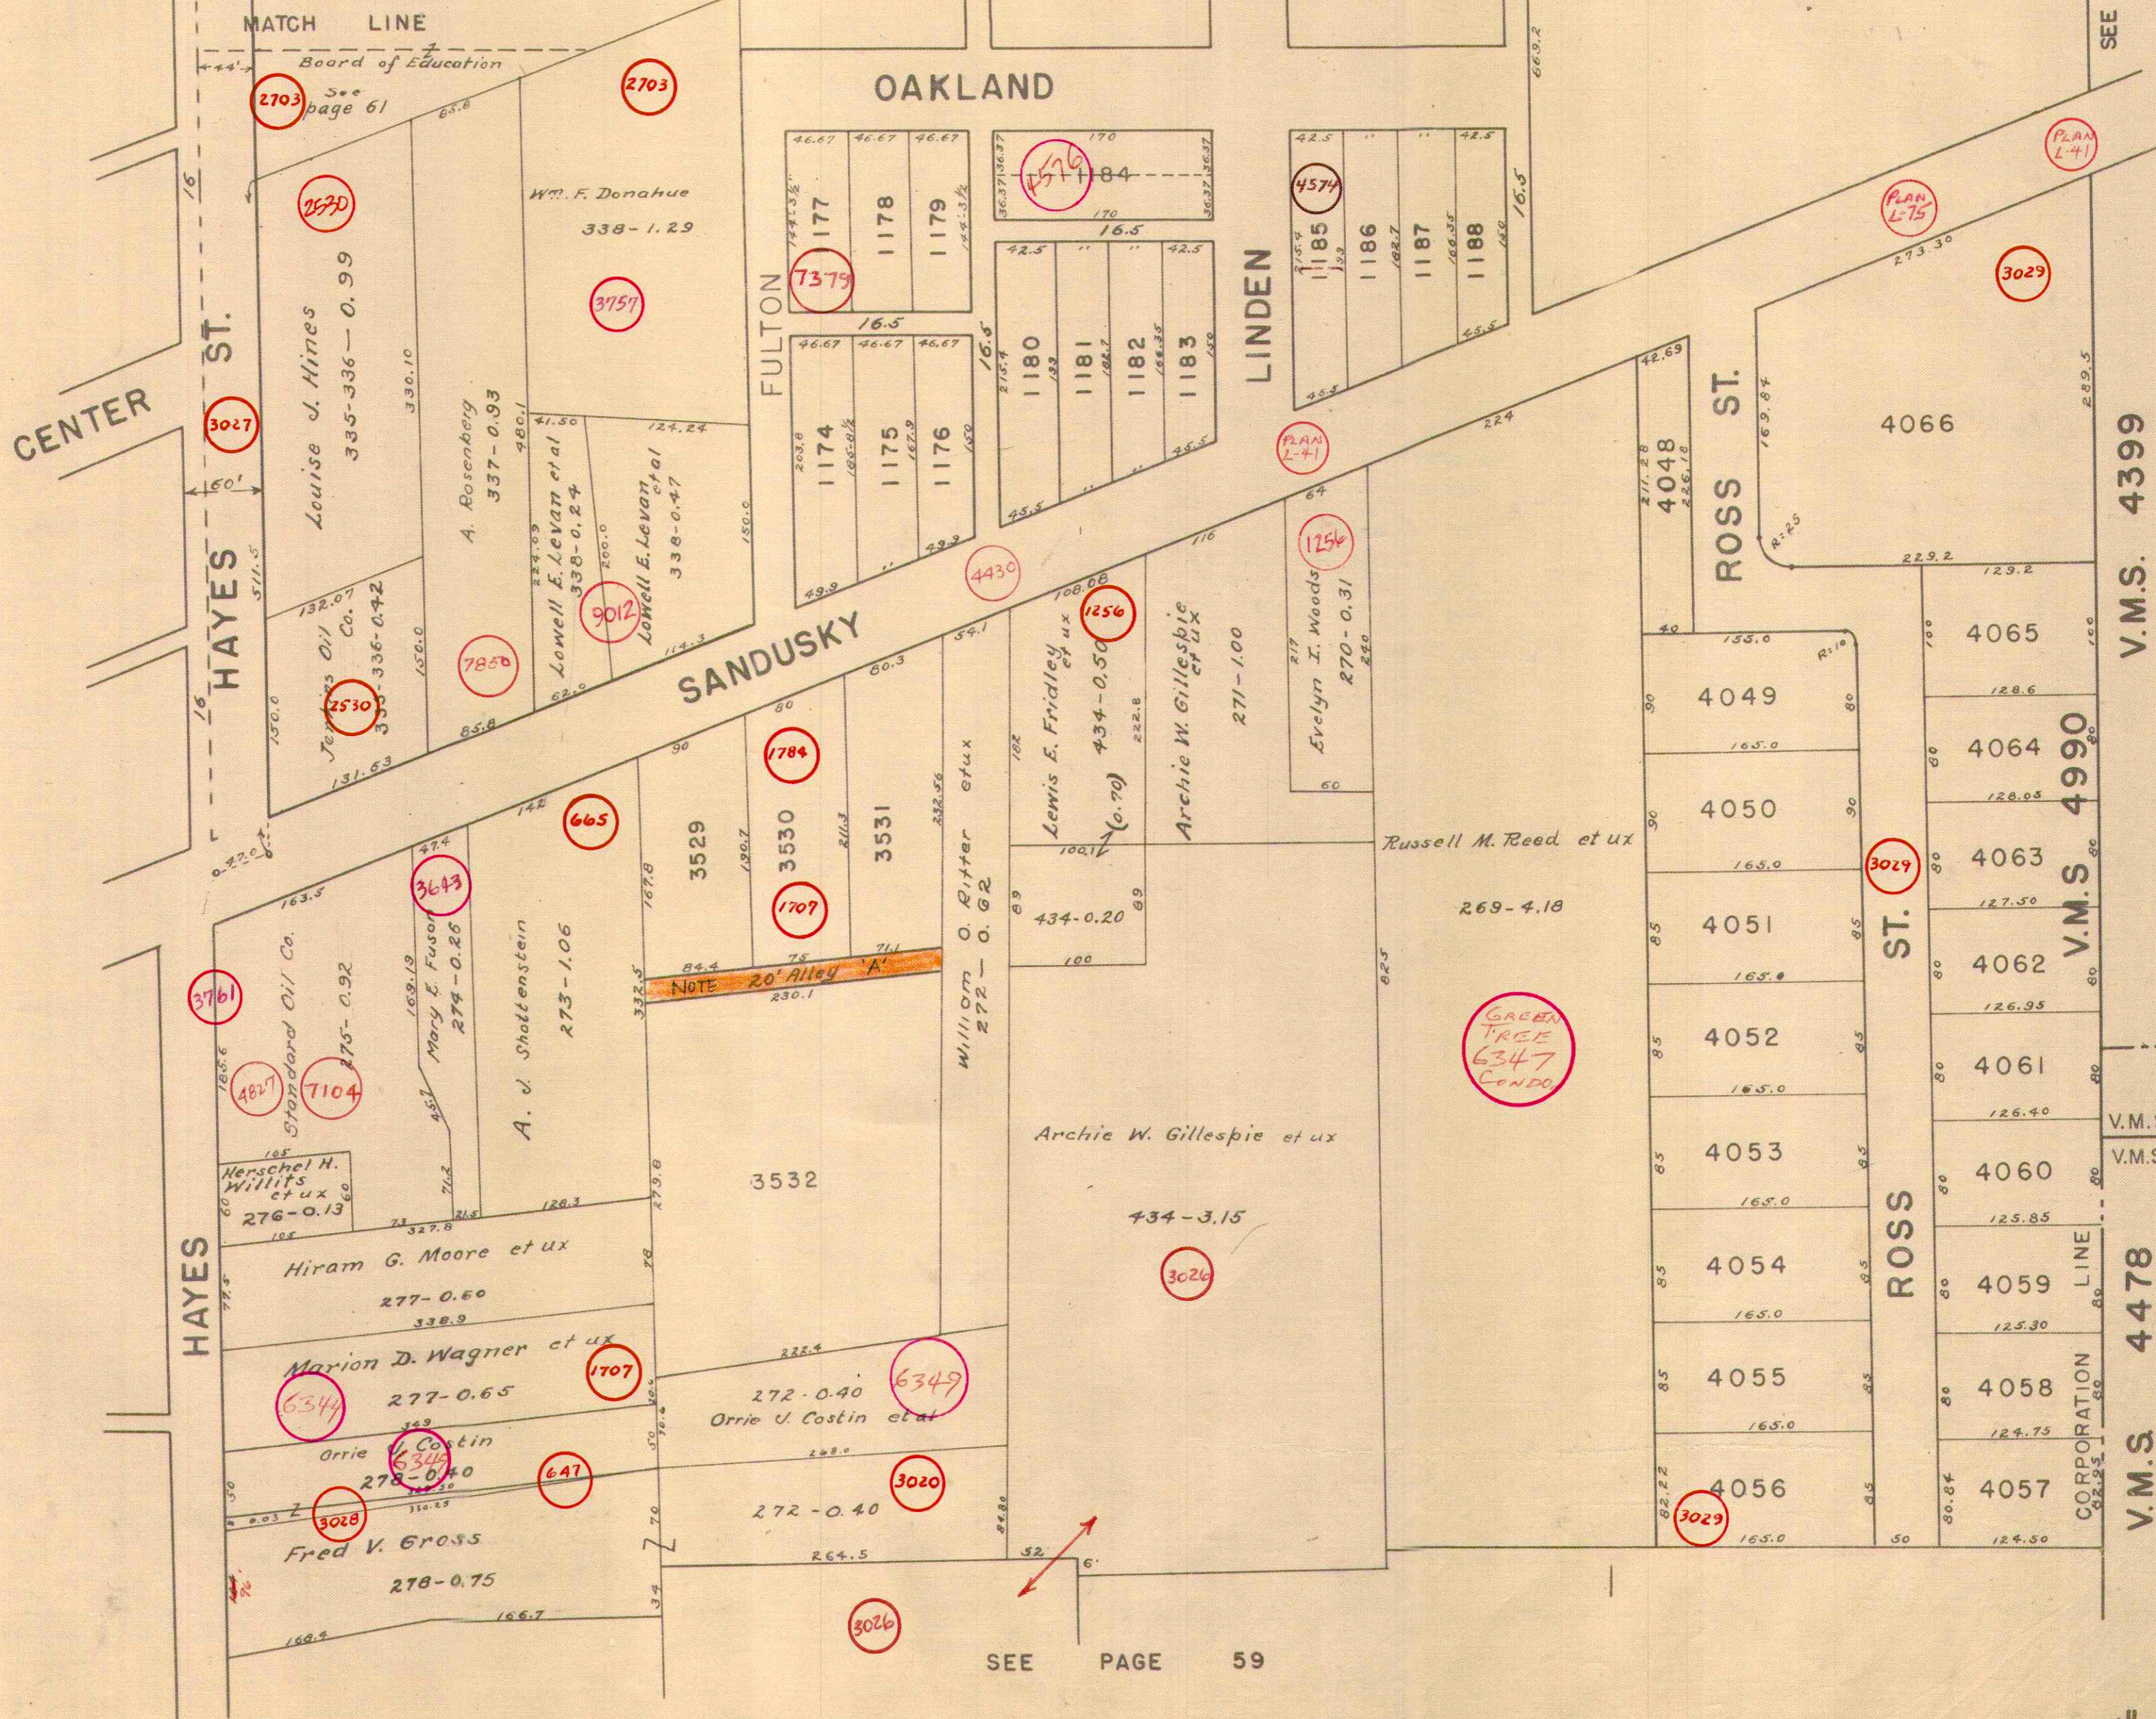

SEE PAGE 68

V.M.S. 4399

SEE PAGE 67

V.M.S. 4399

V.M.S. 4478

V.M.S. 4478

SEE PAGE 59

1" = 100'