

SEE PAGE 73


SEE PAGE 71

SEE PAGE 72

SEE PAGE 55-A

SEE PAGE 55

Belle-Air Estates Inc.
28.75

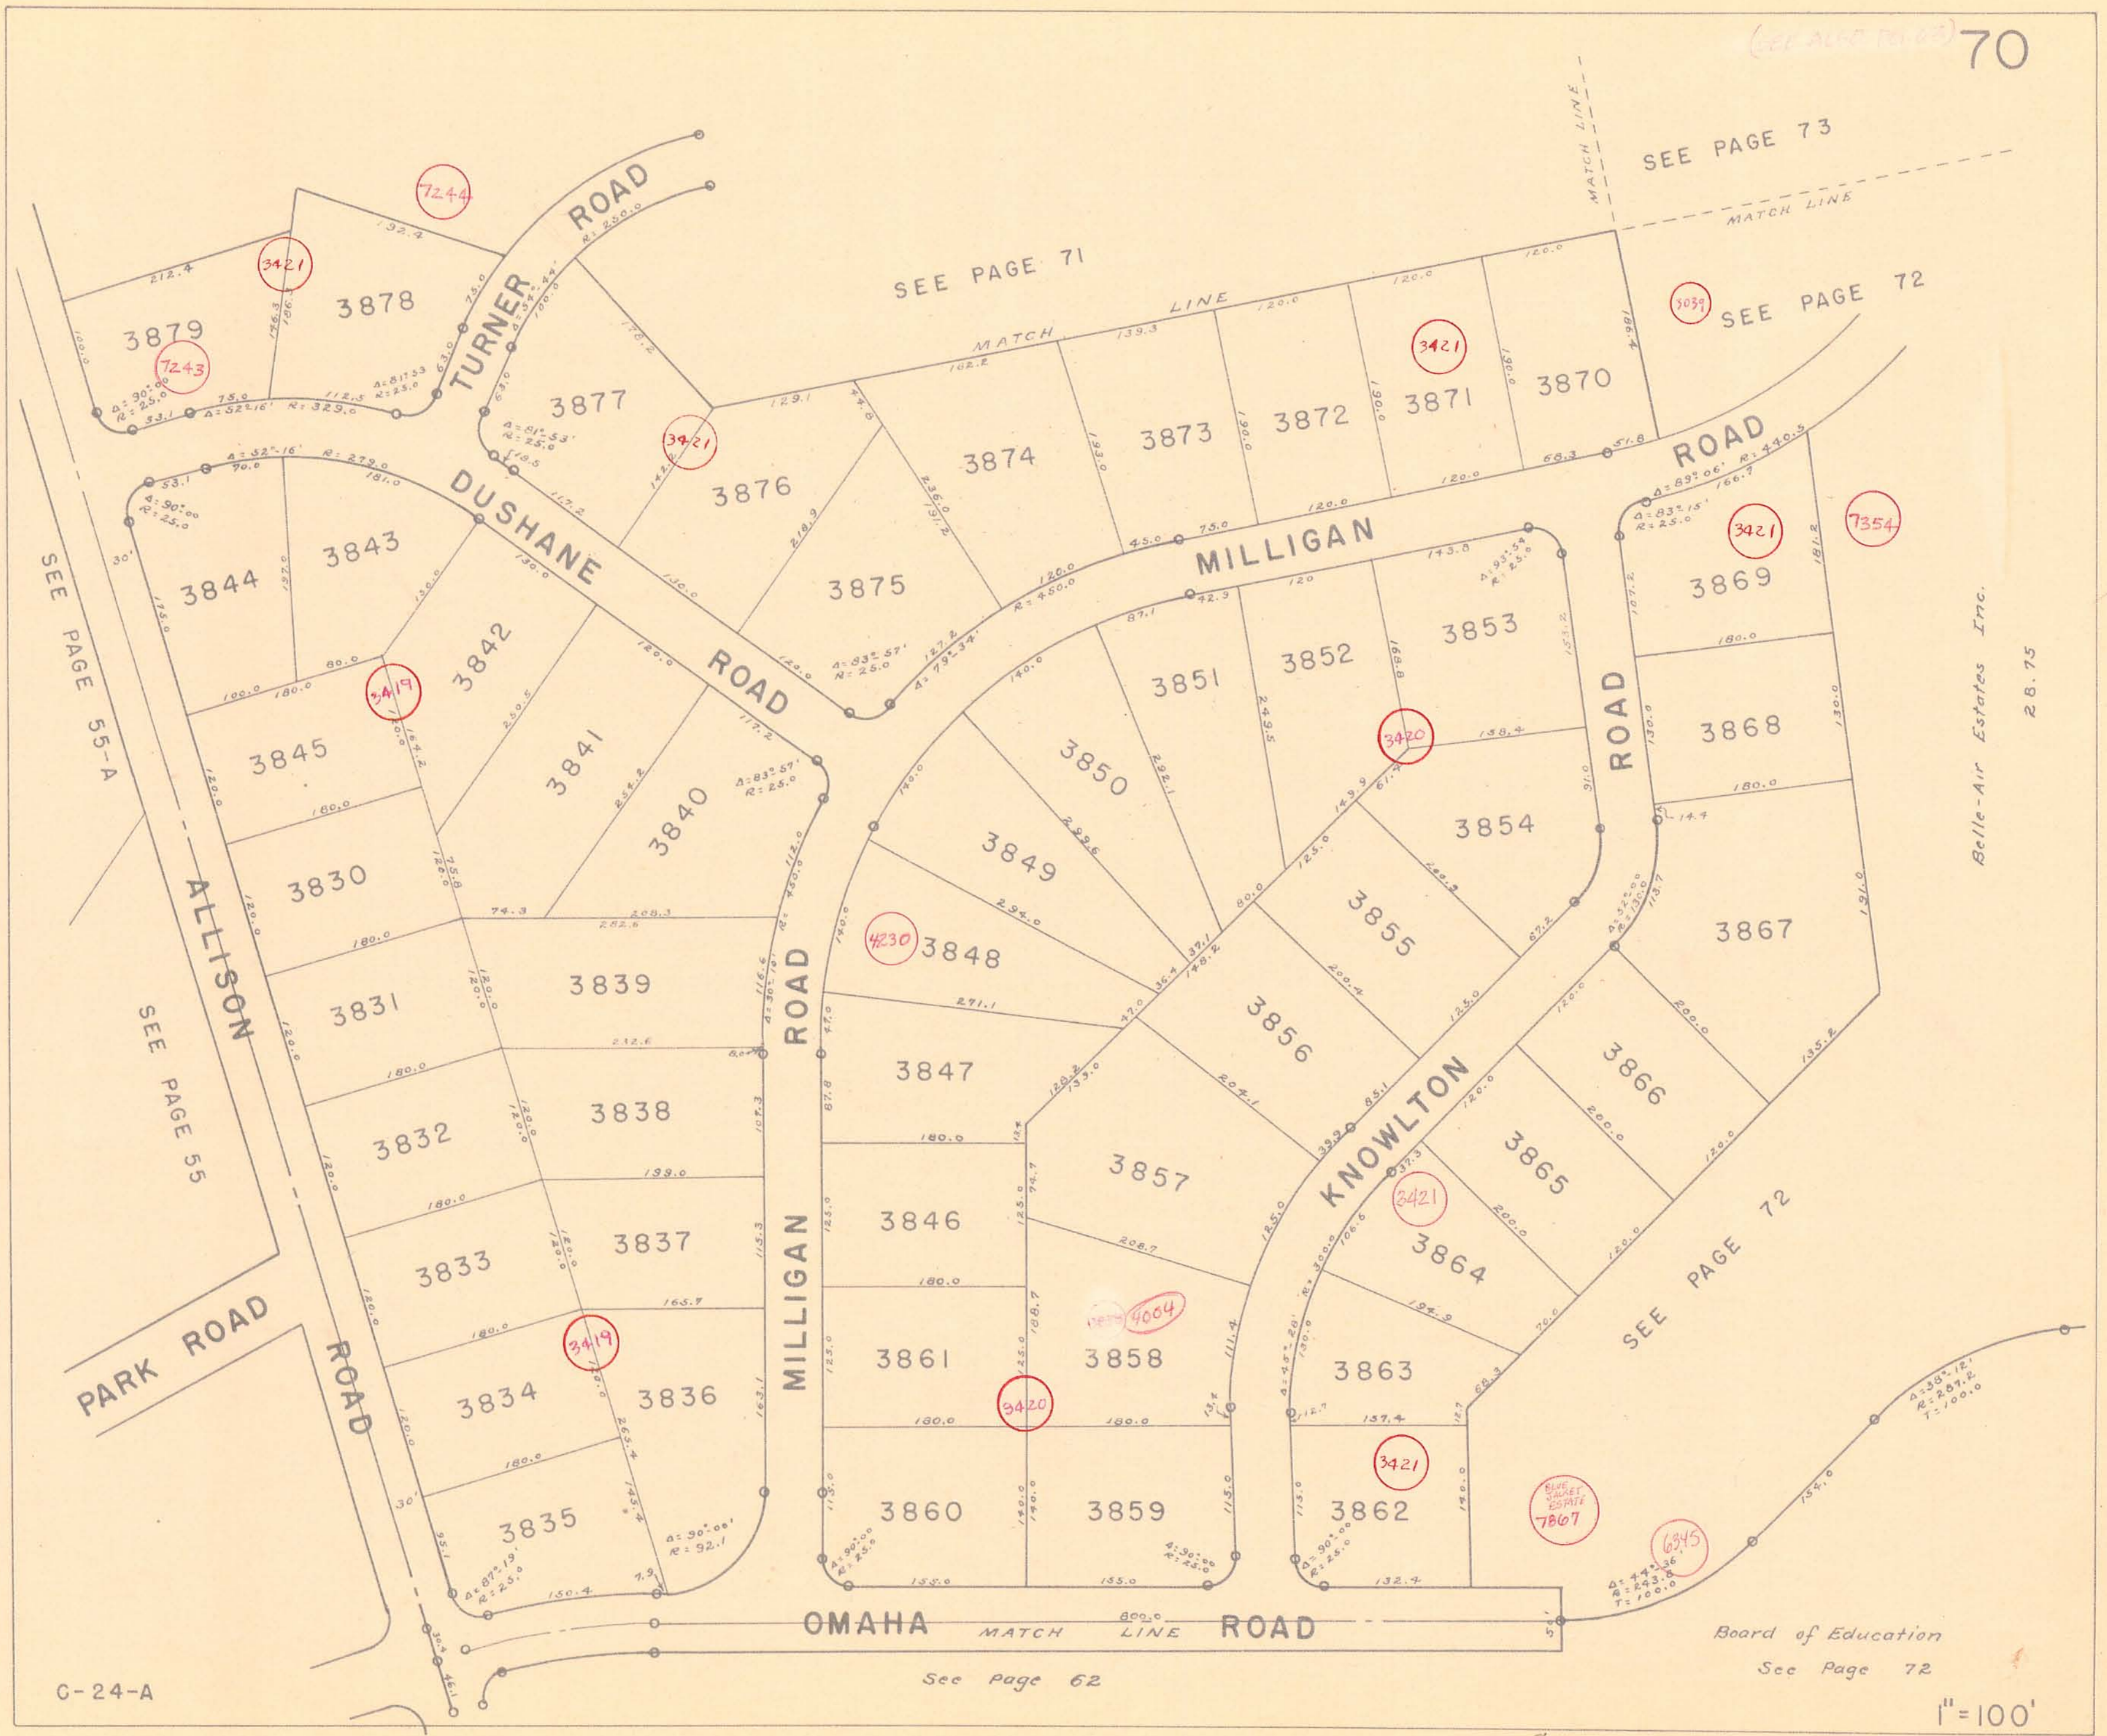

G-24-A

See Page 62

Board of Education
See Page 72

1" = 100'