


VIRGINIA MILITARY SURVEY 9958

SCALE 10 CHAINS TO INCH

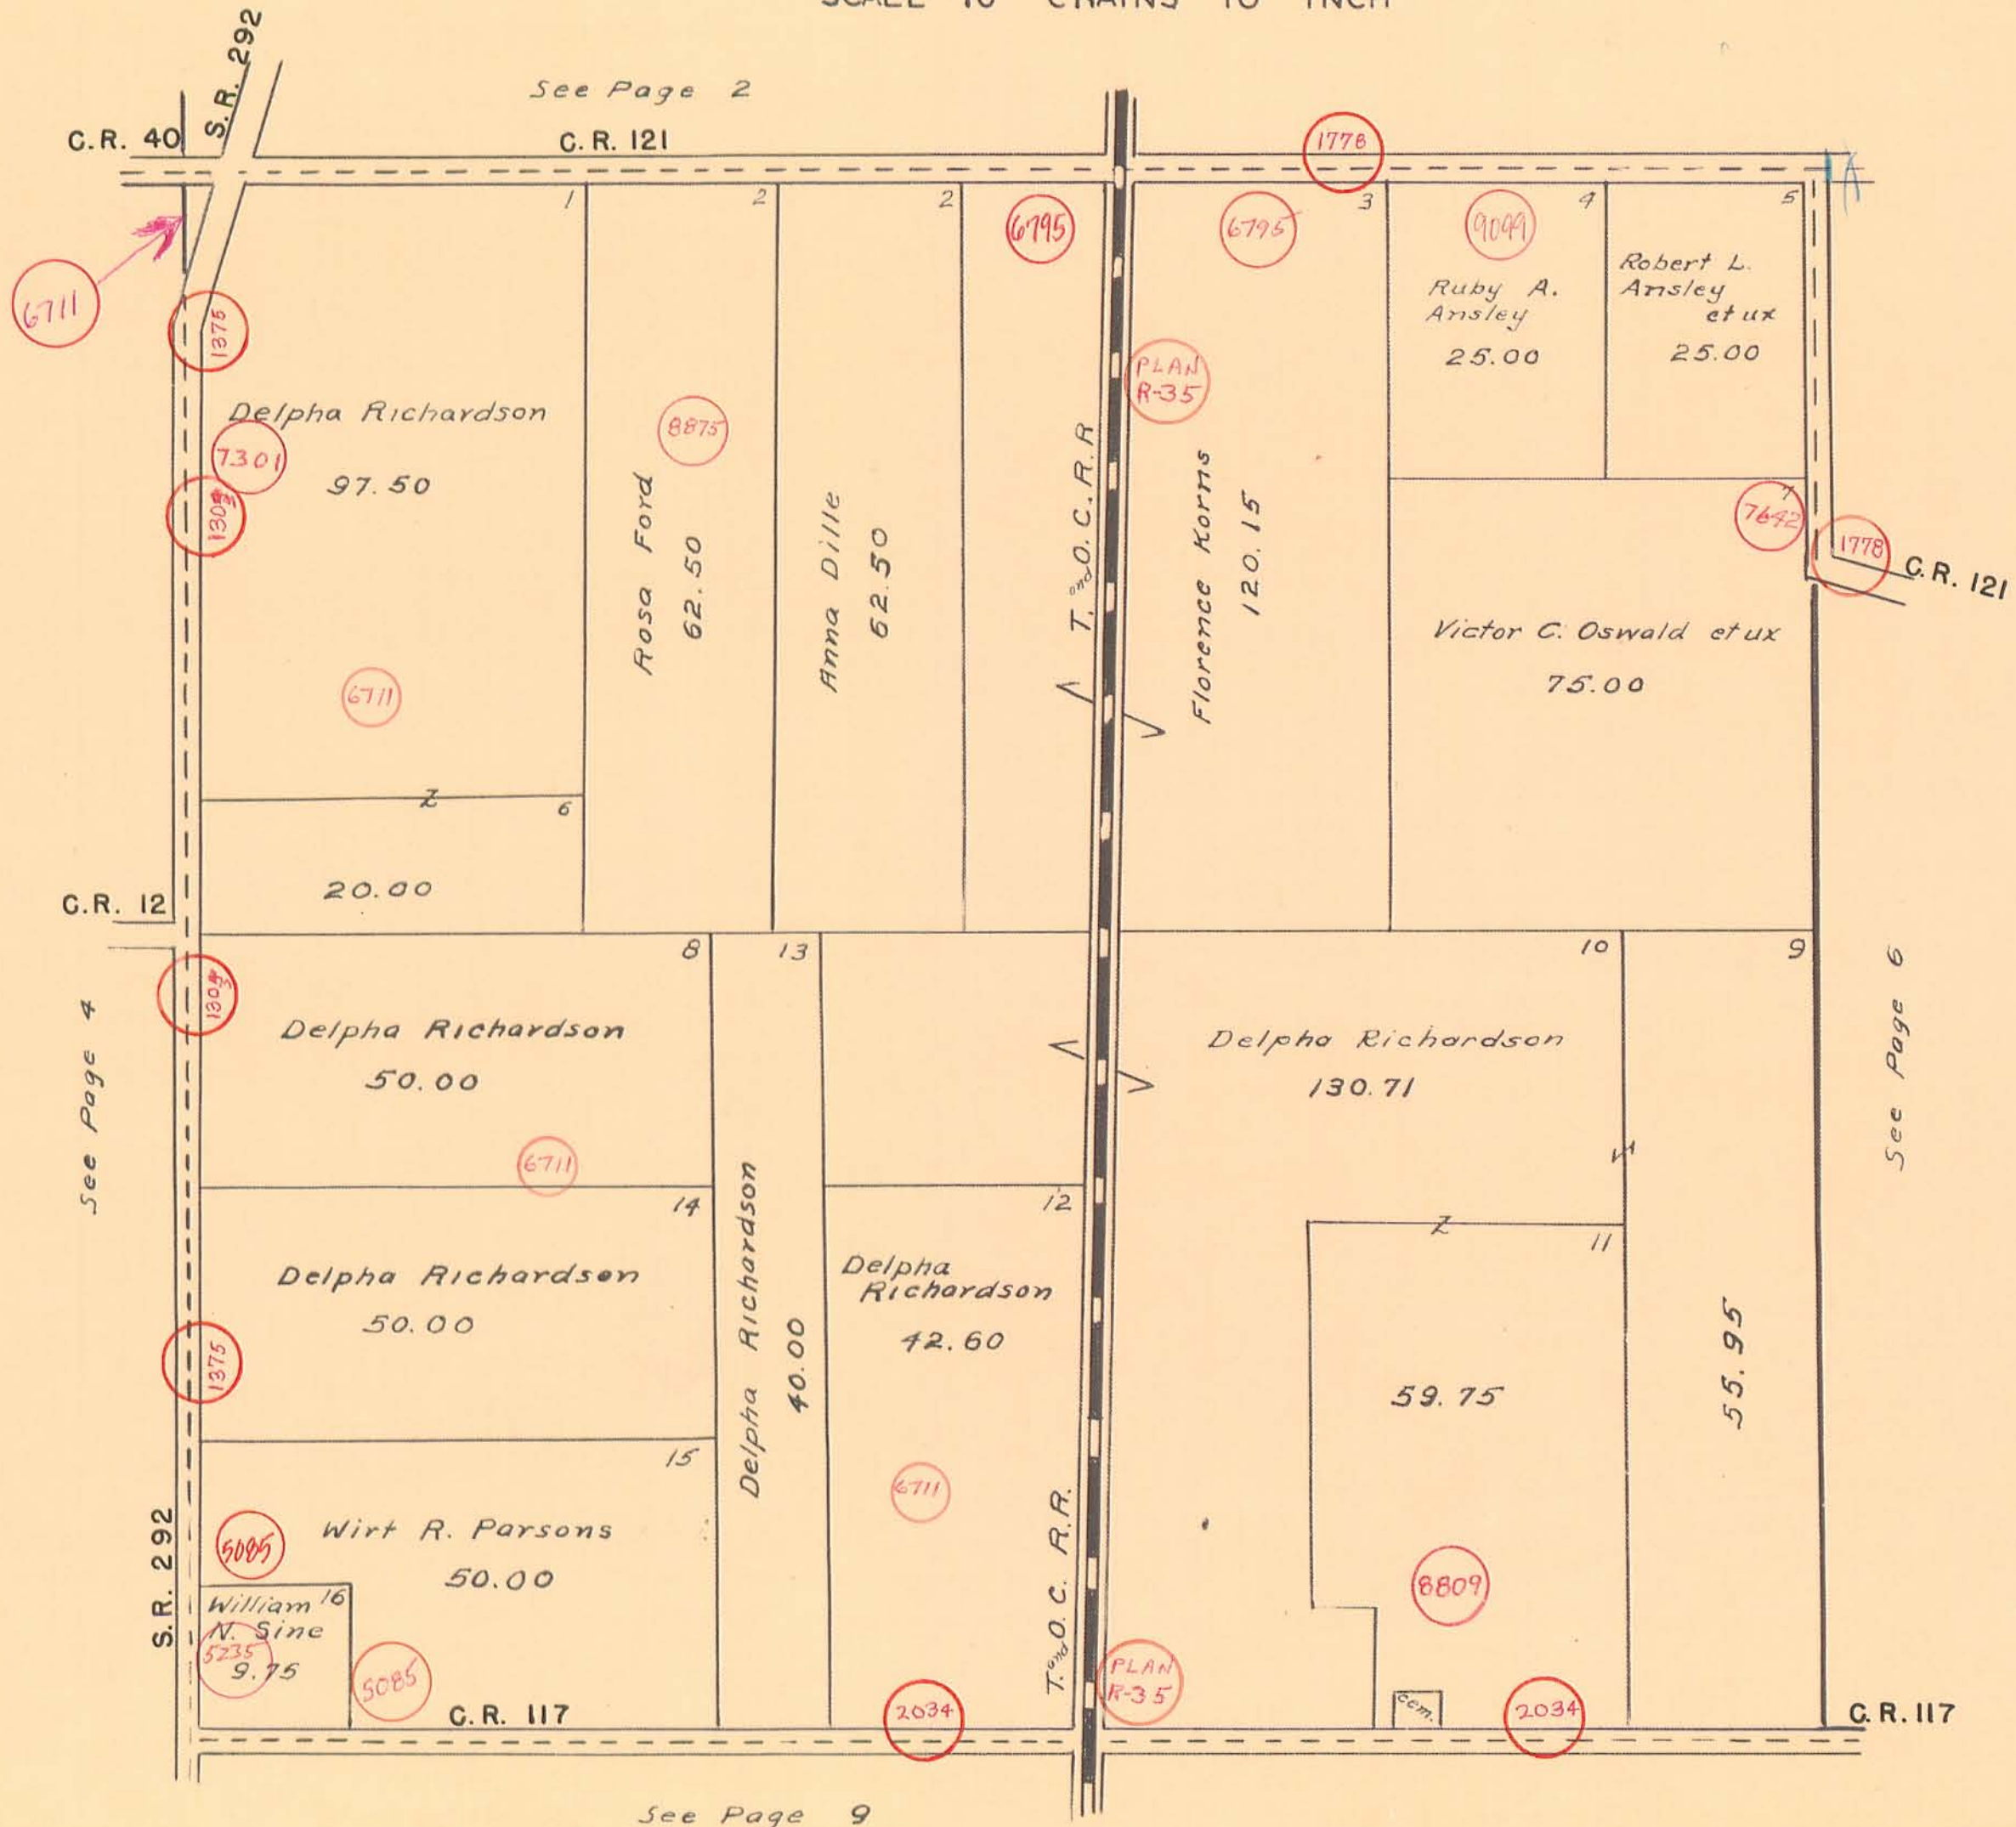

See Page 2

See Page 4

See Page 6

See Page 9