


VIRGINIA MILITARY SURVEYS 755 6155

SCALE 1-INCH = 200 FEET

WEST MANSFIELD CORPORATION

SUBS 104 TO 165 INCL.

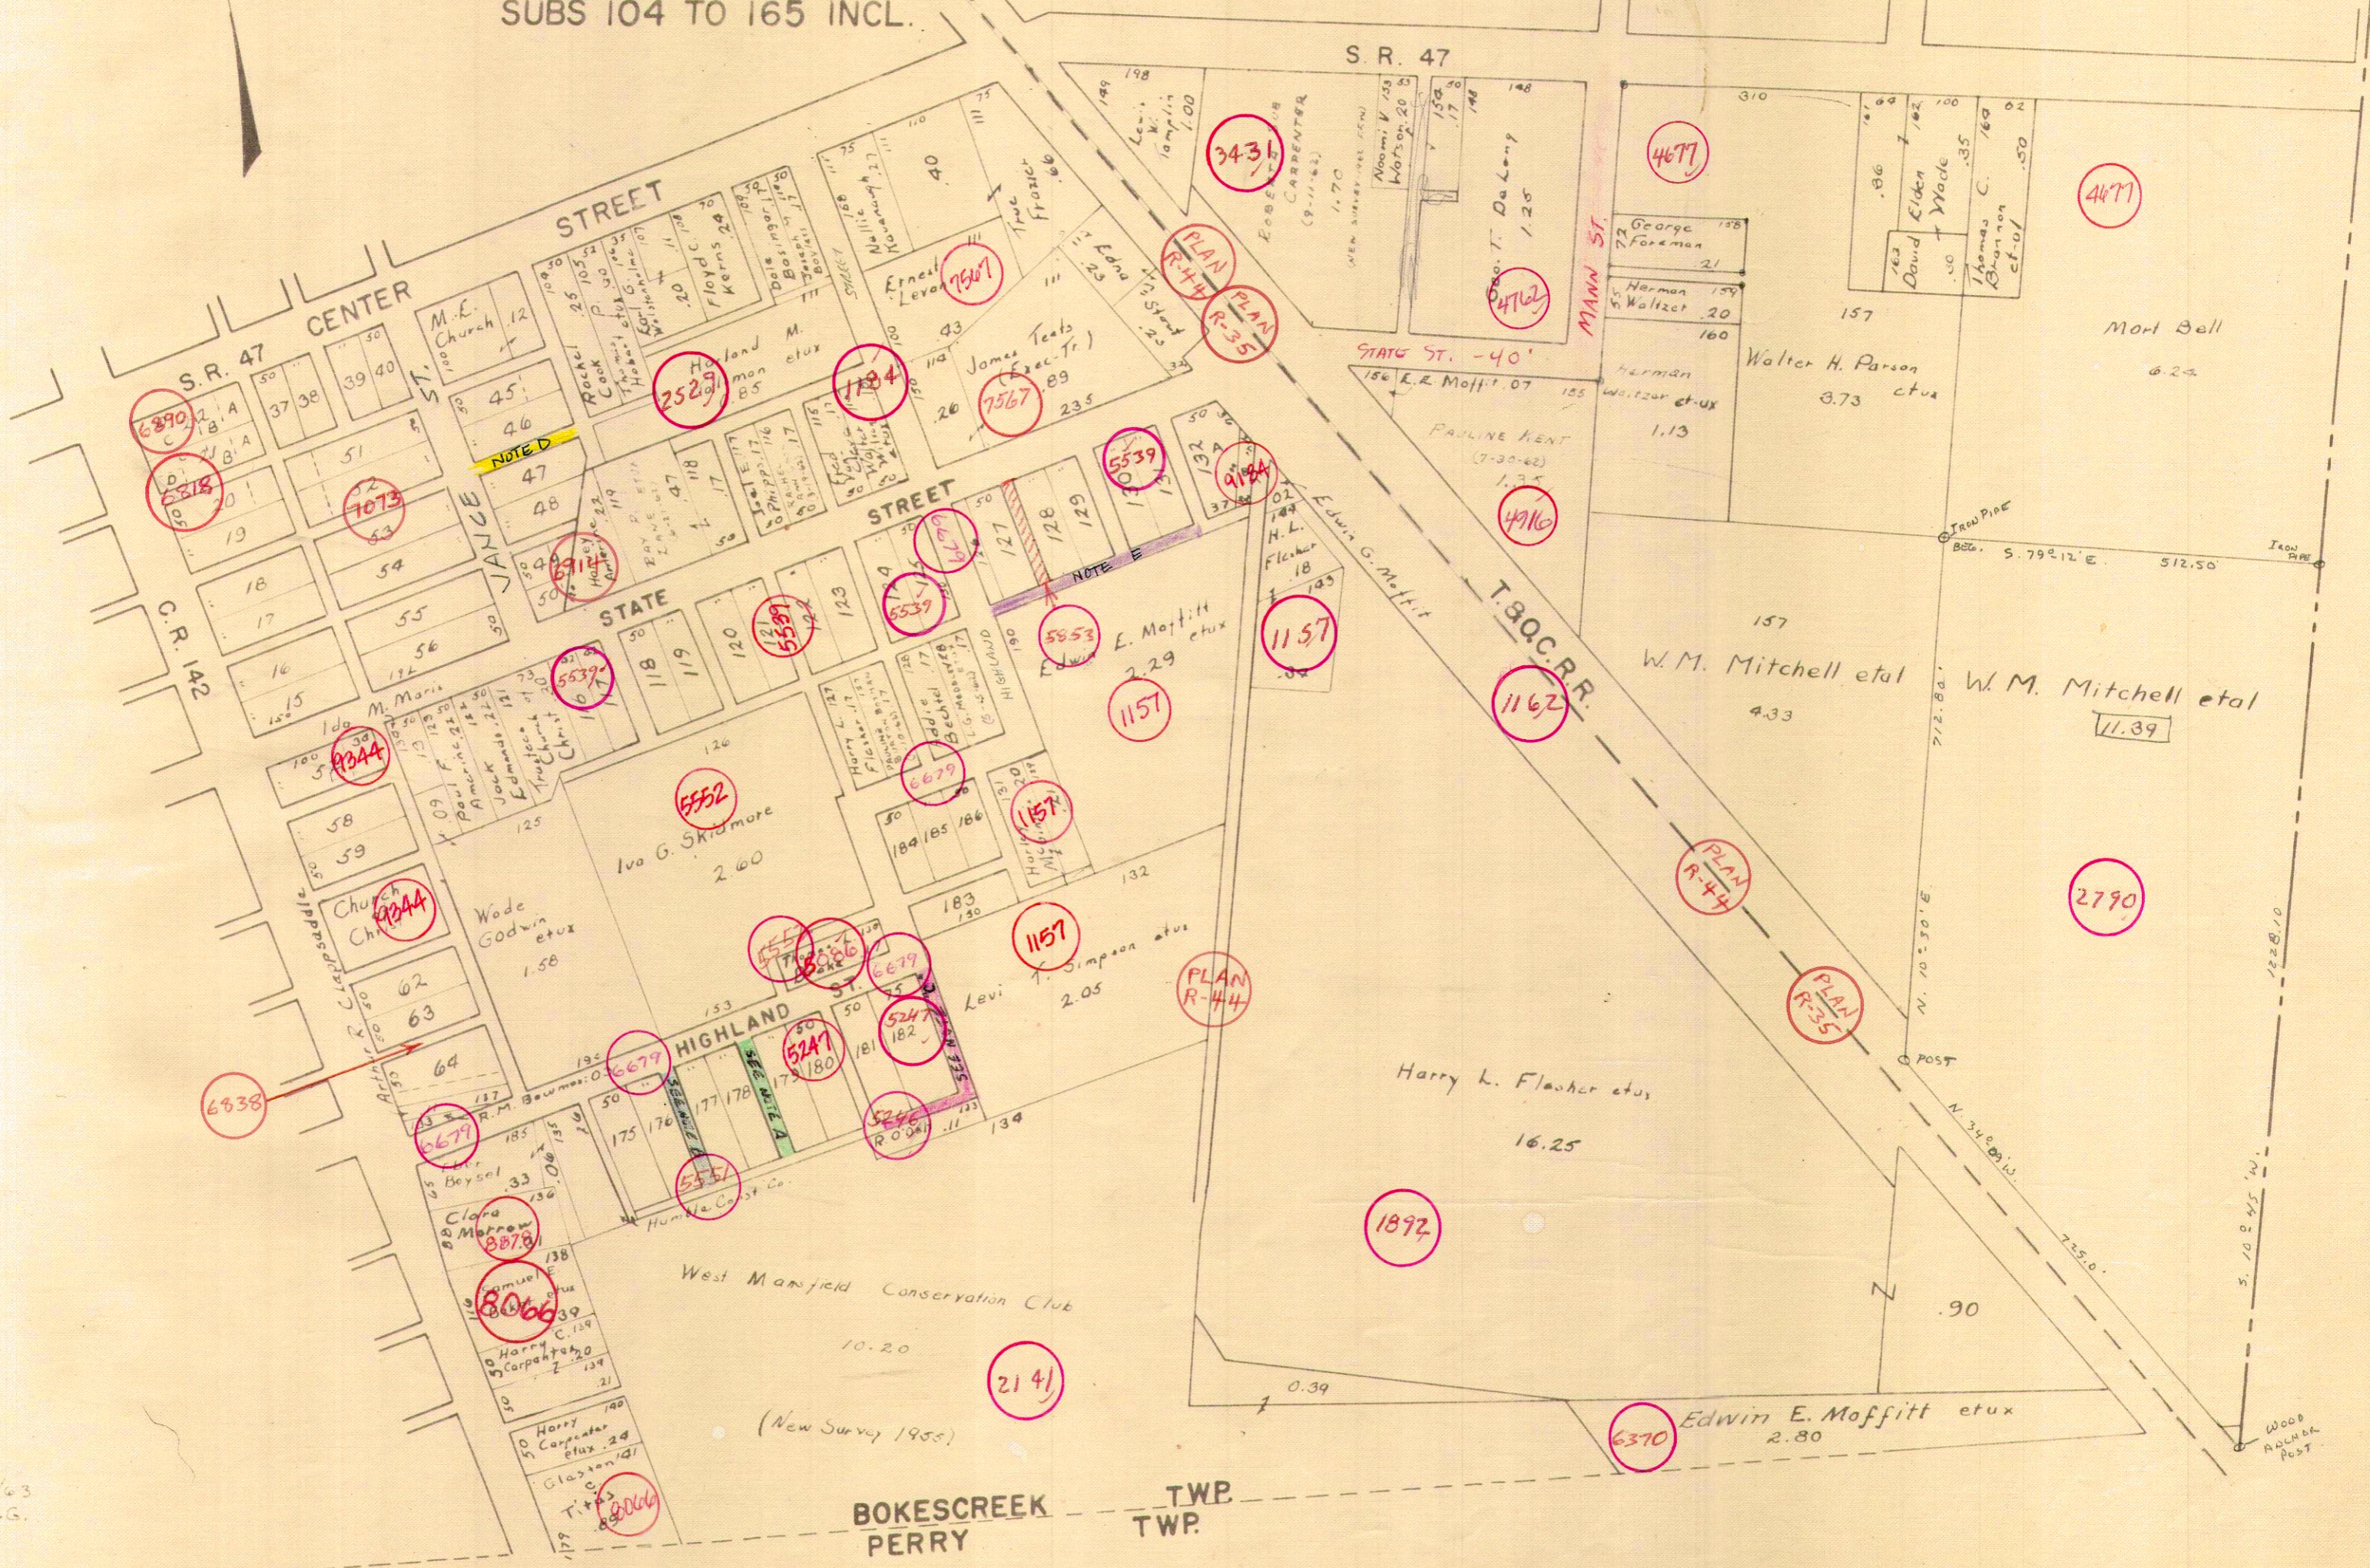

11/1/63  
D.E.G.

BOKESCREEK PERRY TWP.  
TWP.