HARRISON TOWNSHIP

SECTION 1 TOWN 2 RANGE 15

SCALE: 1" = 10 CHAINS = 660'

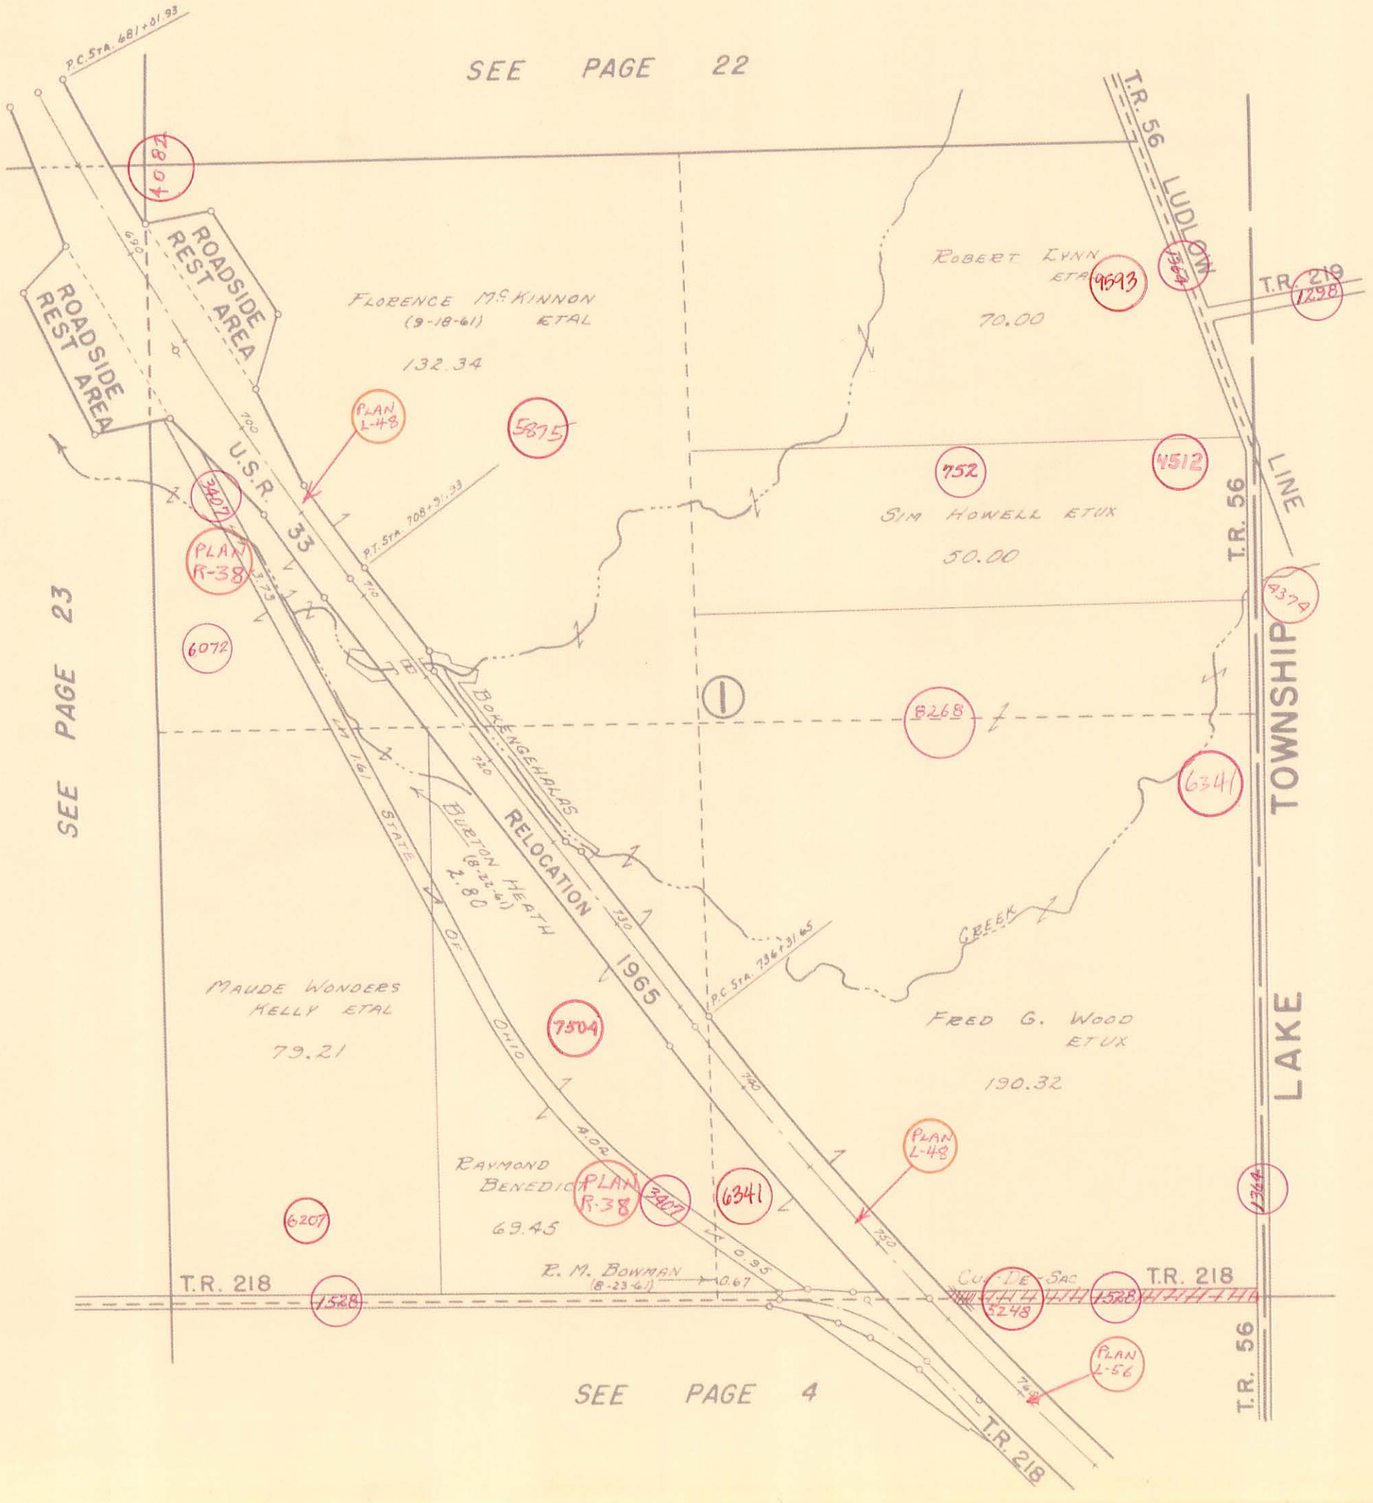

DRAWN 2-14-66 D.E.G.
FROM AERIAL PHOTO.