HARRISON TOWNSHIP

SECTION 7 TOWN 2 RANGE 15
SECTION 8 TOWN 2 RANGE 15

SCALE 10 CHAINS TO THE INCH

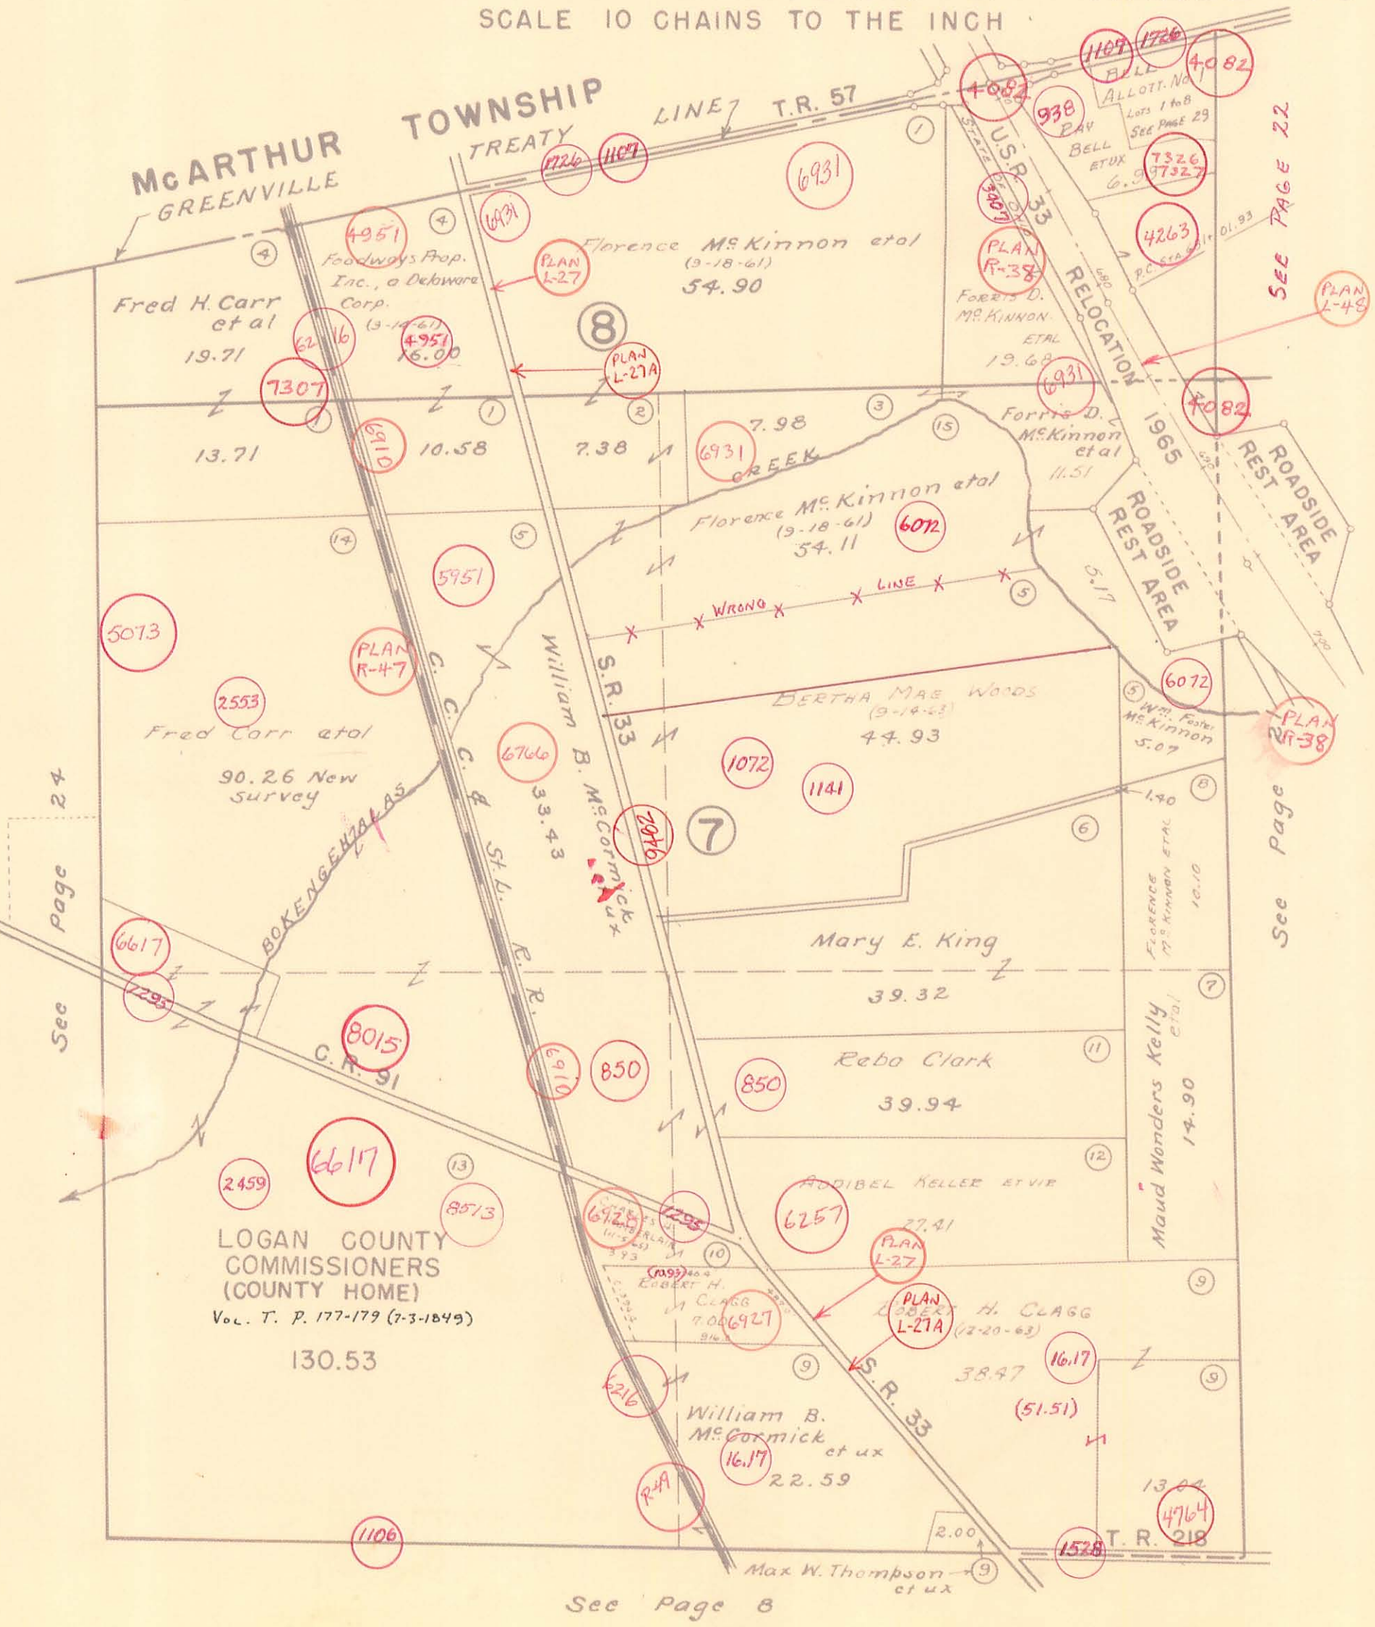

Drawn Dec. 28, 1953
From Aerial Photo.