

JEFFERSON TOWNSHIP
VIRGINIA MILITARY SURVEY 3139

SCALE: 1"=10 CHAINS=660'

SEE PAGE 14

DRAWN OCTOBER 29, 1962
BY D.E.G.
FROM AERIAL PHOTO


SEE PAGE 8

SEE PAGE 9

SEE PAGE 12

SEE PAGE 19

SEE PAGE 20

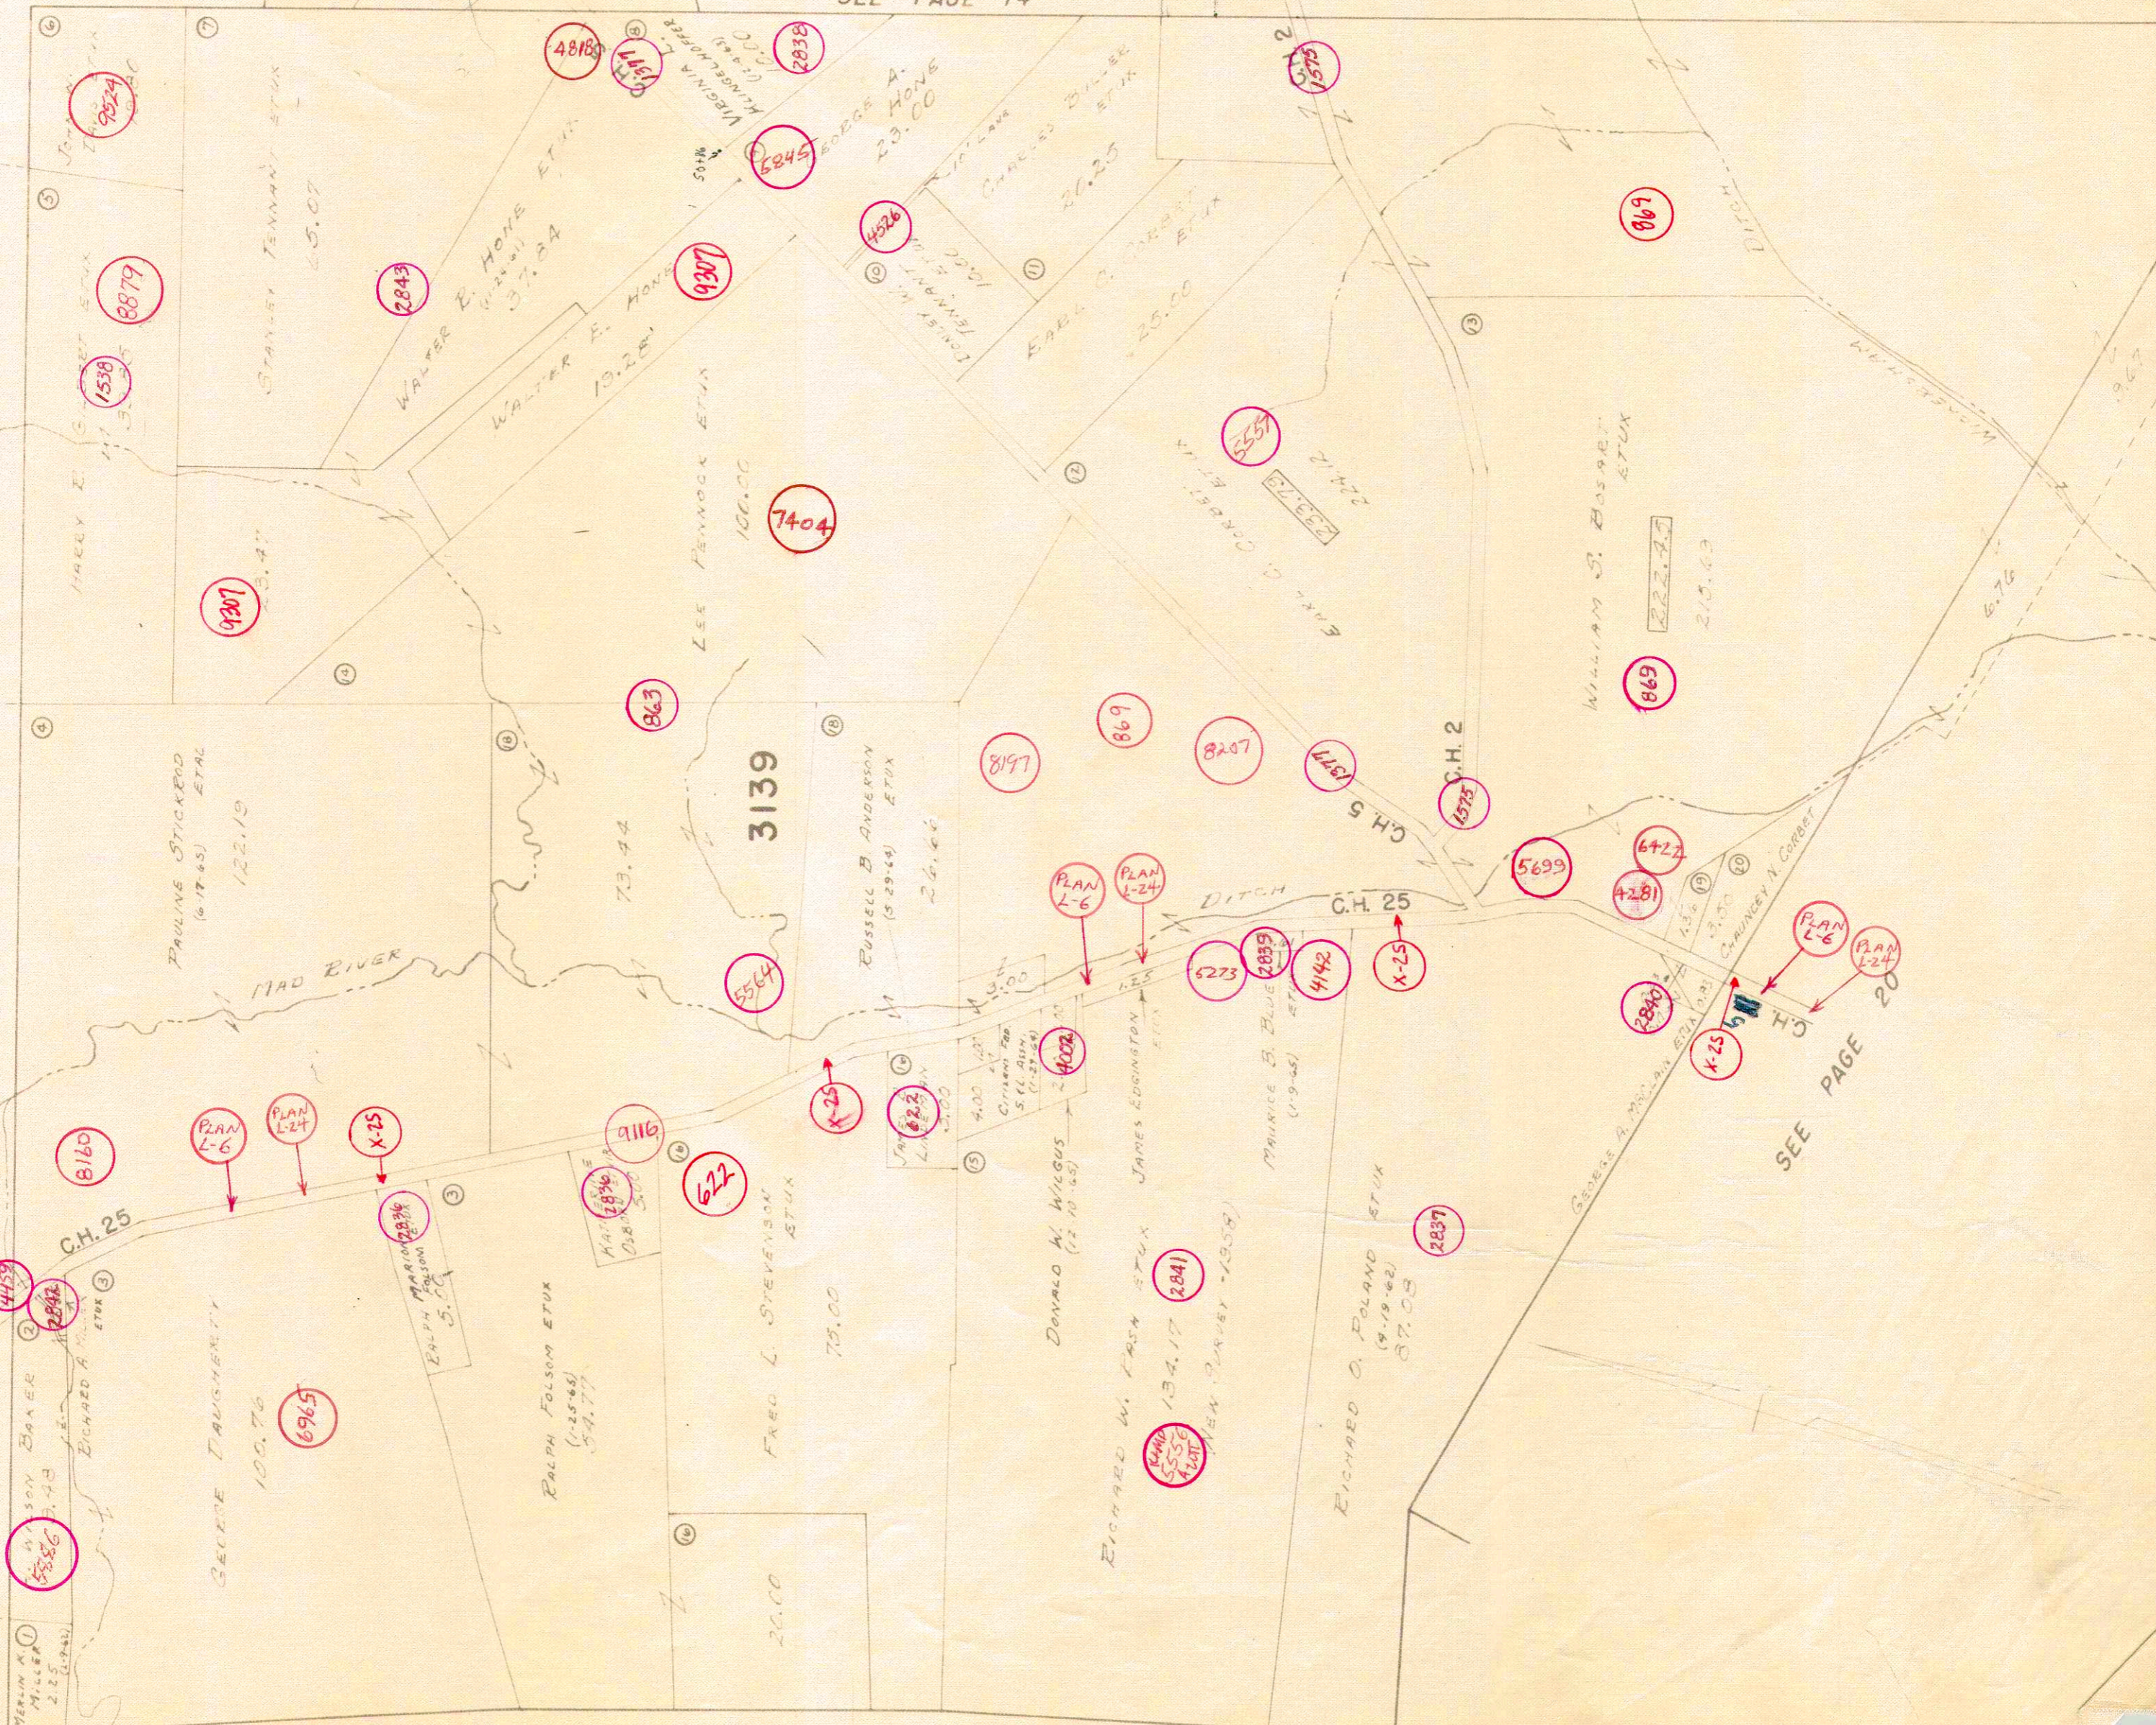

