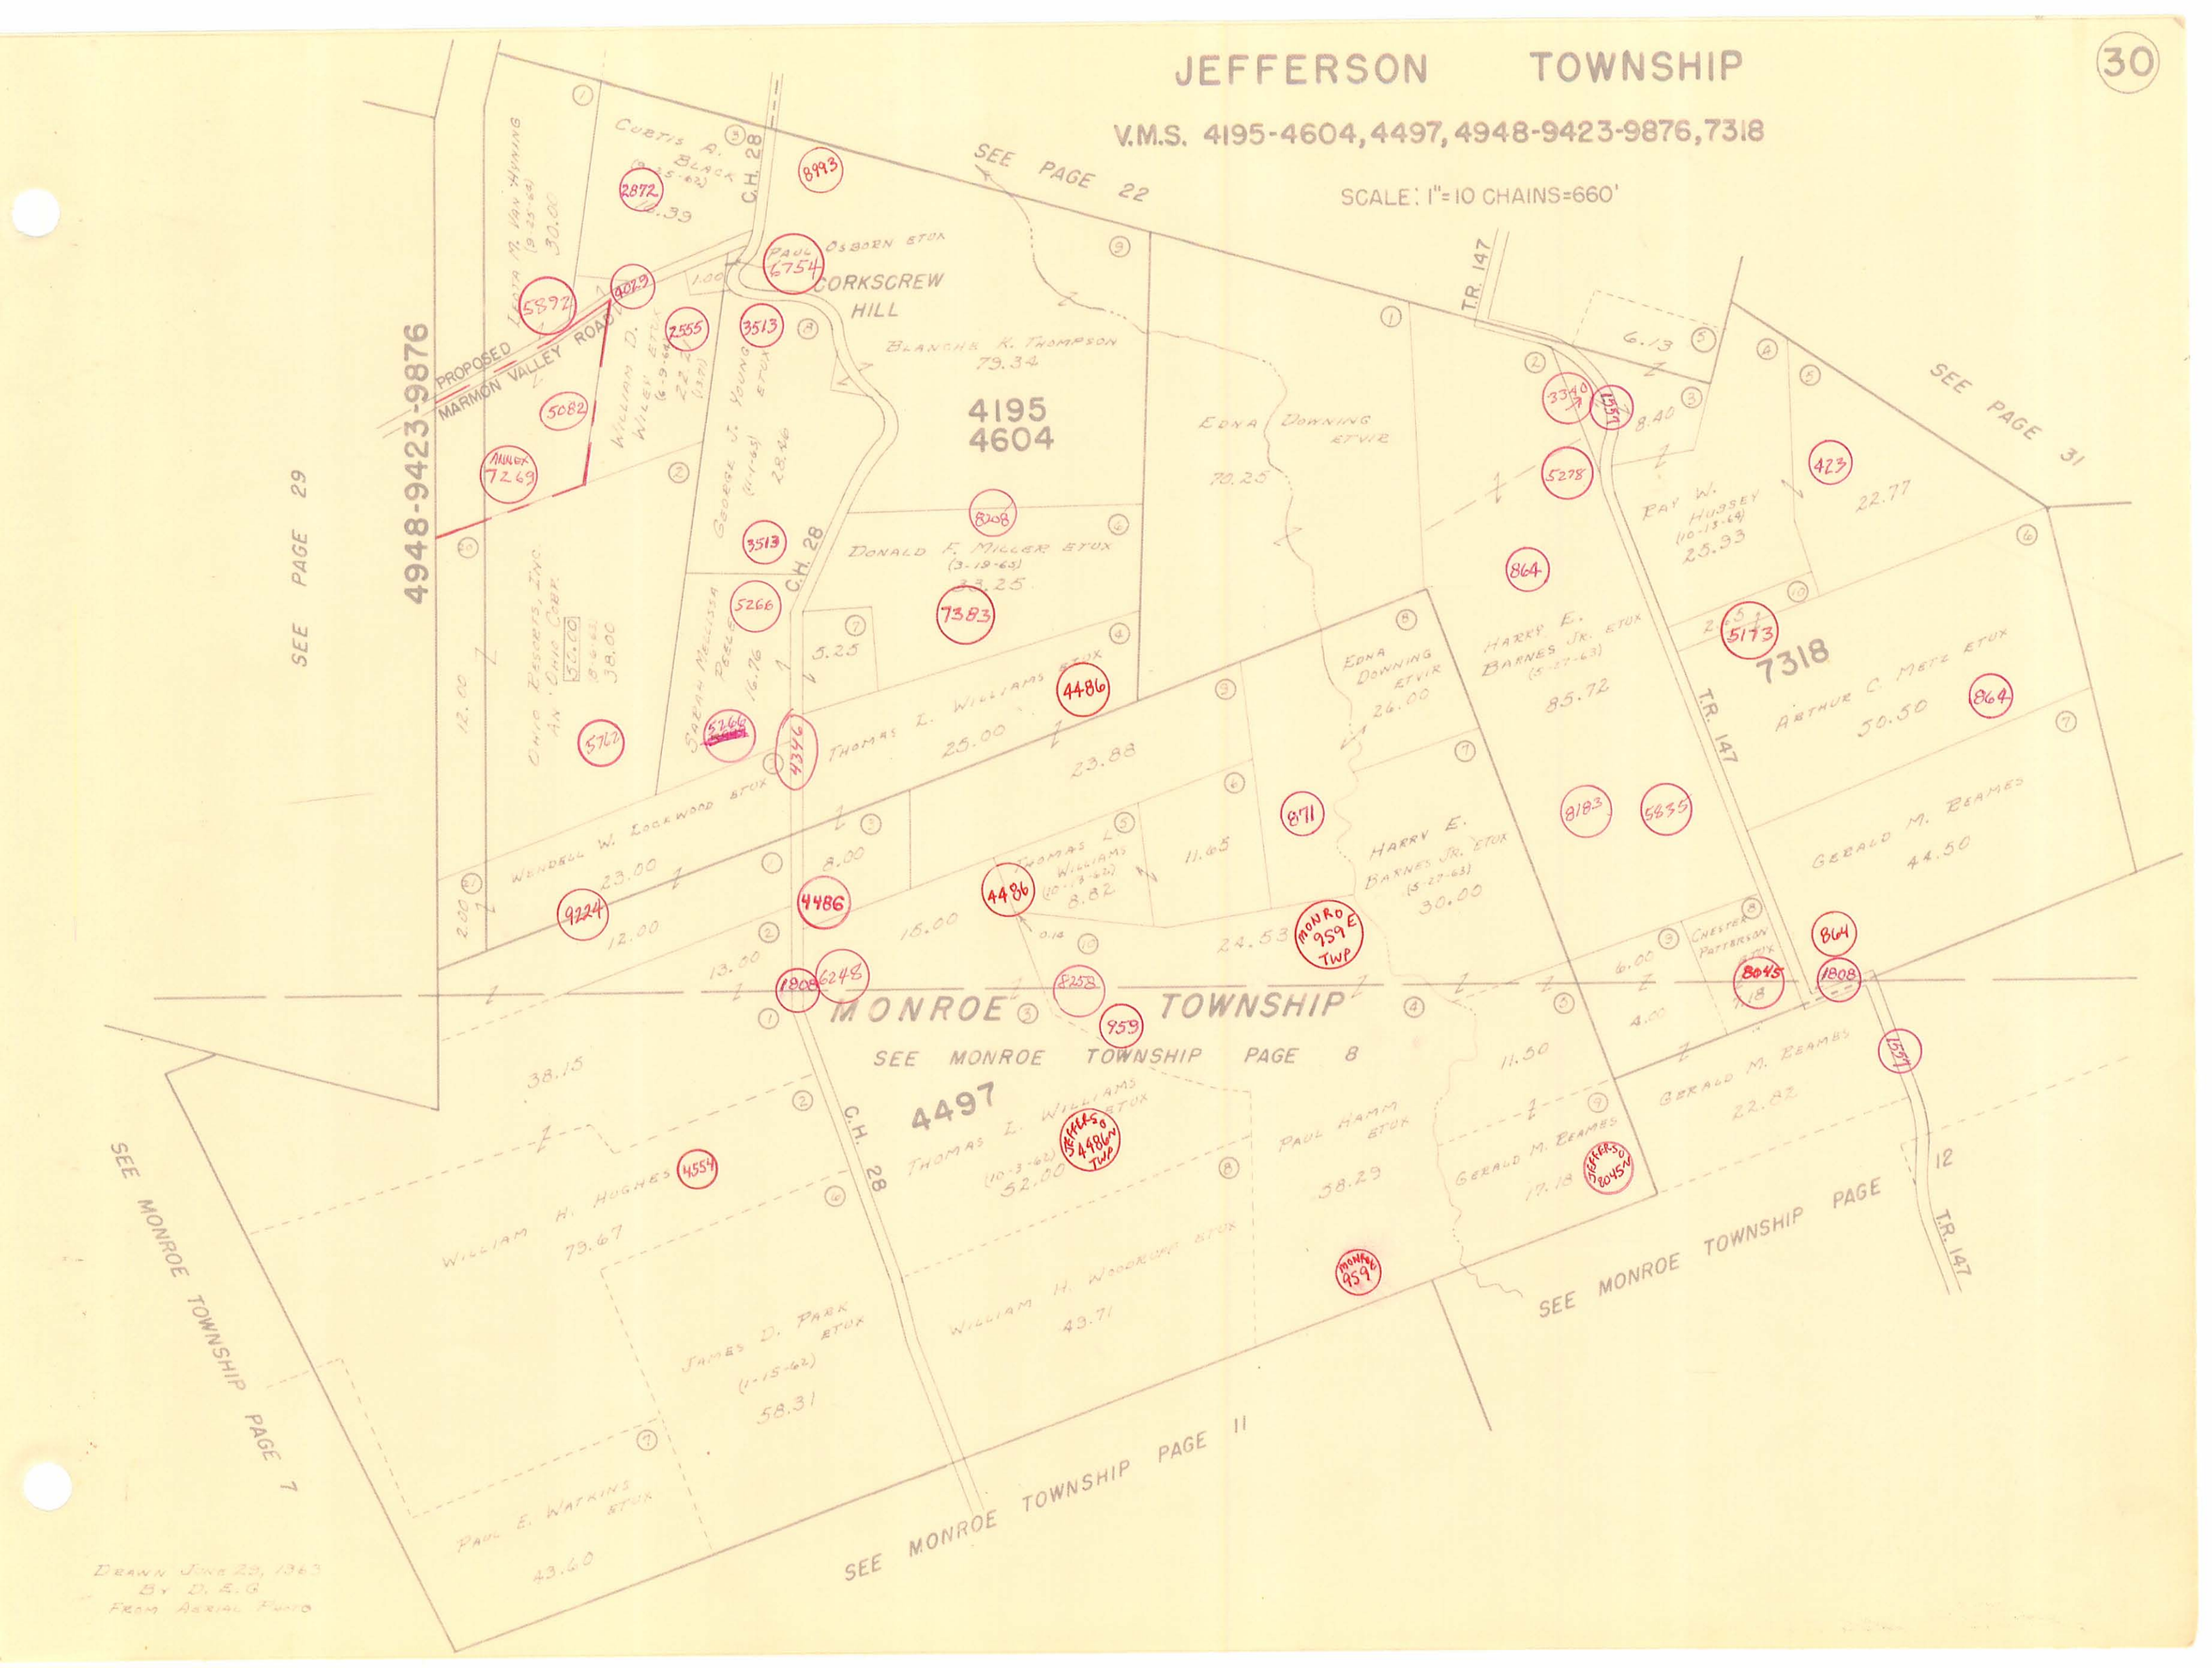

JEFFERSON TOWNSHIP
30
V.M.S. 4195-4604, 4497, 4948-9423-9876, 7318
SCALE: 1"=10 CHAINS=660'
SEE PAGE 22
SEE PAGE 29
SEE PAGE 31
4948-9423-9876
PROPOSED MARMON VALLEY ROAD
CORKSCREW HILL
4195
4604
7318
4497
MONROE TOWNSHIP
SEE MONROE TOWNSHIP PAGE 8
SEE MONROE TOWNSHIP PAGE 7
SEE MONROE TOWNSHIP PAGE 11
SEE MONROE TOWNSHIP PAGE 12
C.H. 28
T.R. 147
Curtis A. Black
Paul Osborn etux
Blanche K. Thompson 79.34
Edna Downing etvir 70.25
Donald F. Miller etux (3-19-63) 33.25
Thomas L. Williams etux 25.00
Wendell W. Lockwood etux 23.00
Harry E. Barnes Jr. etux (5-27-63) 85.72
Ray W. Hussey (10-13-64) 25.93
Arthur C. Metz etux 50.50
Gerald M. Reames 44.50
Chester Patterson etux
Thomas L. Williams (10-3-62) 52.00
Paul Hamm etux 58.29
William H. Hughes 79.67
James D. Park etux (1-15-62) 58.31
William H. Woodruff etux 49.71
Paul E. Watkins etux 43.60
Drawn June 29, 1963
By D.E.G.
From Aerial Photo