


LIBERTY TOWNSHIP  
 SECTION 28 TOWN 5 RANGE 13  
 SCALE 10 CHAINS TO THE INCH

SEE PAGE 7

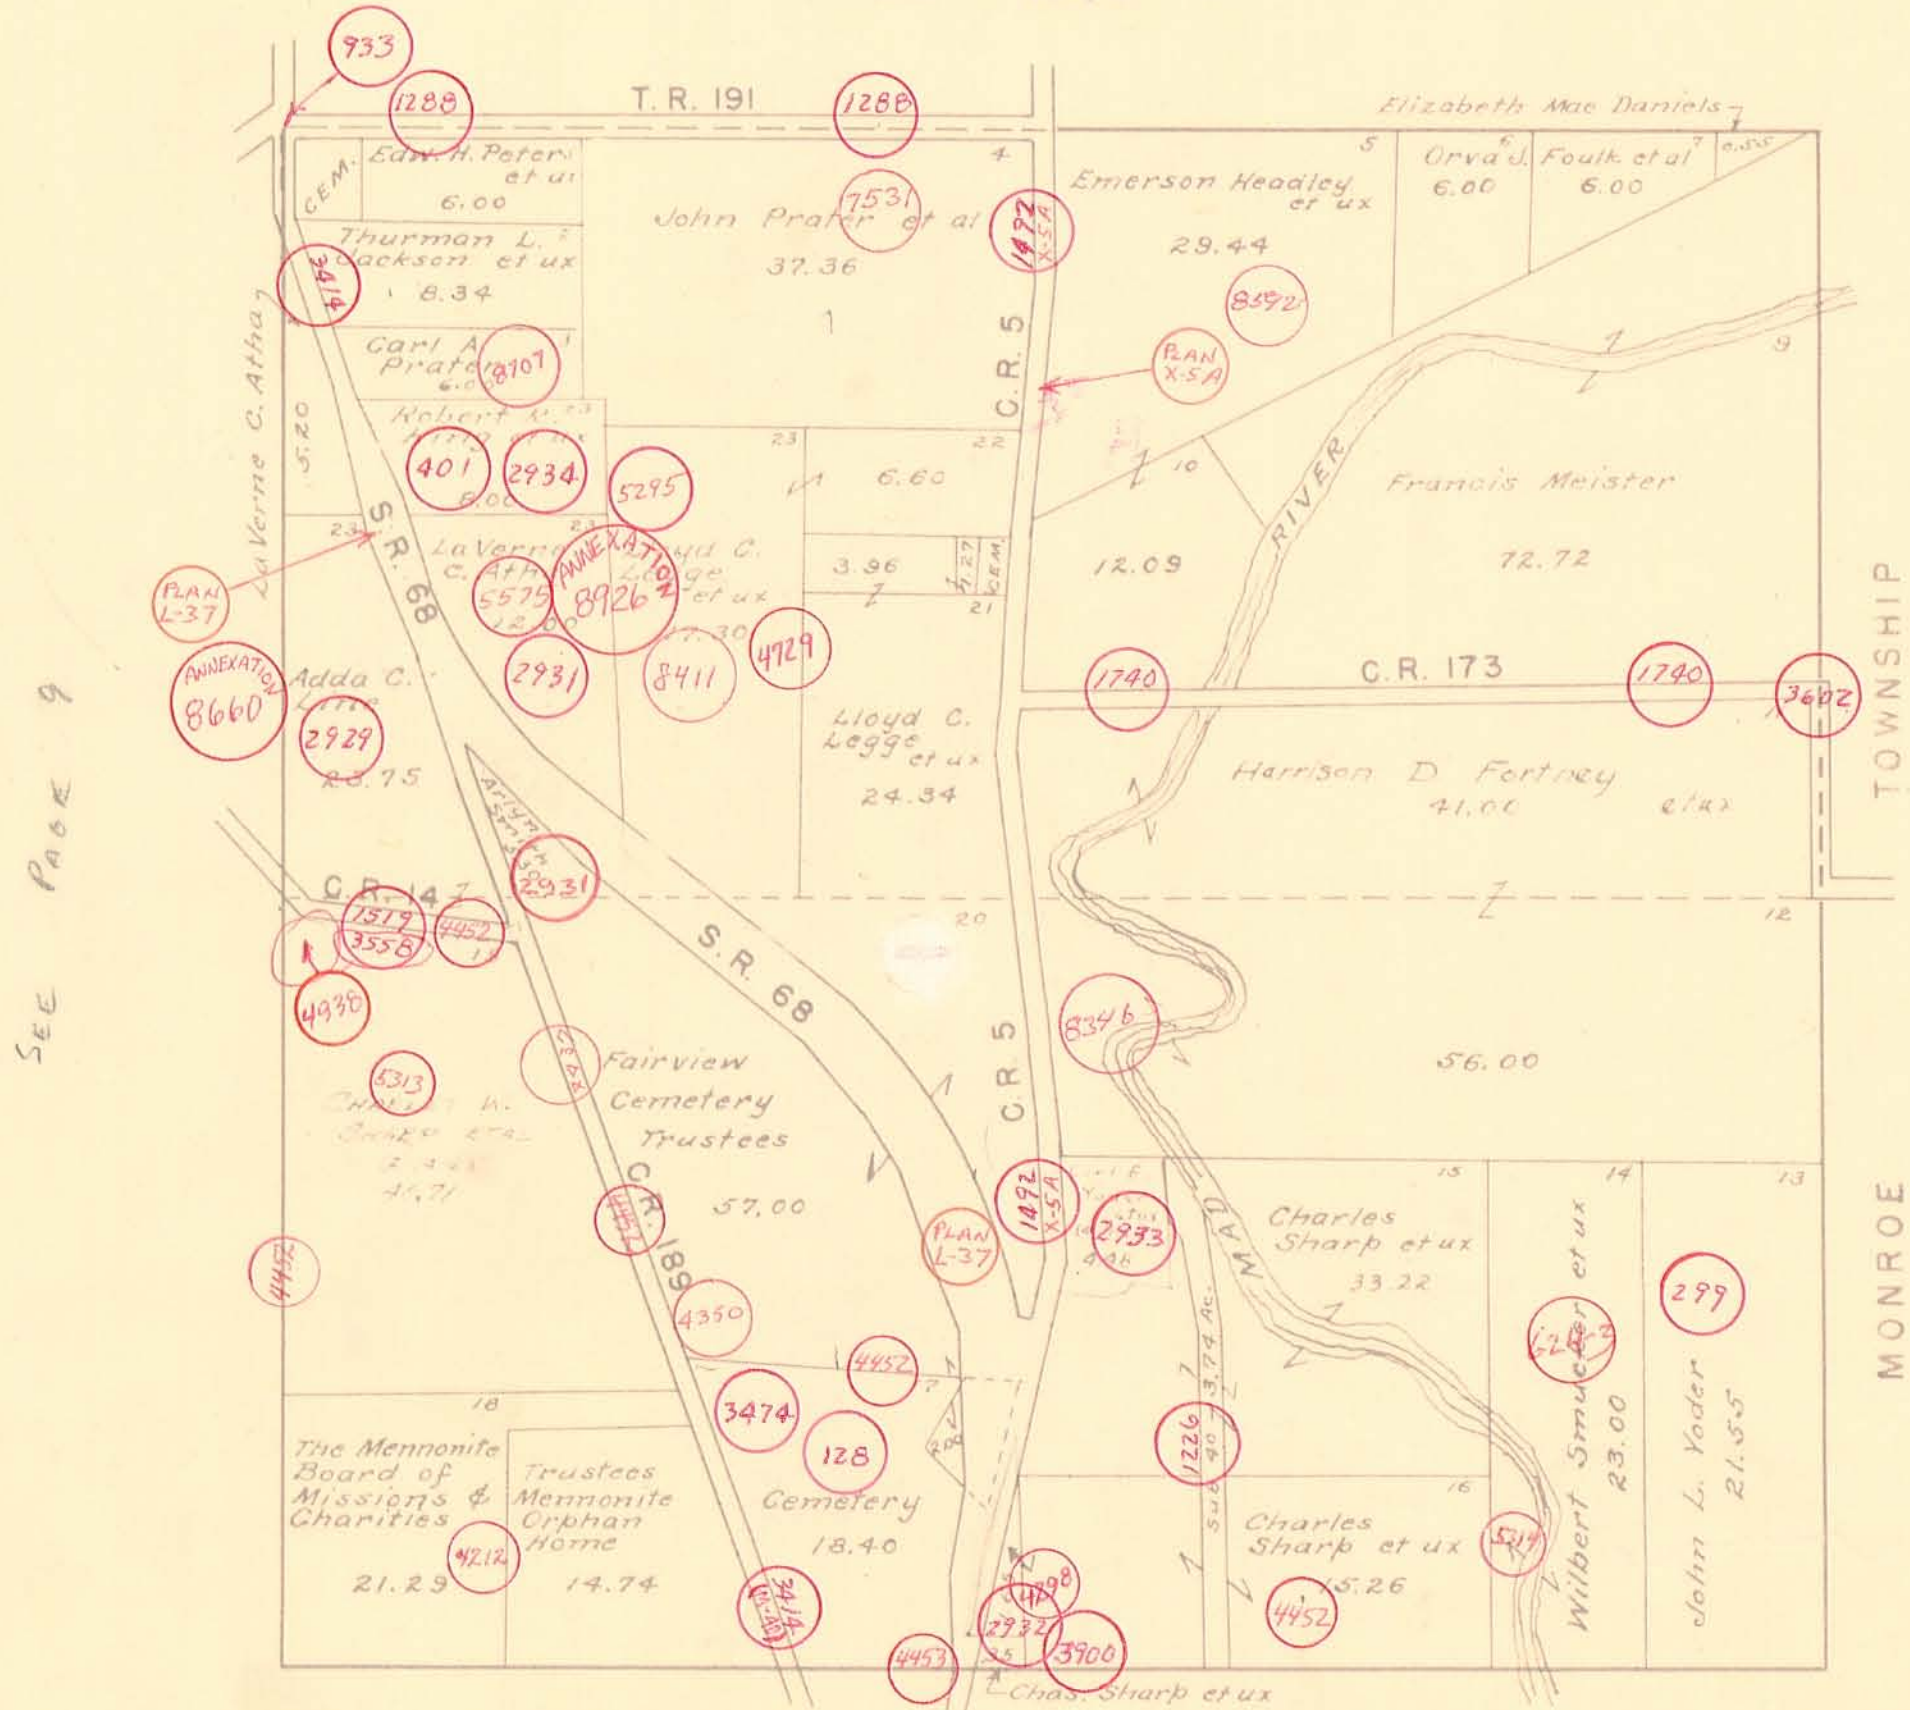

SEE PAGE 11