


LIBERTY TOWNSHIP
WEST LIBERTY CORPORATION

SCALE 200 FEET TO THE INCH

REPLAT OF ORIGINAL VILLAGE (LOTS 1-75)

See Page 14

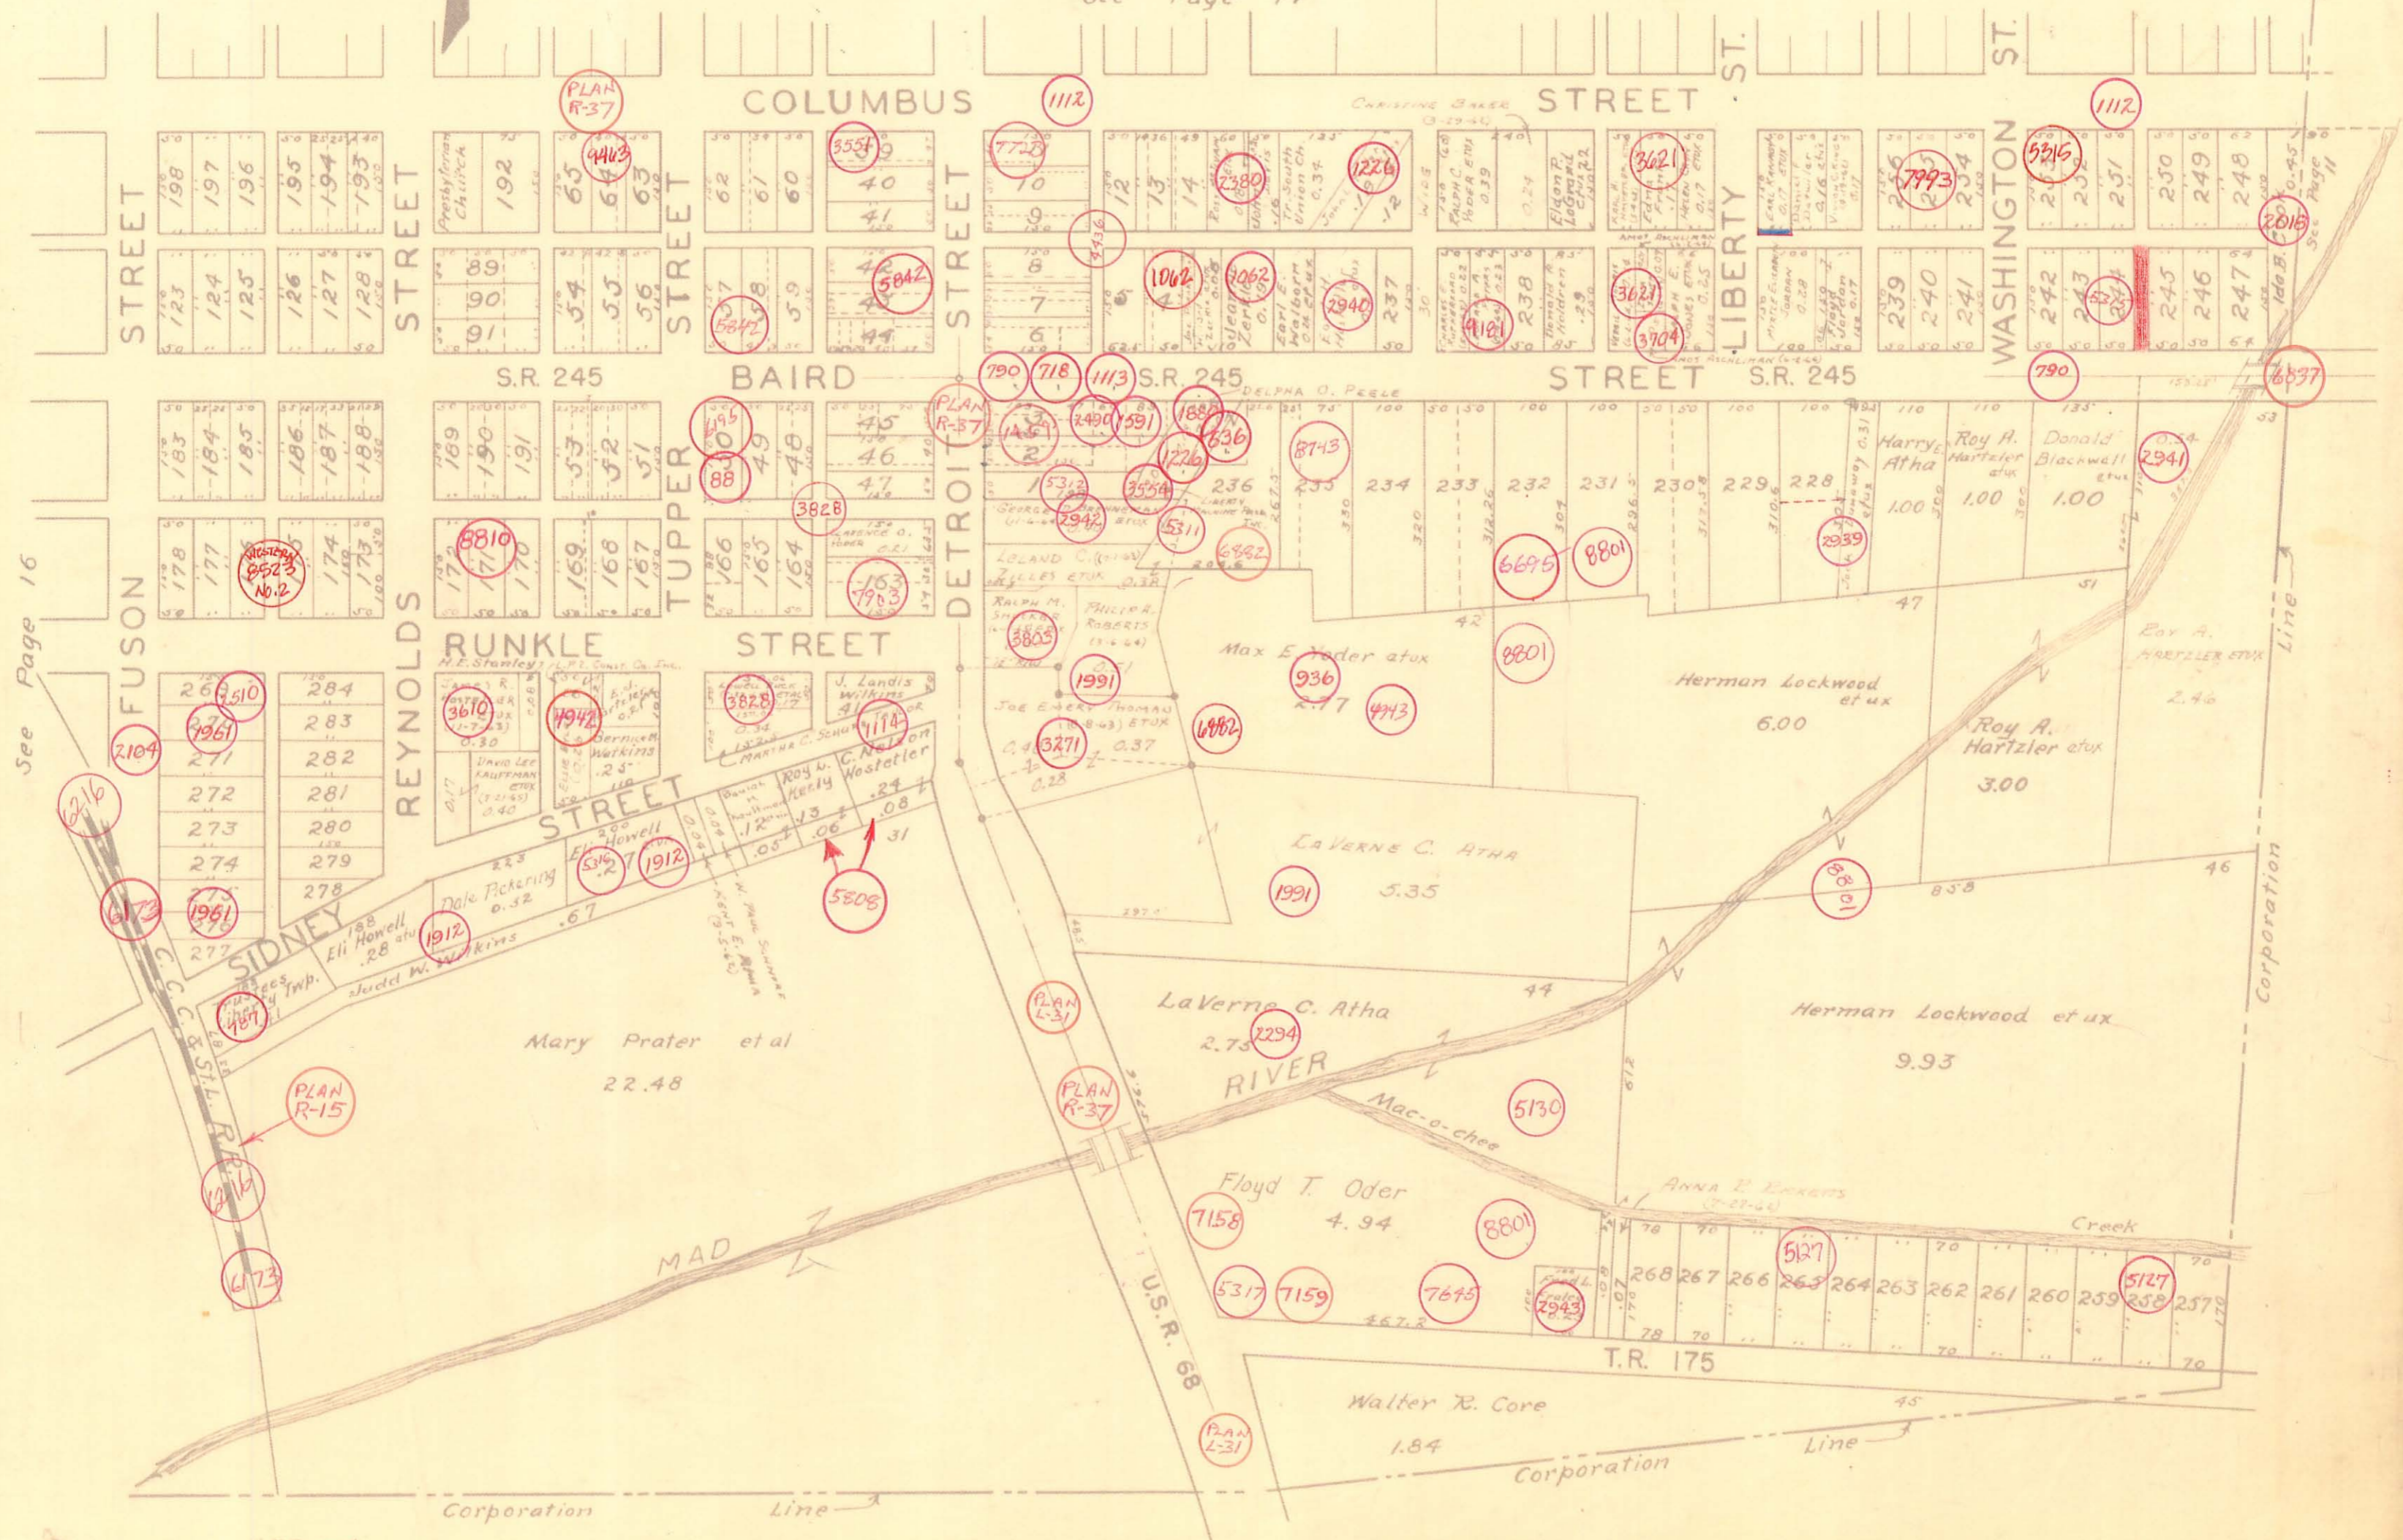

See Page 16