


McARTHUR TOWNSHIP
 SECTION 17 18
 SECTION 19 20 TOWN 7 RANGE 9

SCALE 10 CHAINS TO THE INCH

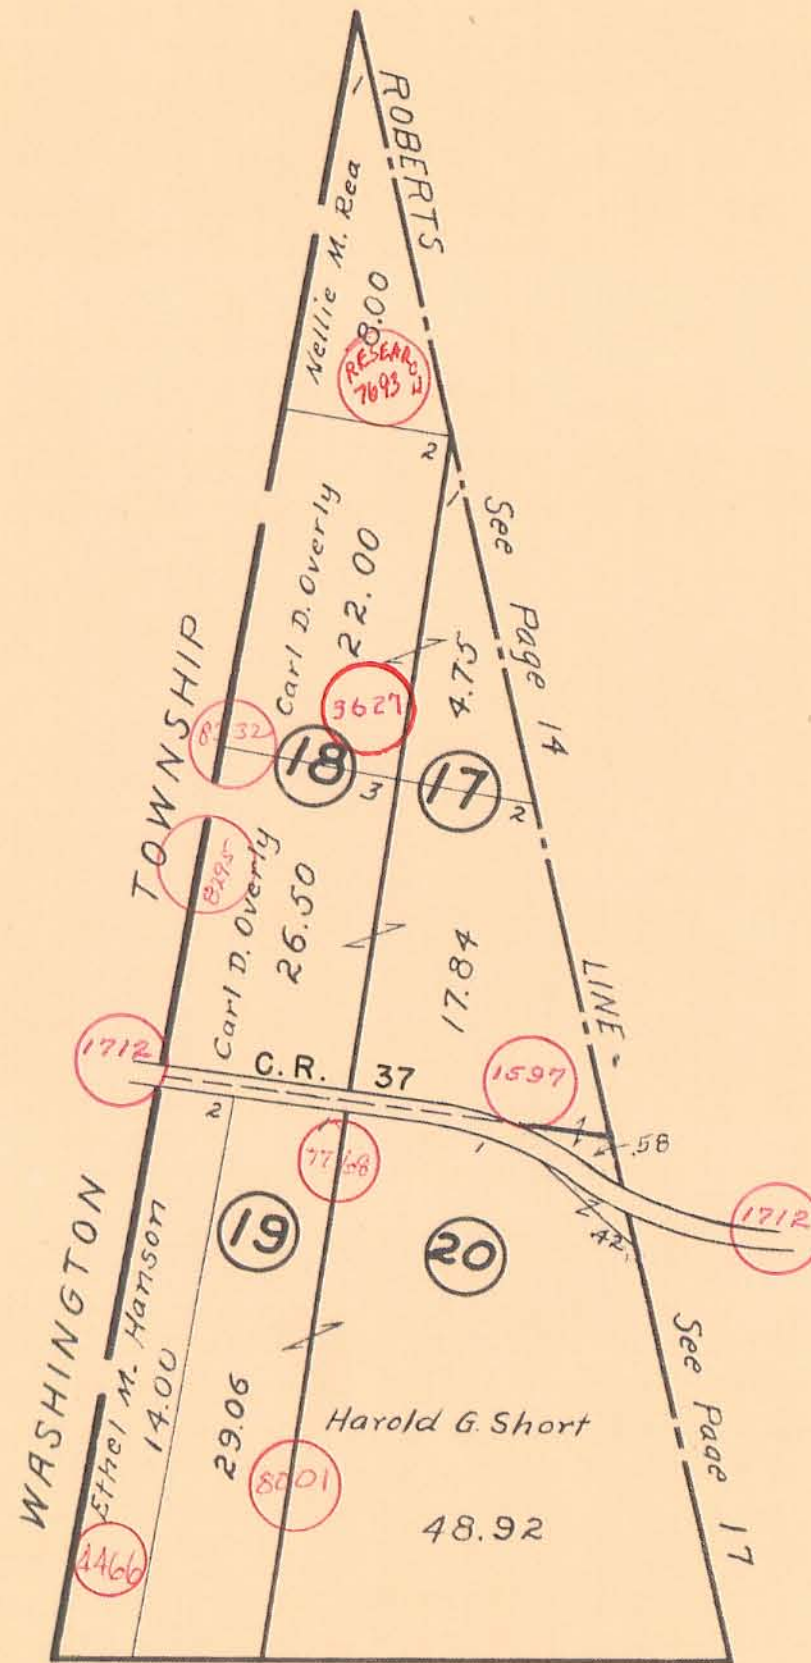

See Page 16