


# MCARTHUR TOWNSHIP

V.M.S 10306 & 10307

SCALE: 1" = 10 CHAINS = 660'

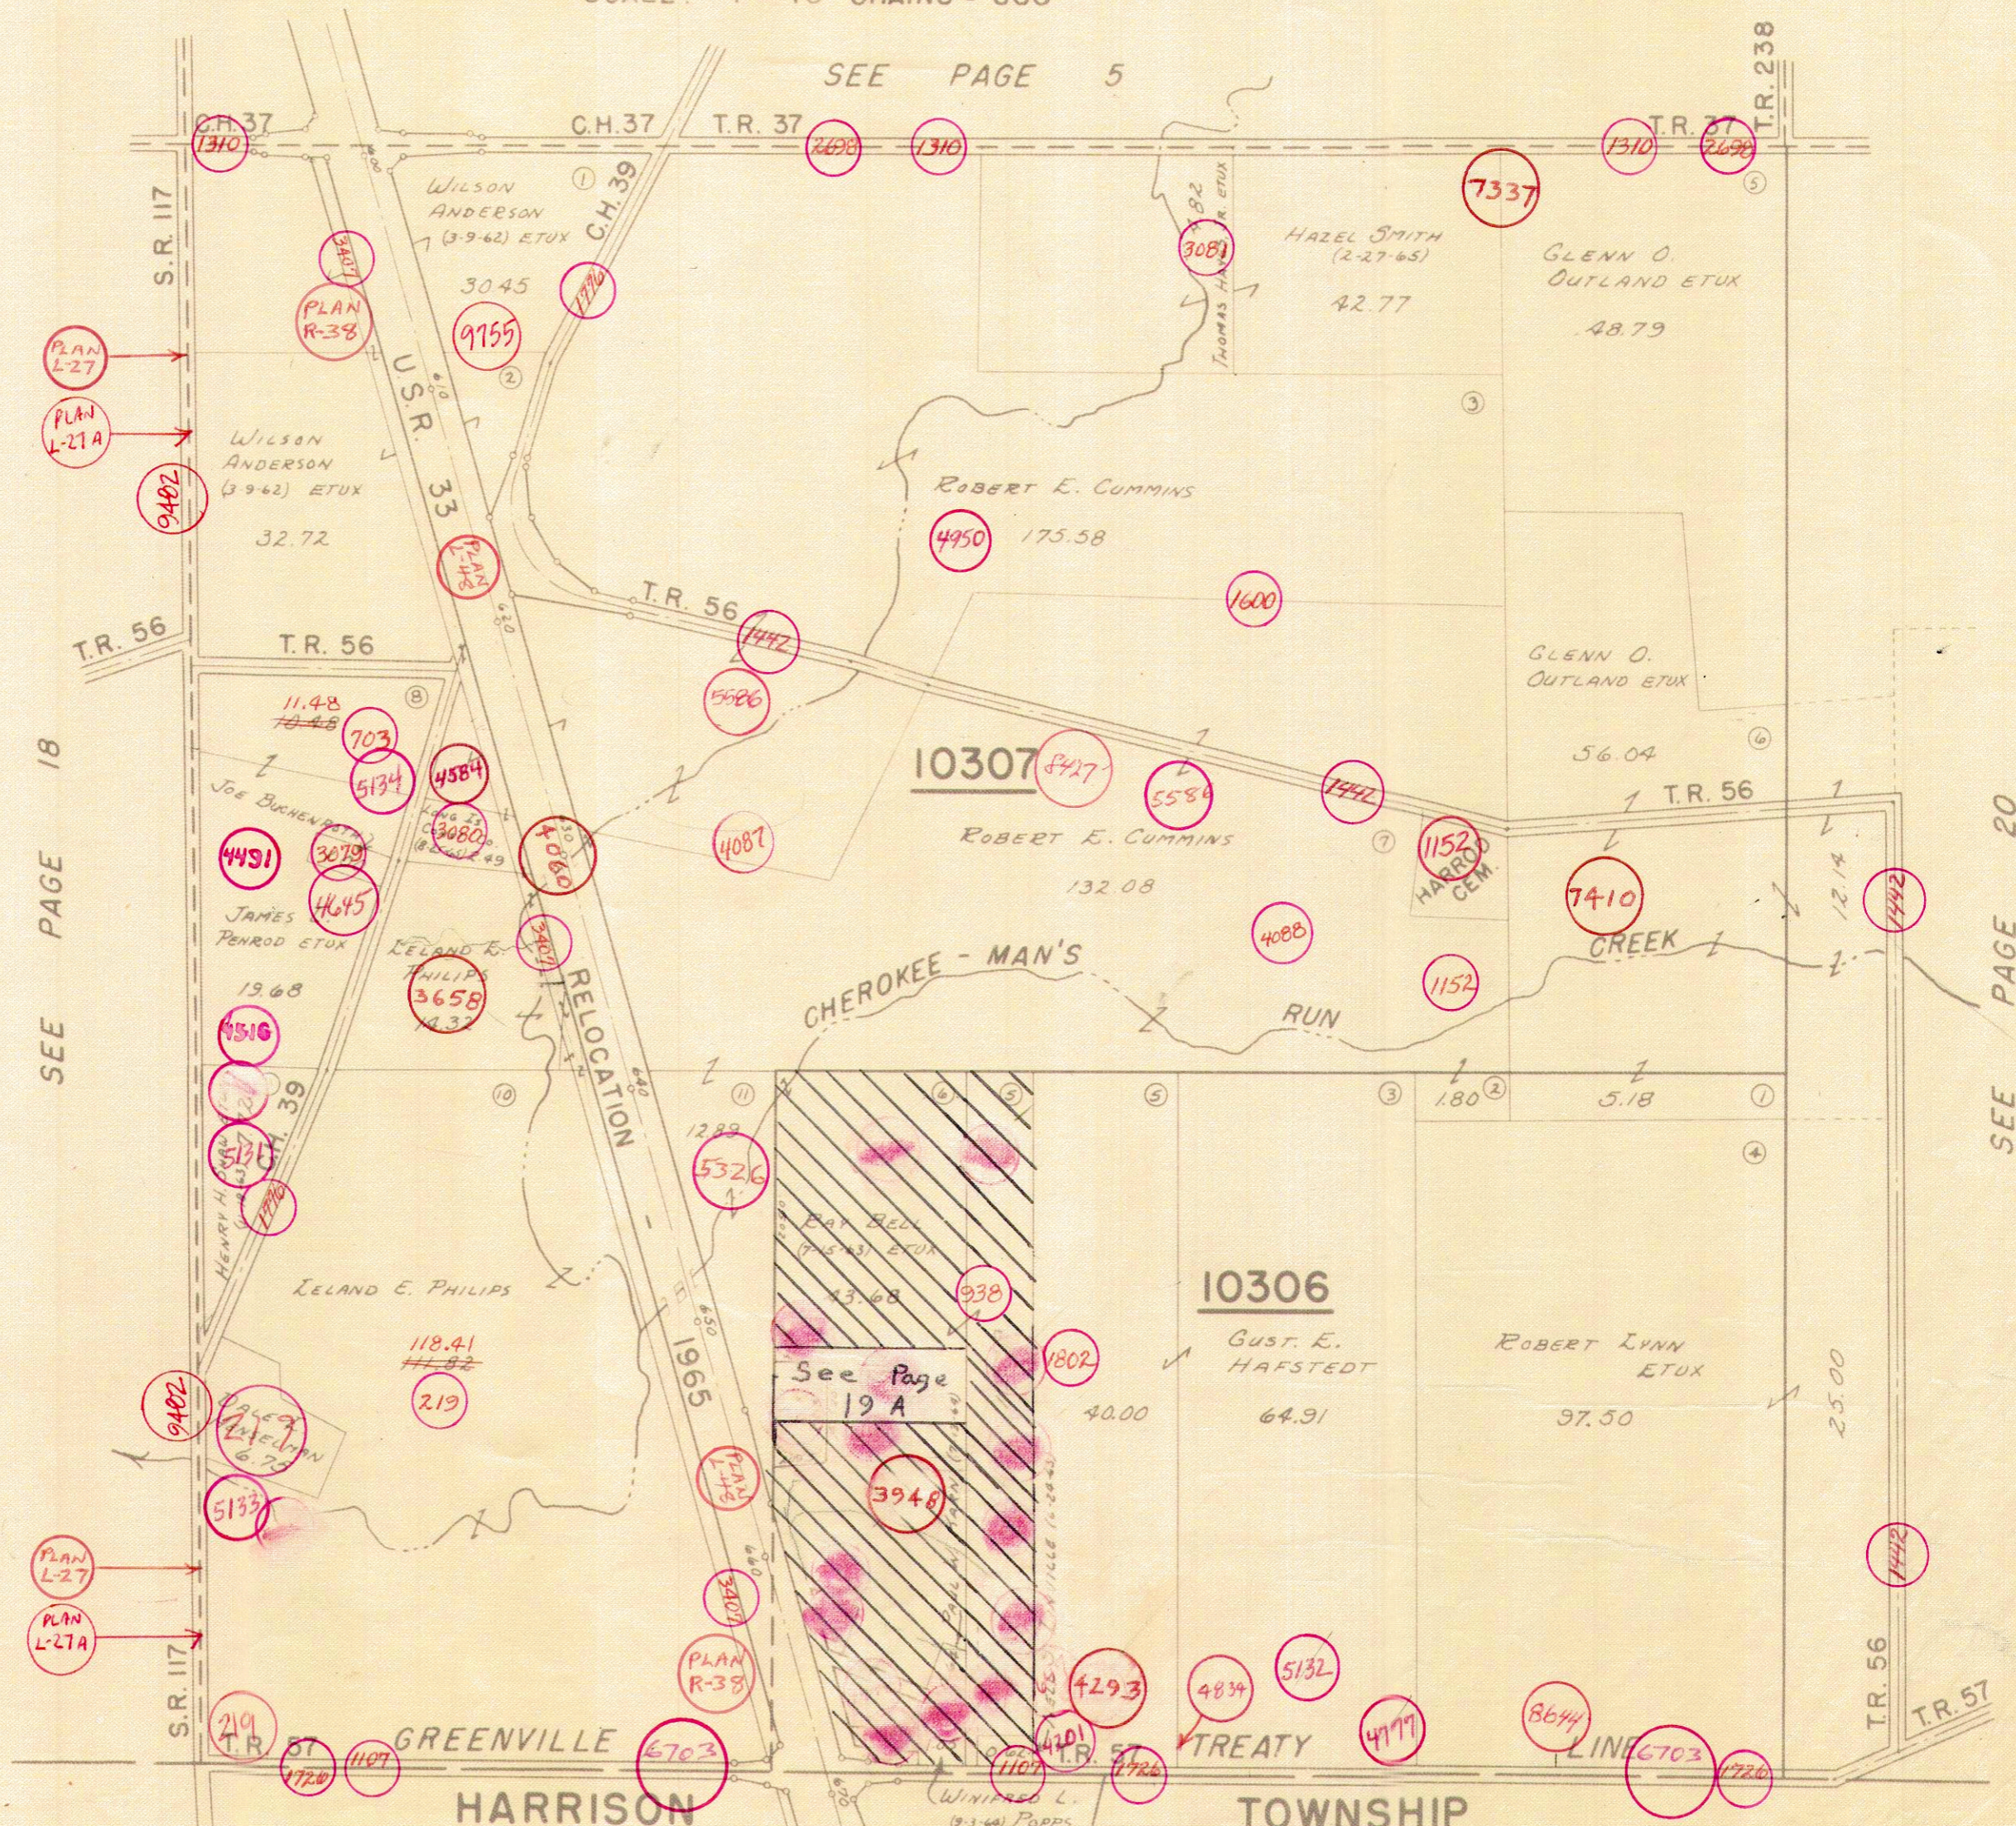

DRAWN: MARCH 23, 1966  
DANIEL E. GILBERT

SEE HARRISON TOWNSHIP PAGE 23

SEE HARRISON TOWNSHIP PAGE 22