


MONROE TOWNSHIP

SEC. 15 & 21 TOWN 5 RANGE 13

SCALE: 1" = 10 CHAINS = 660'

SEE PAGE 31

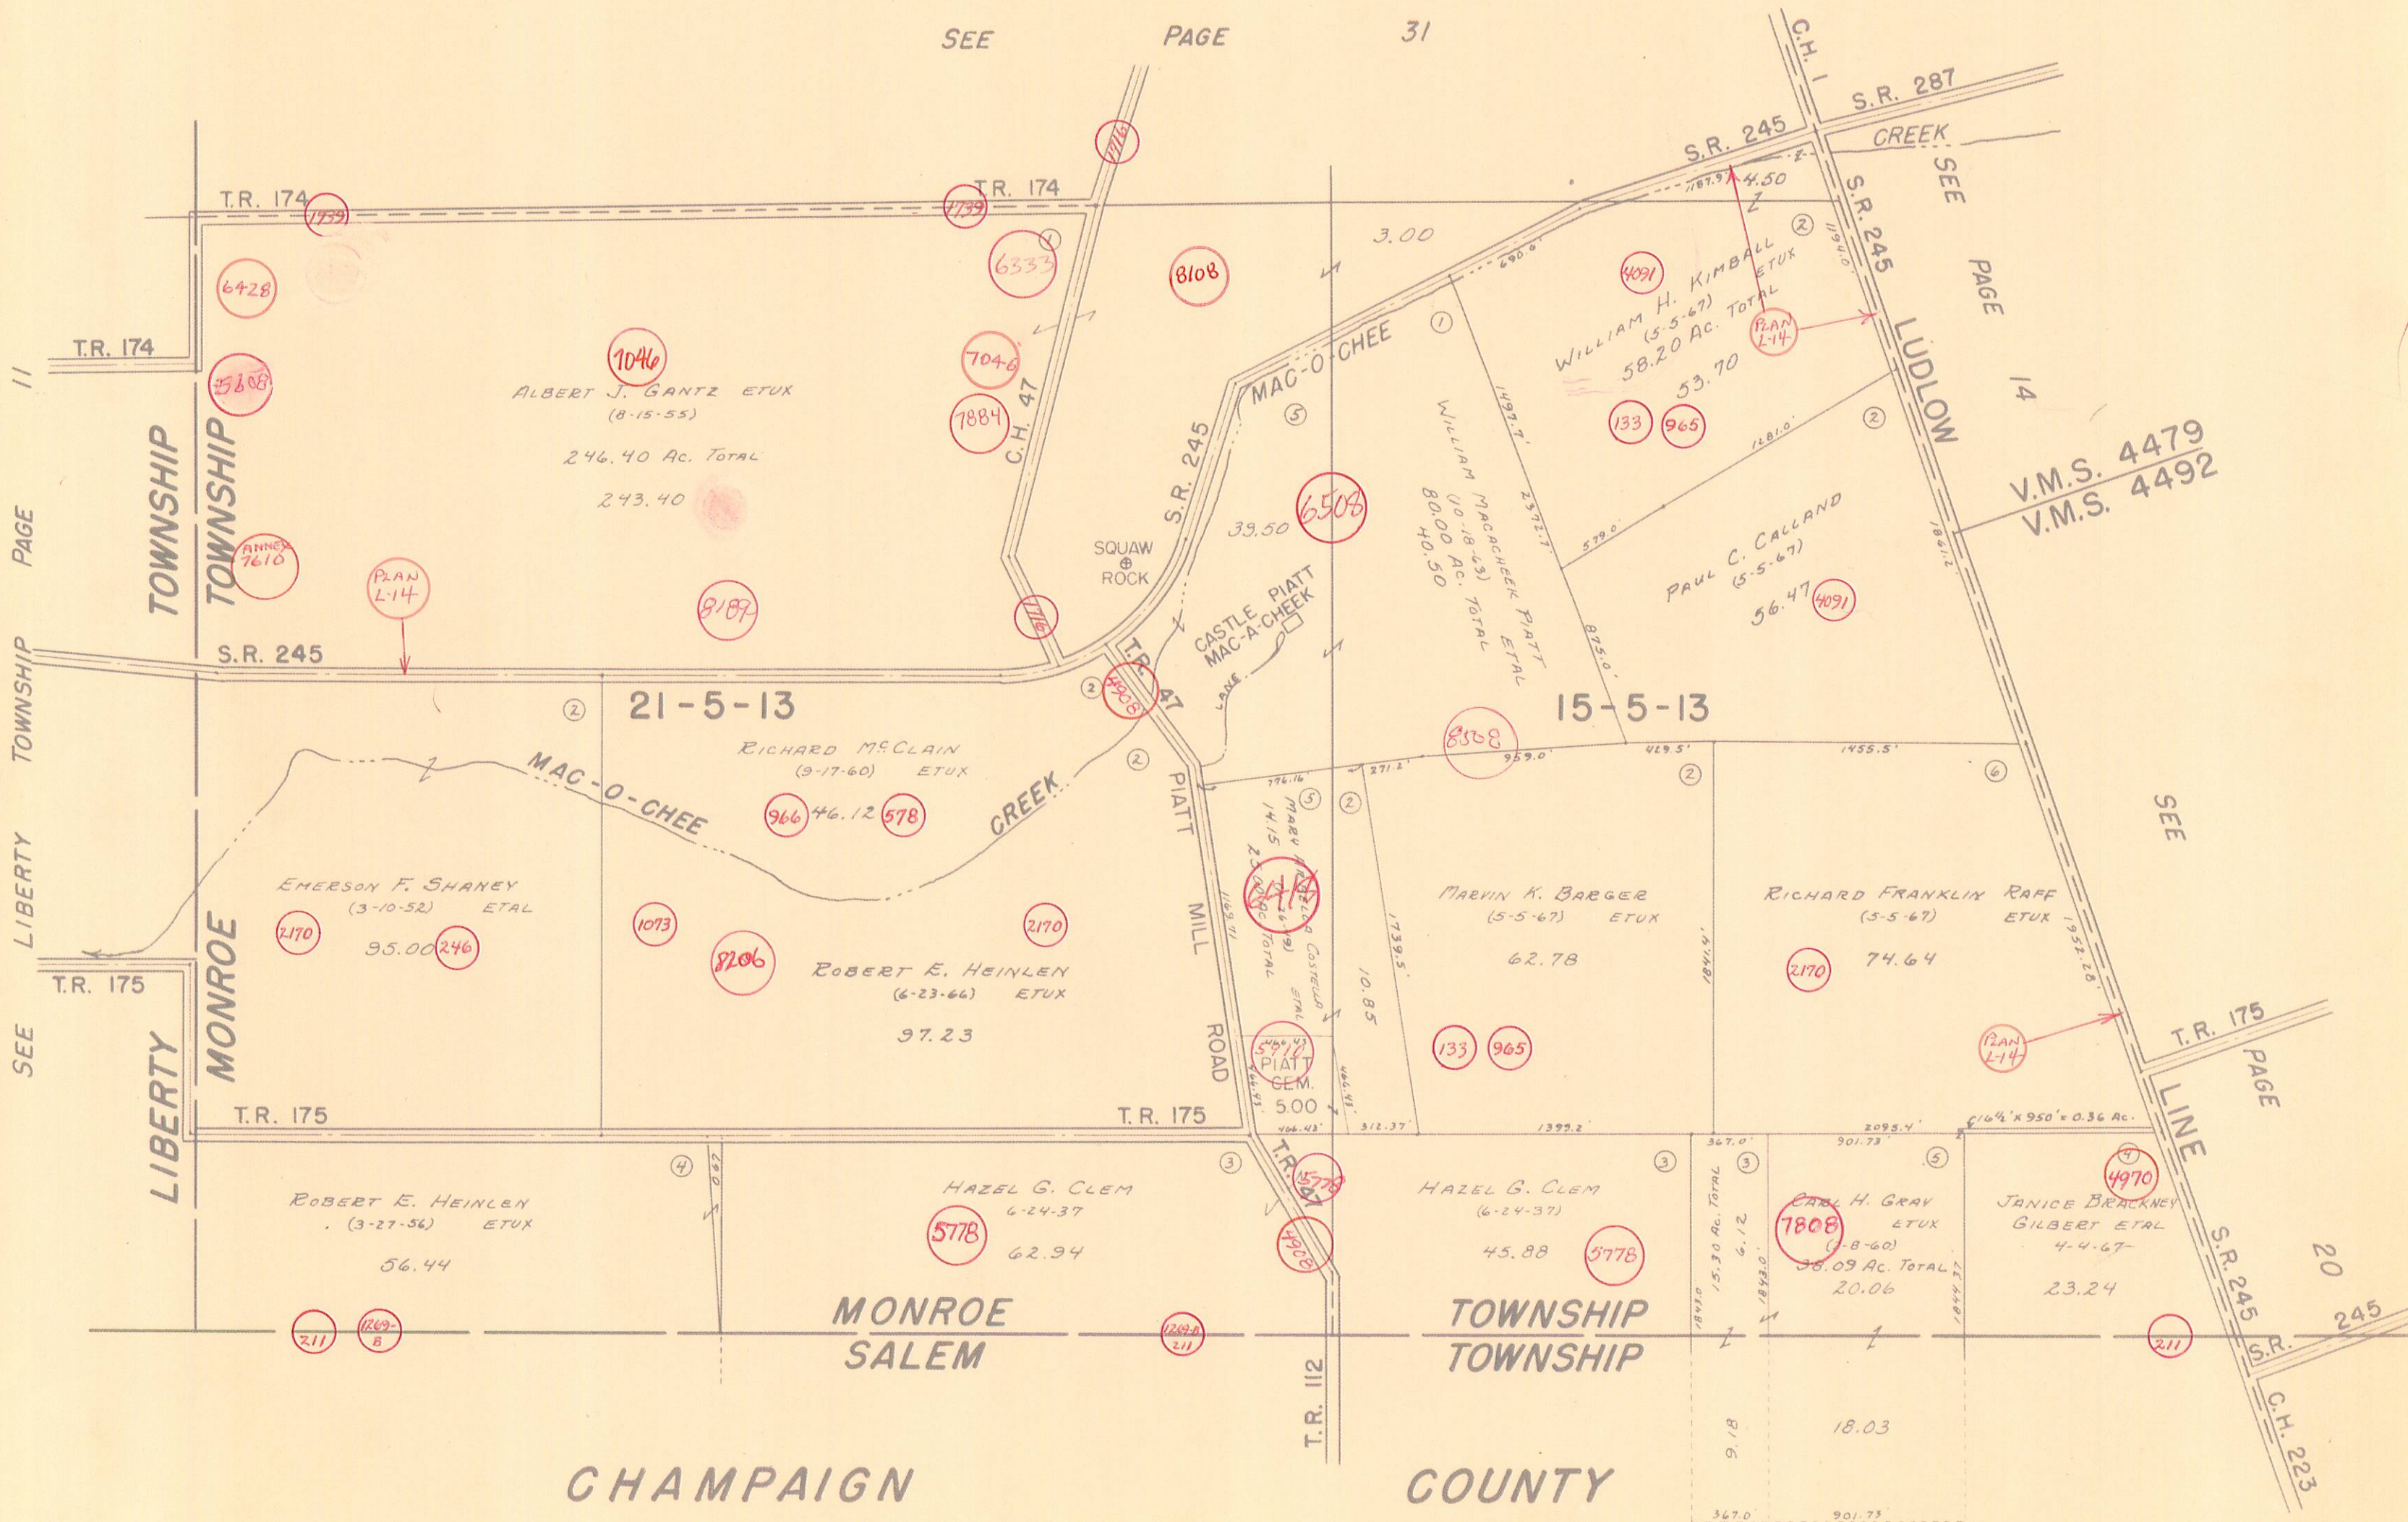

CHAMPAIGN

COUNTY