



NORTH EAST PART EAST LIBERTY

SCALE 200 FEET TO THE INCH

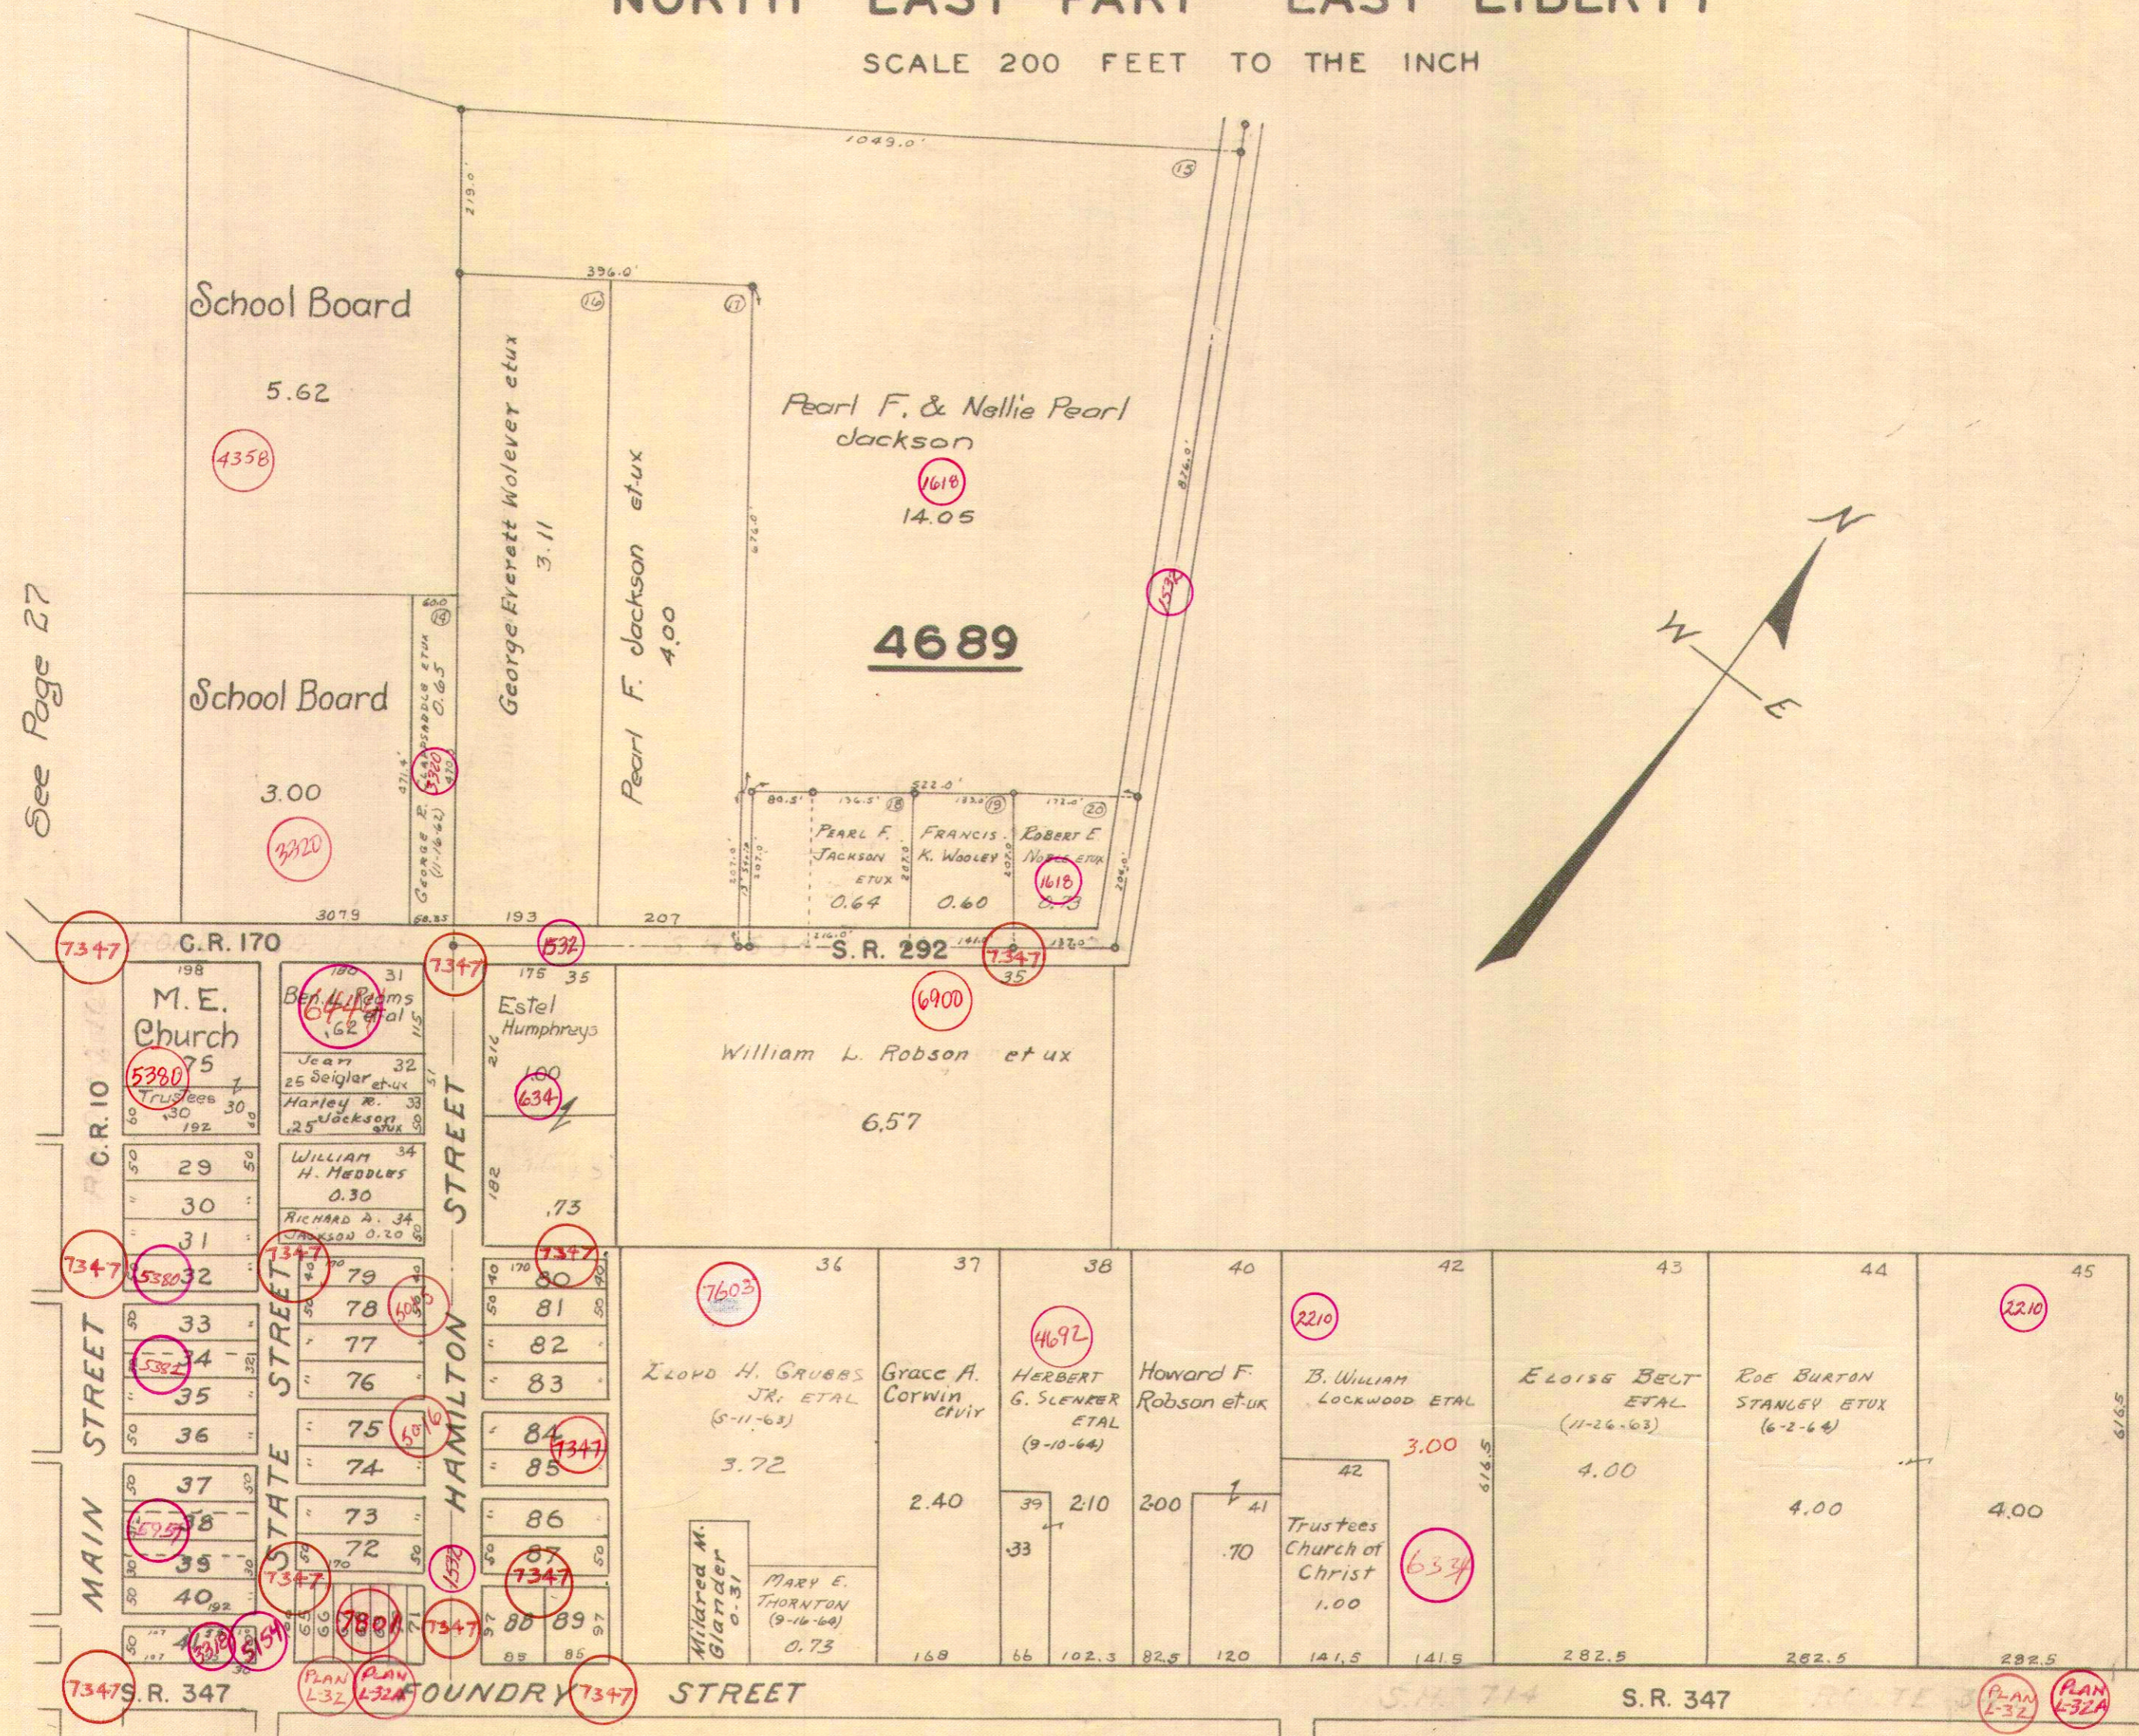

See Page 27

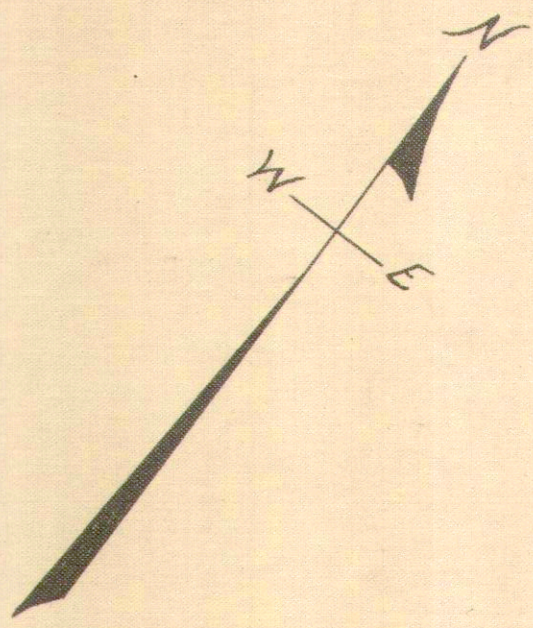

See Page 28

PLAN L-32 PLAN L-32A