


PLEASANT TOWNSHIP
SECTION 9 TOWN 2 RANGE 14

SCALE 10 CHAINS TO THE INCH

See Page 15

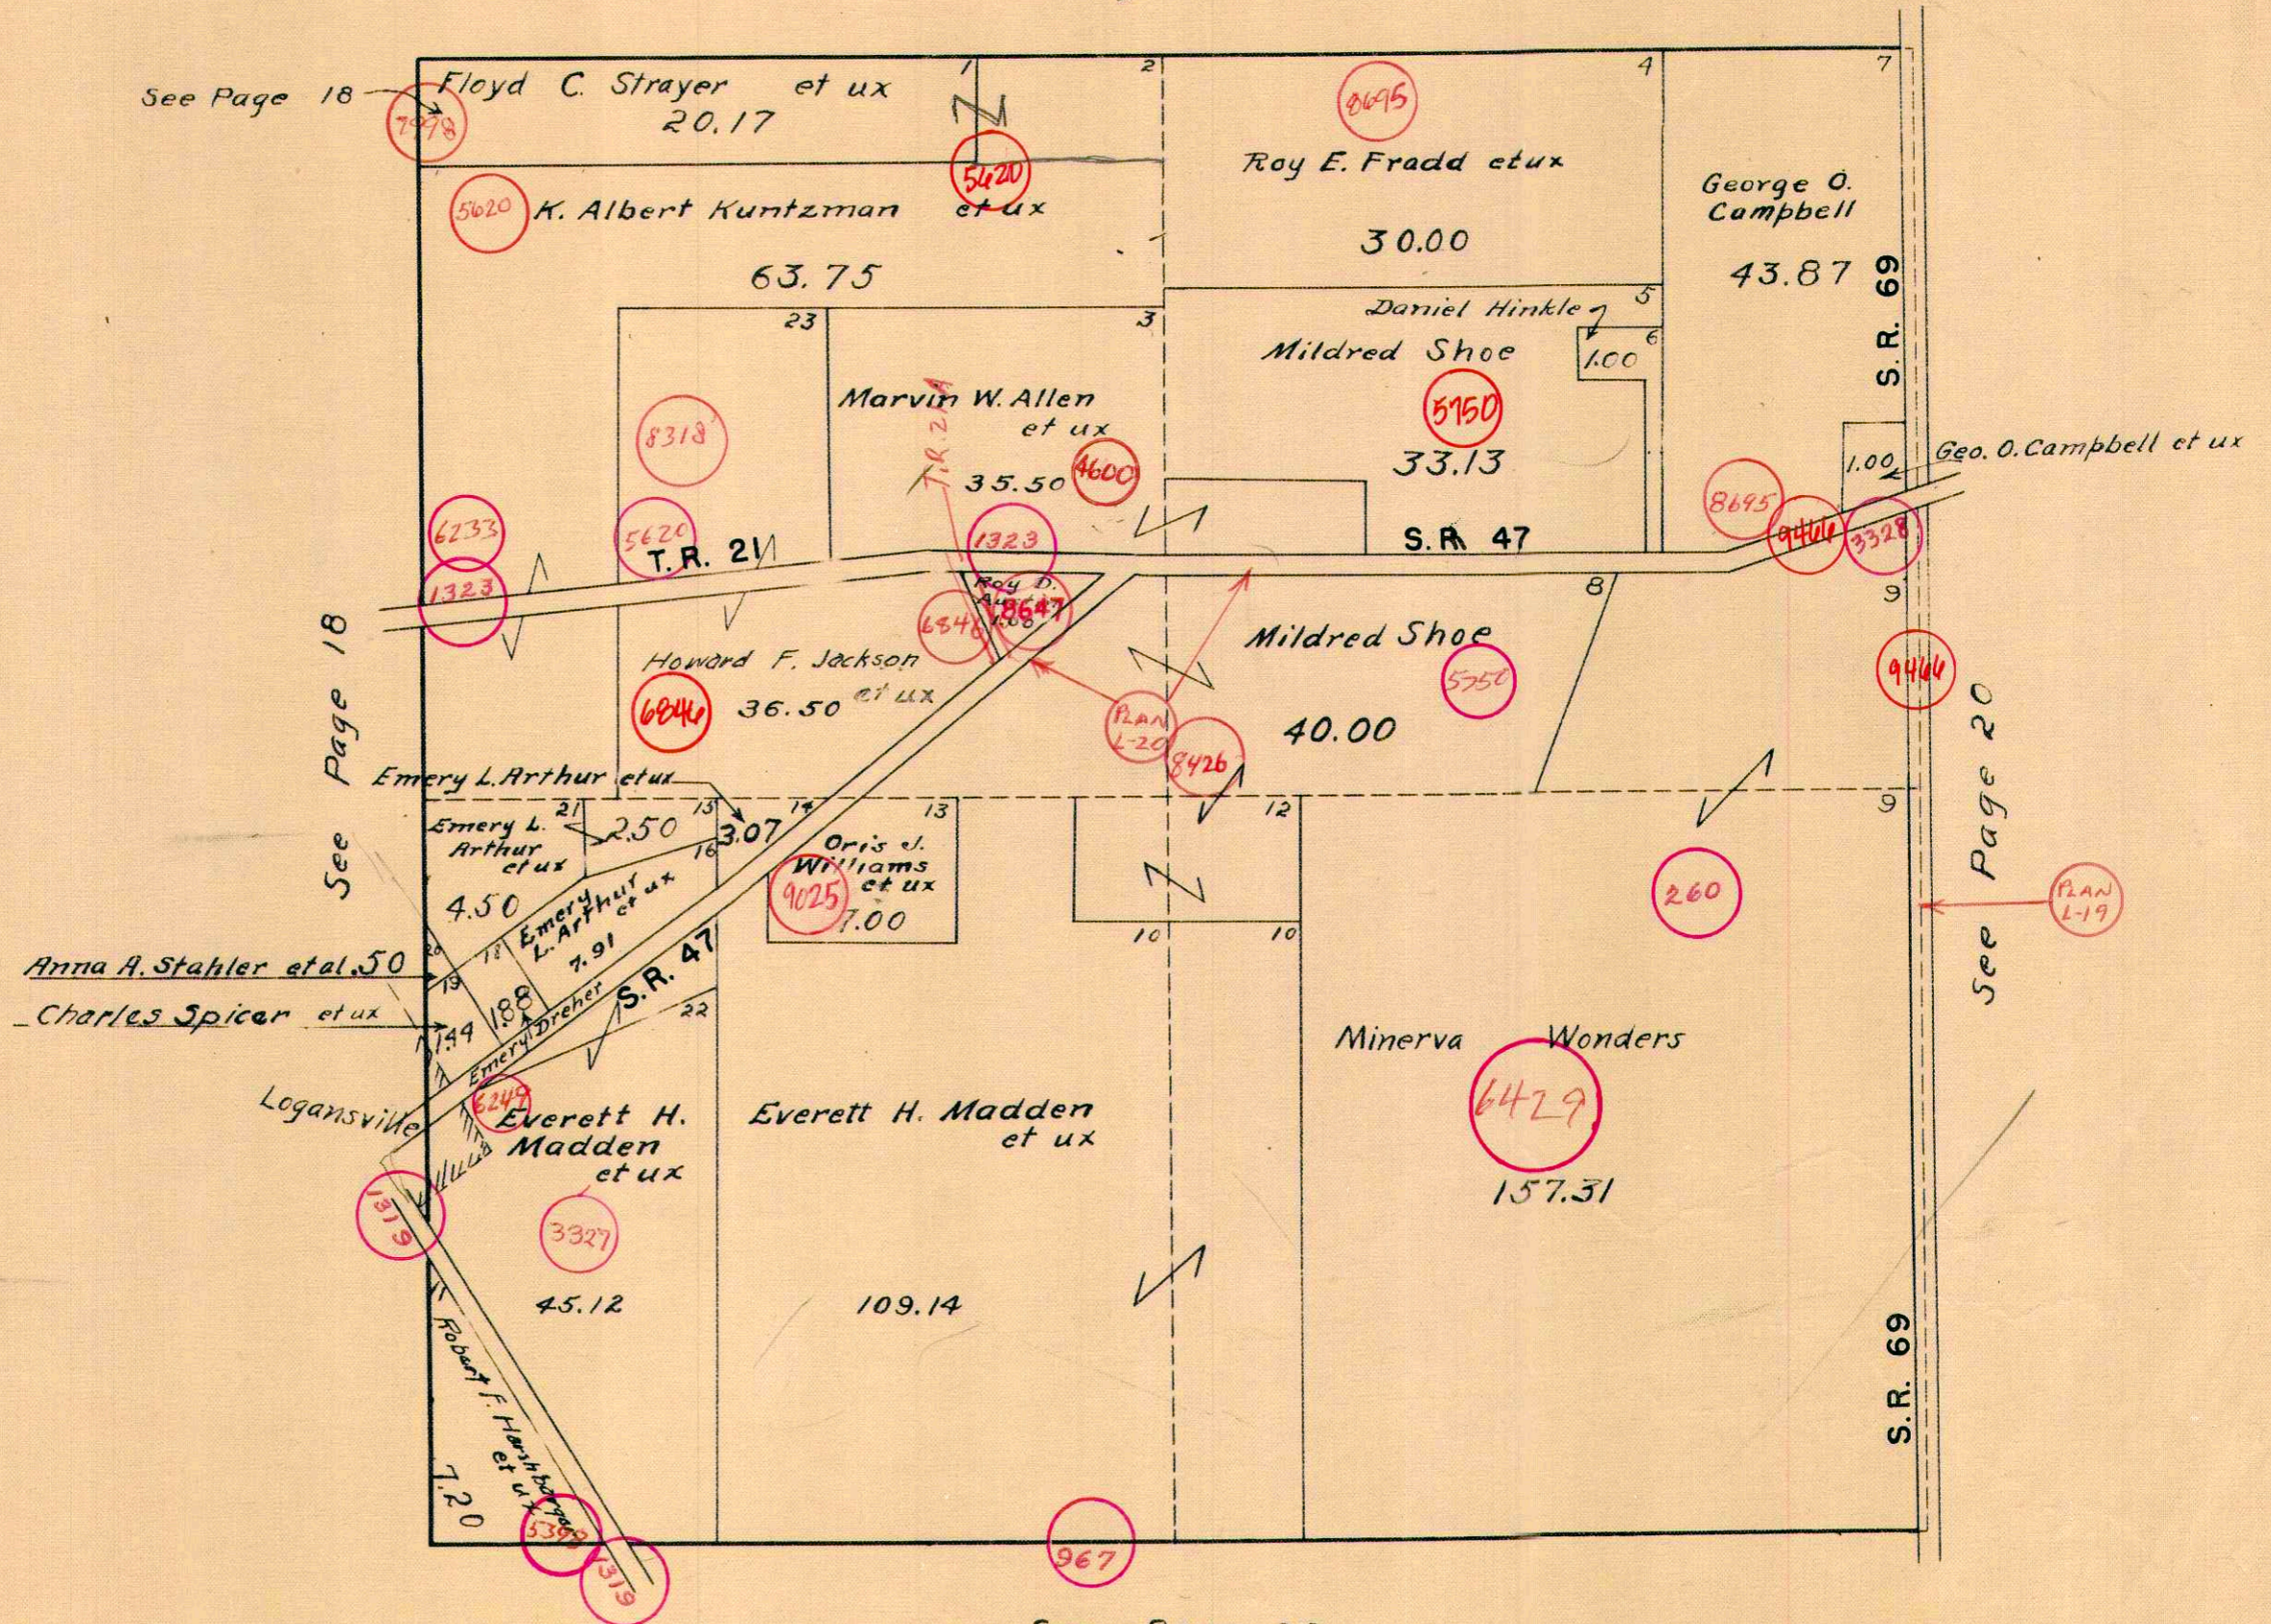

See Page 22