


V. M. S. 13393

6793 Scott Island

FERNWOOD SUBDIVISIONS - LONG ISLAND

SCALE: 1" = 100'

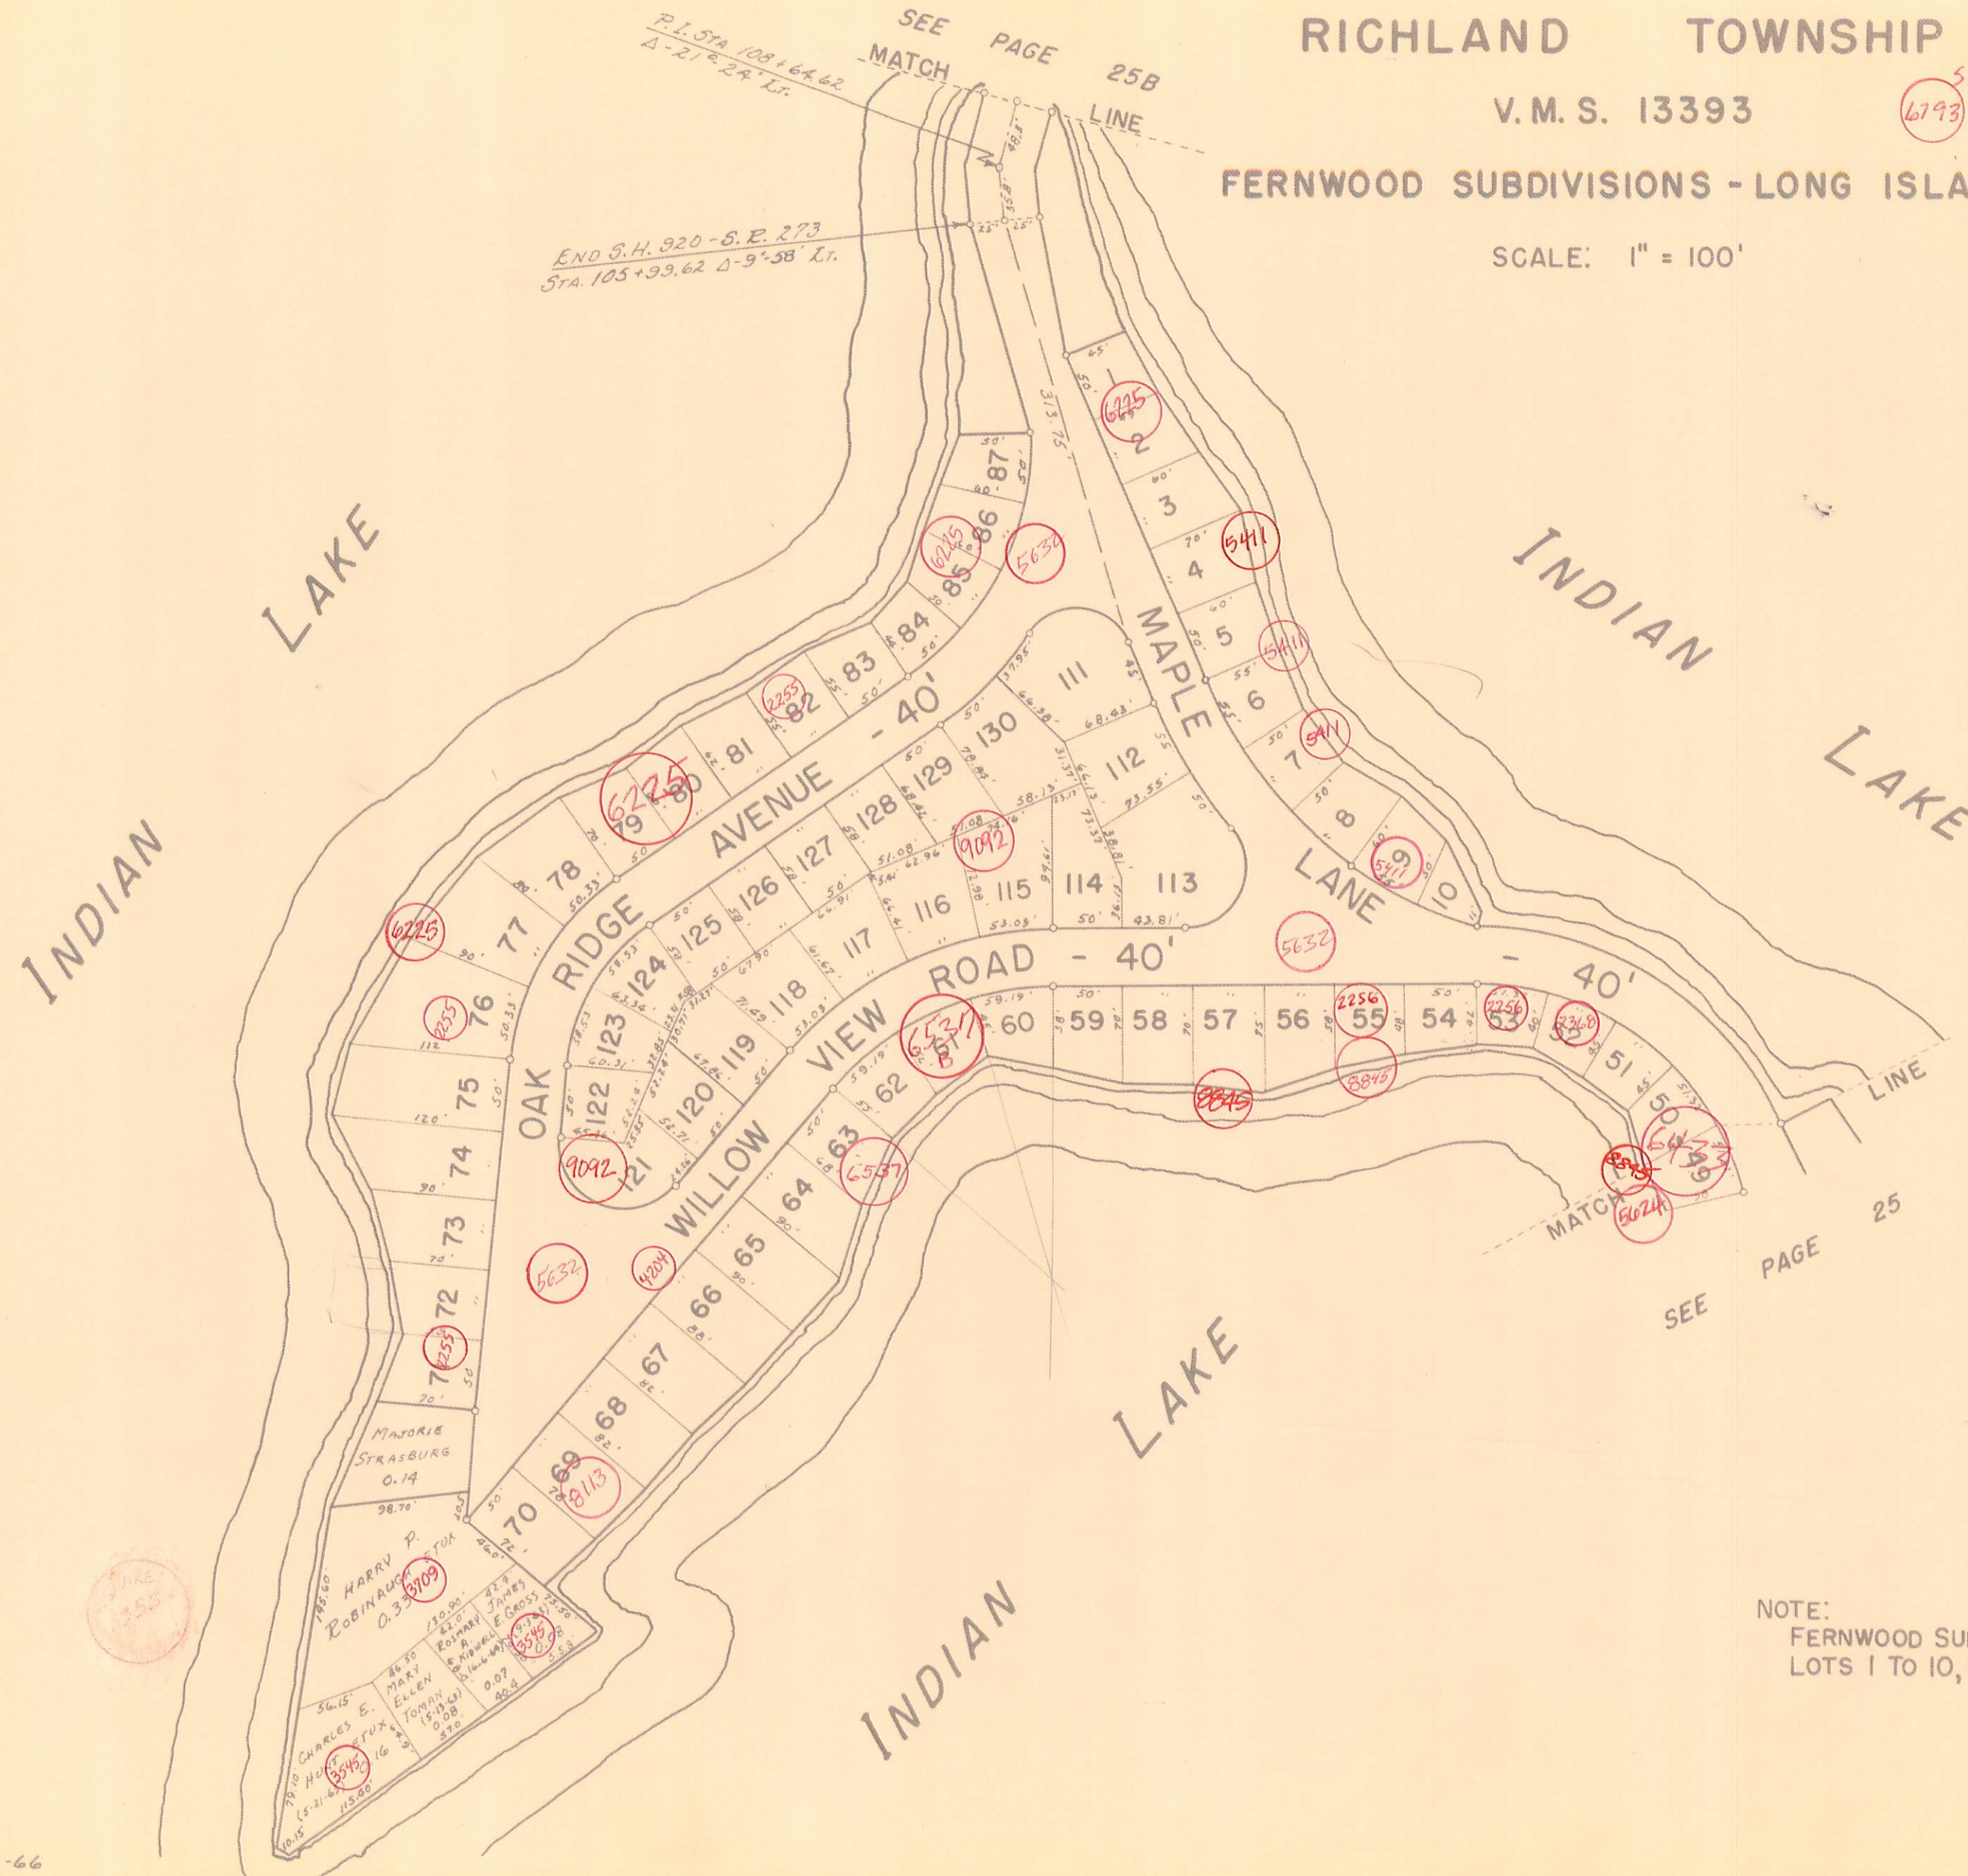

END S.H. 920 - S.E. 273
Sta. 105+93.62 Δ-9°-58' Lt.

SEE PAGE 25B
MATCH LINE

SEE PAGE 25
MATCH LINE

NOTE:
FERNWOOD SUBDIVISION NO. 1.
LOTS 1 TO 10, 50 TO 87, 111 TO 130.