


**RICHLAND TOWNSHIP** 3957  
 VIRGINIA MILITARY SURVEY 13393 PART  
 INDIAN LAKE SHORES ALLOTMENTS AND VICINITY  
 SCALE: 1" = 100'

ROUNDHEAD TOWNSHIP - HARDIN COUNTY  
 RICHLAND TOWNSHIP - LOGAN COUNTY

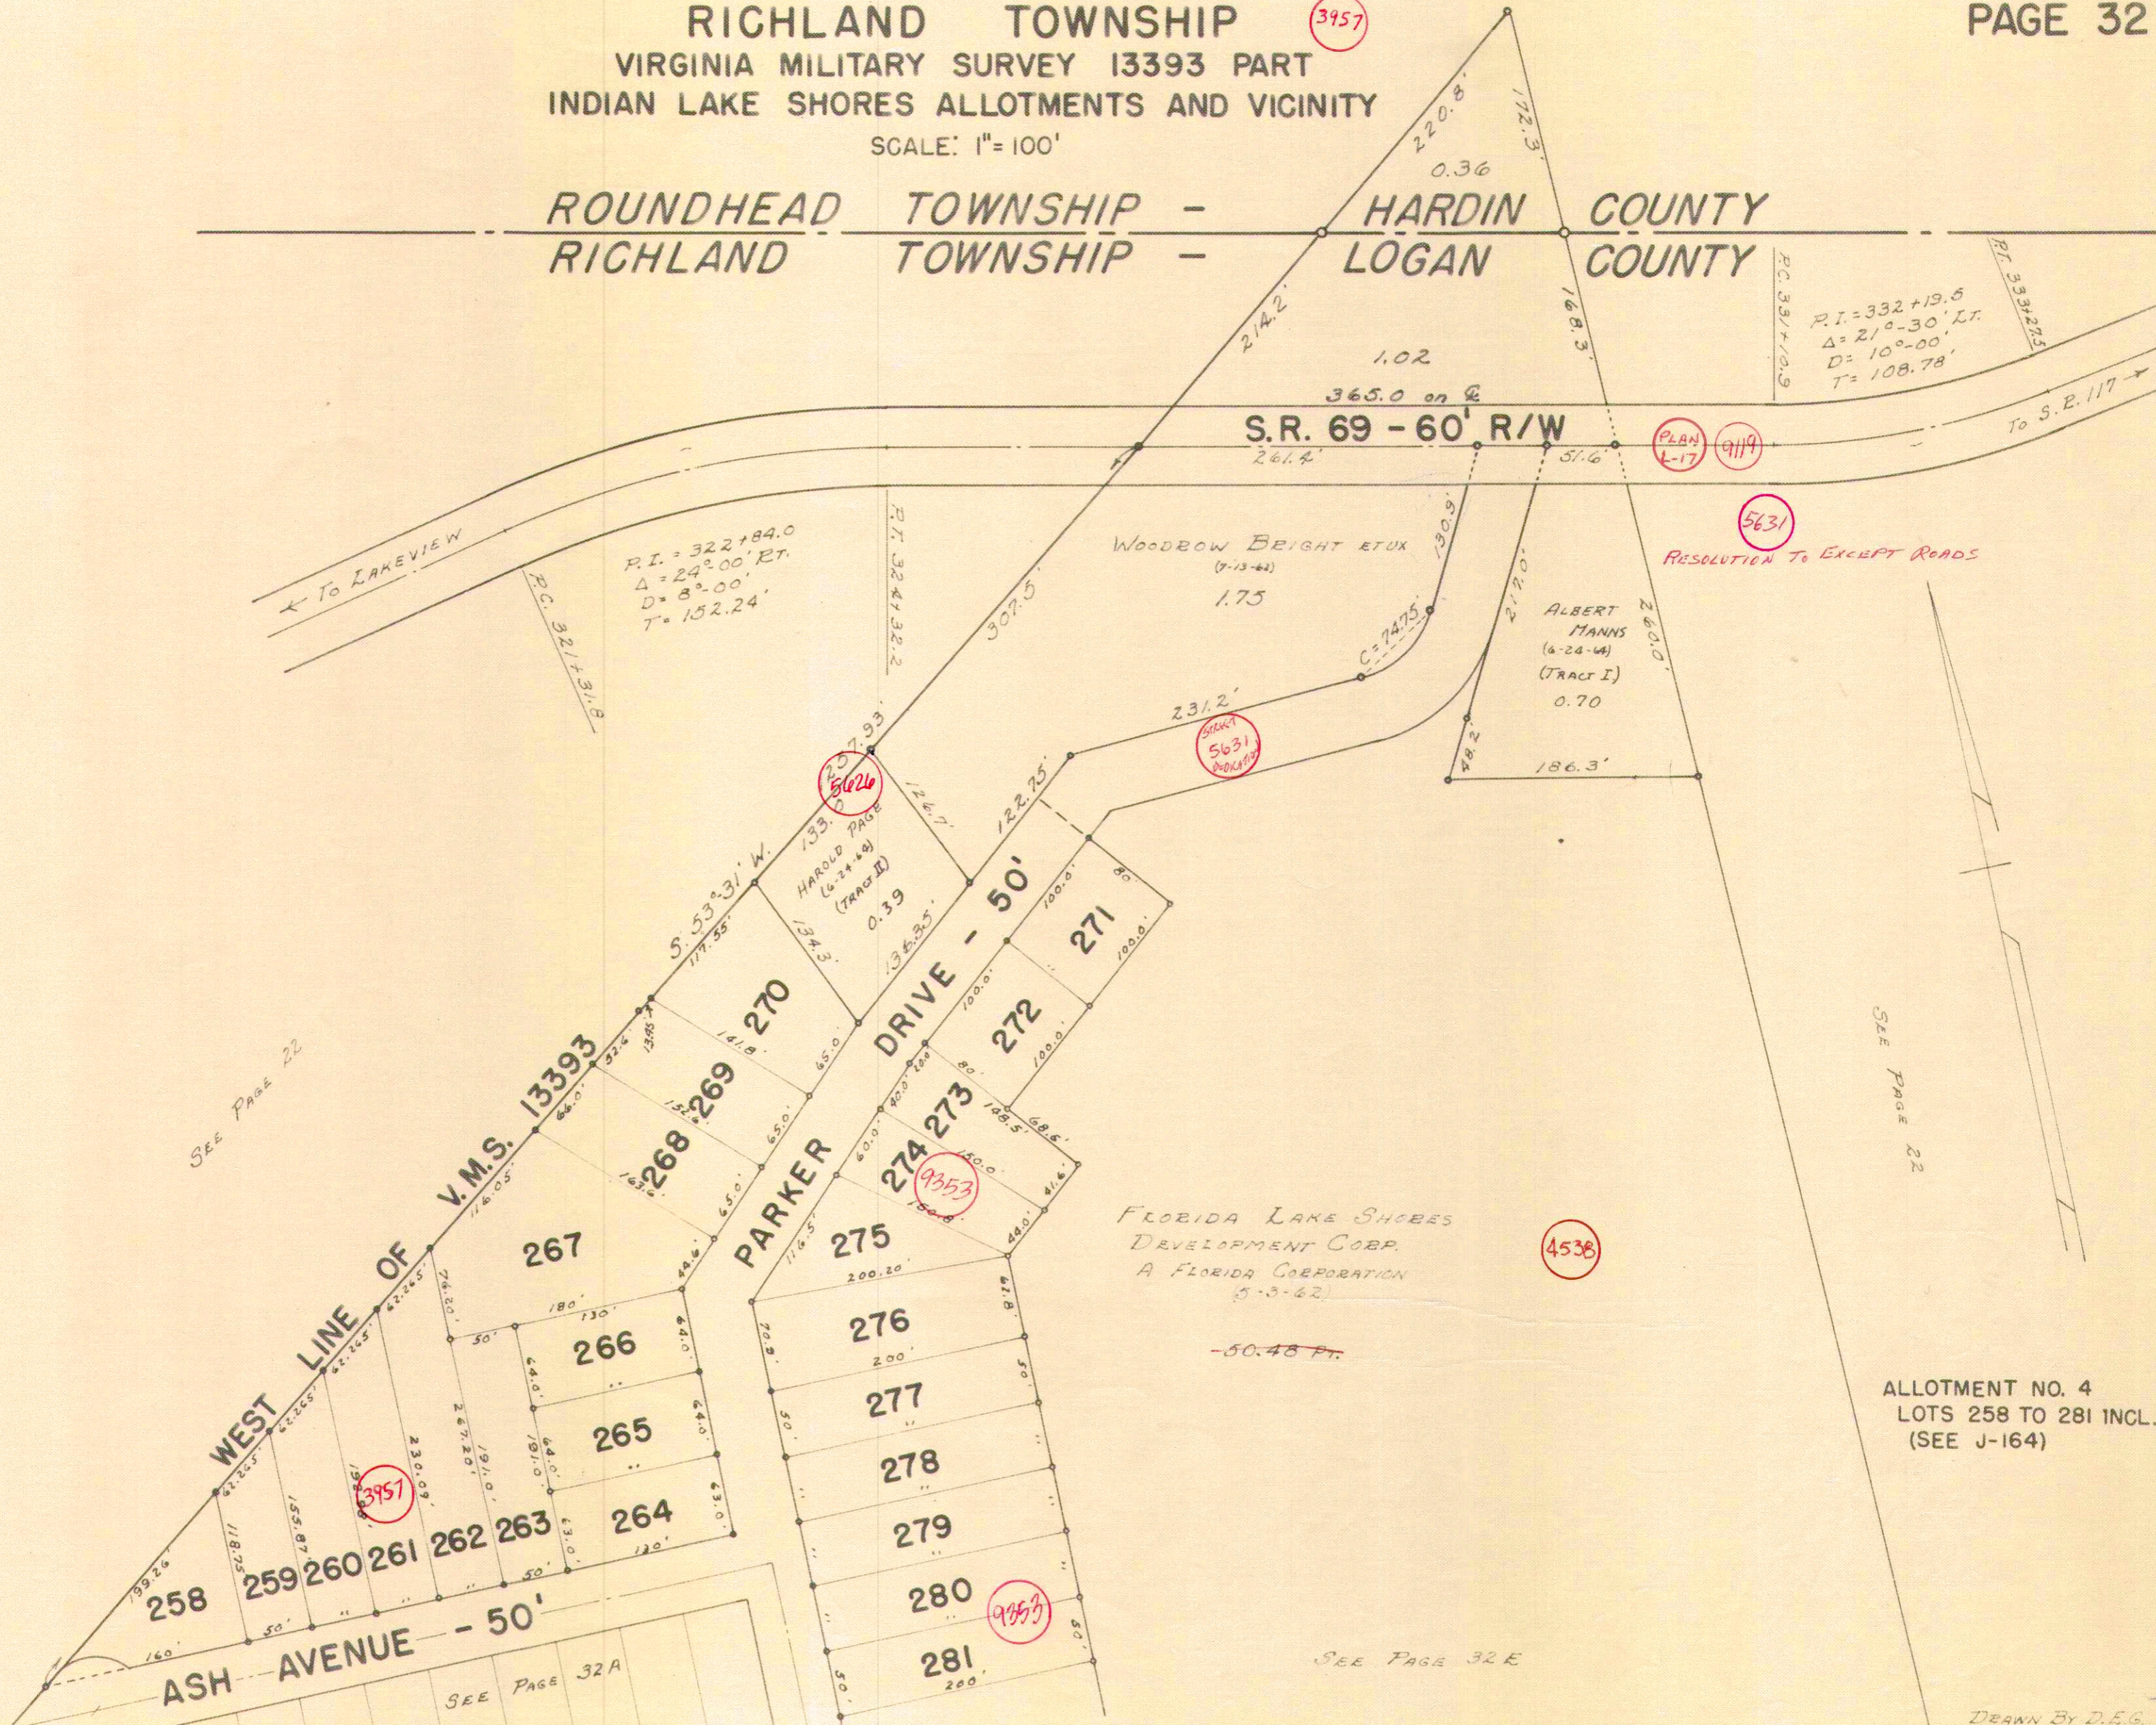

SEE PAGE 22

SEE PAGE 22

FLORIDA LAKE SHORES  
 DEVELOPMENT CORP.  
 A FLORIDA CORPORATION  
 5-3-62

ALLOTMENT NO. 4  
 LOTS 258 TO 281 INCL.  
 (SEE J-164)

SEE PAGE 32 E

DRAWN BY D.E.G.  
 14-5-63