


RUSHCREEK TOWNSHIP
VIRGINIA MILITARY SURVEY '3323

SCALE 10 CHAINS TO THE INCH

(See Page 28)



(See Page 32)

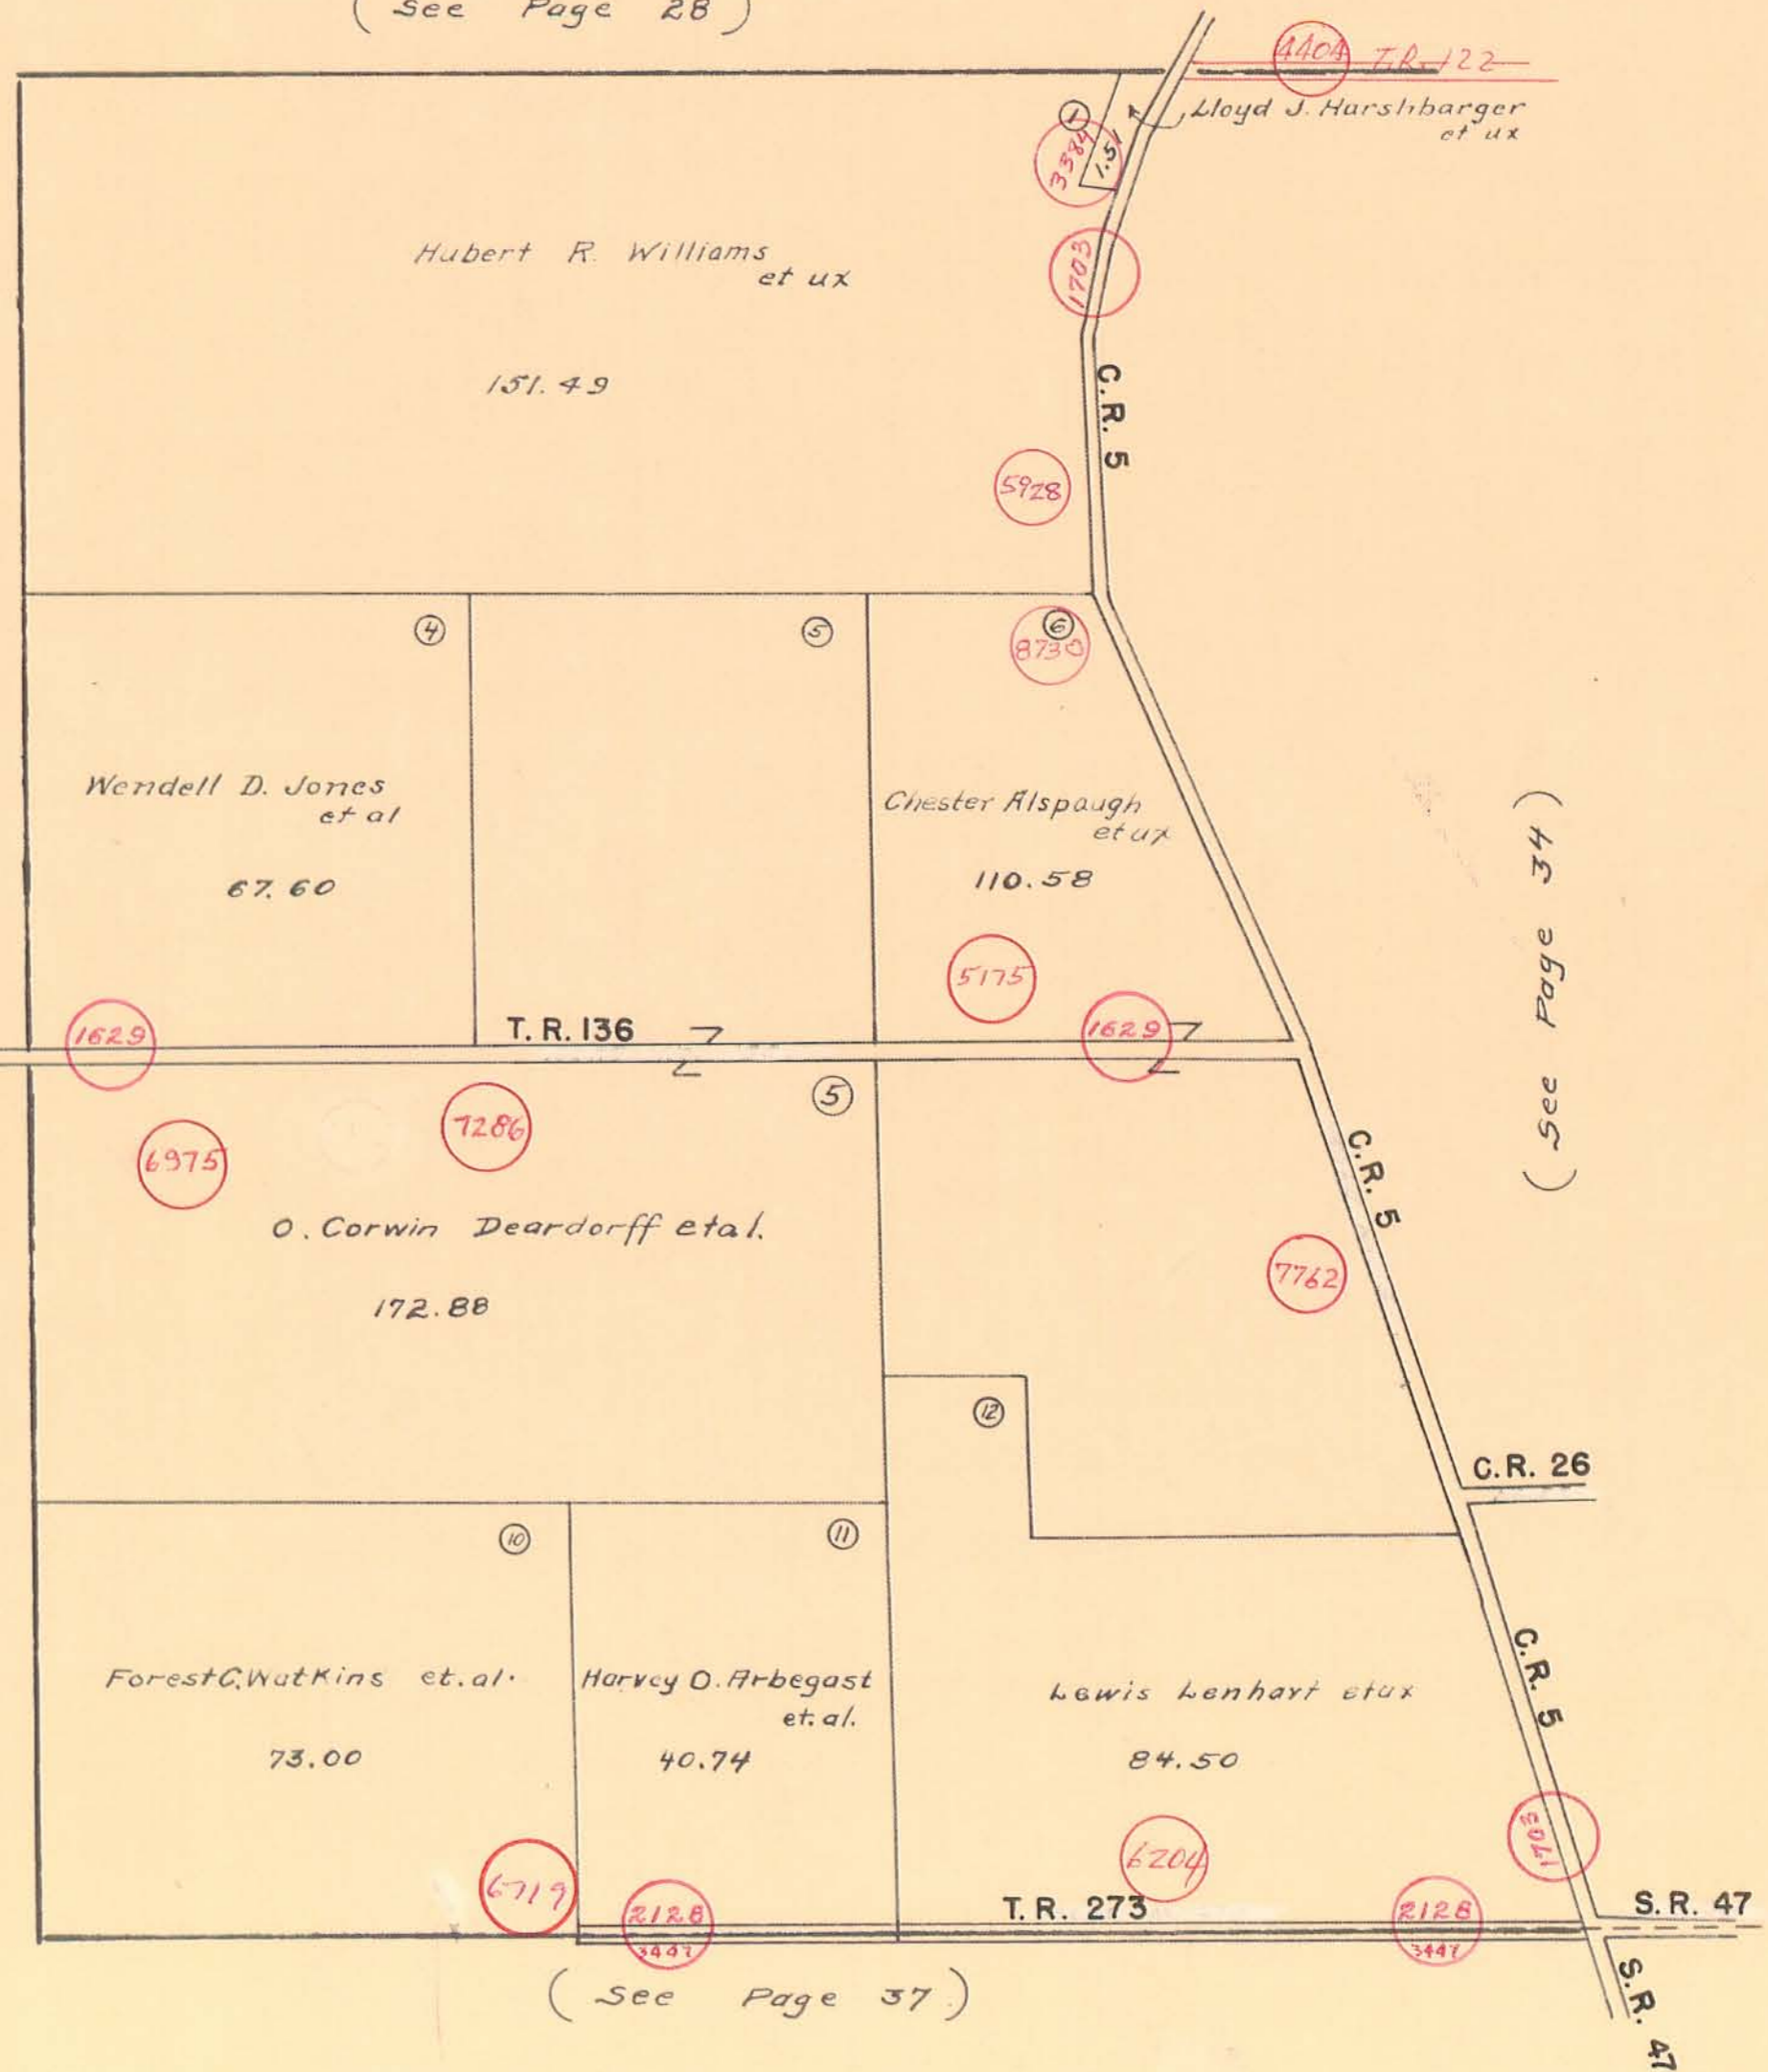

(See Page 34)