


RUSHSYLVANIA

SCALE ONE INCH TO 200 FEET

(See Page 40)

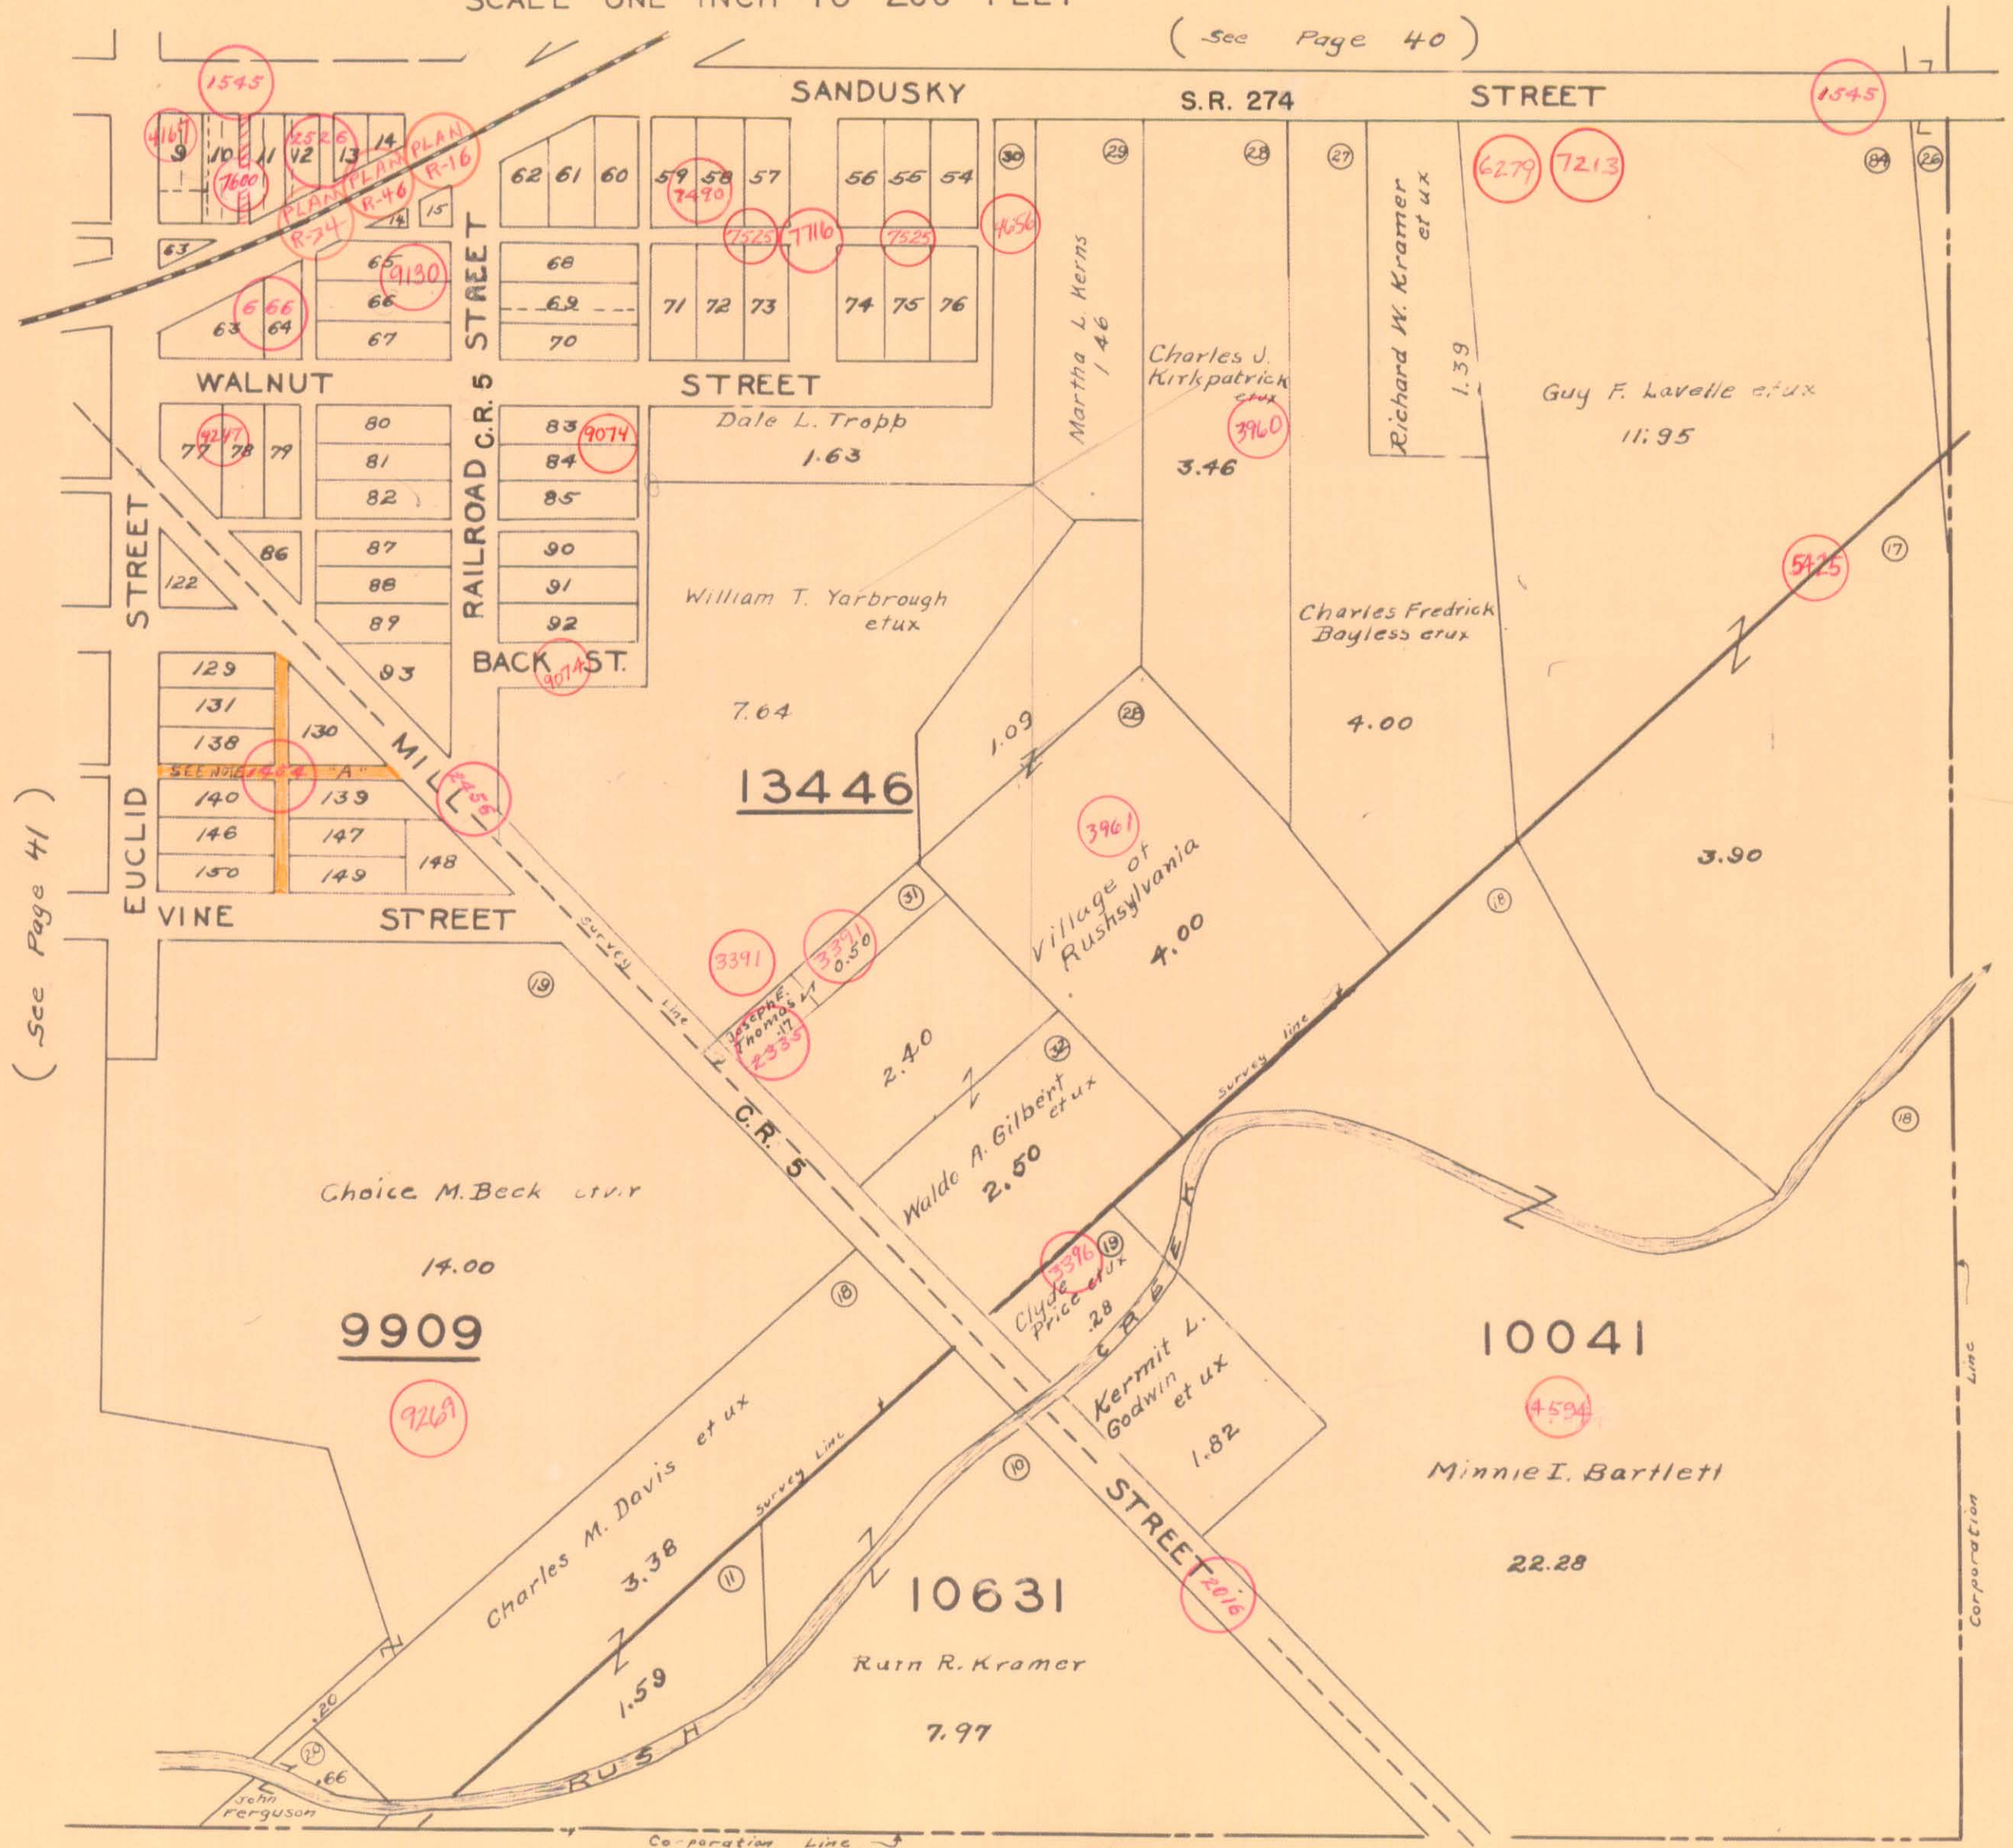

(See Page 41)

