WASHINGTON TOWNSHIP

SECTION 25 TOWN 7 S. RANGE 8 E.
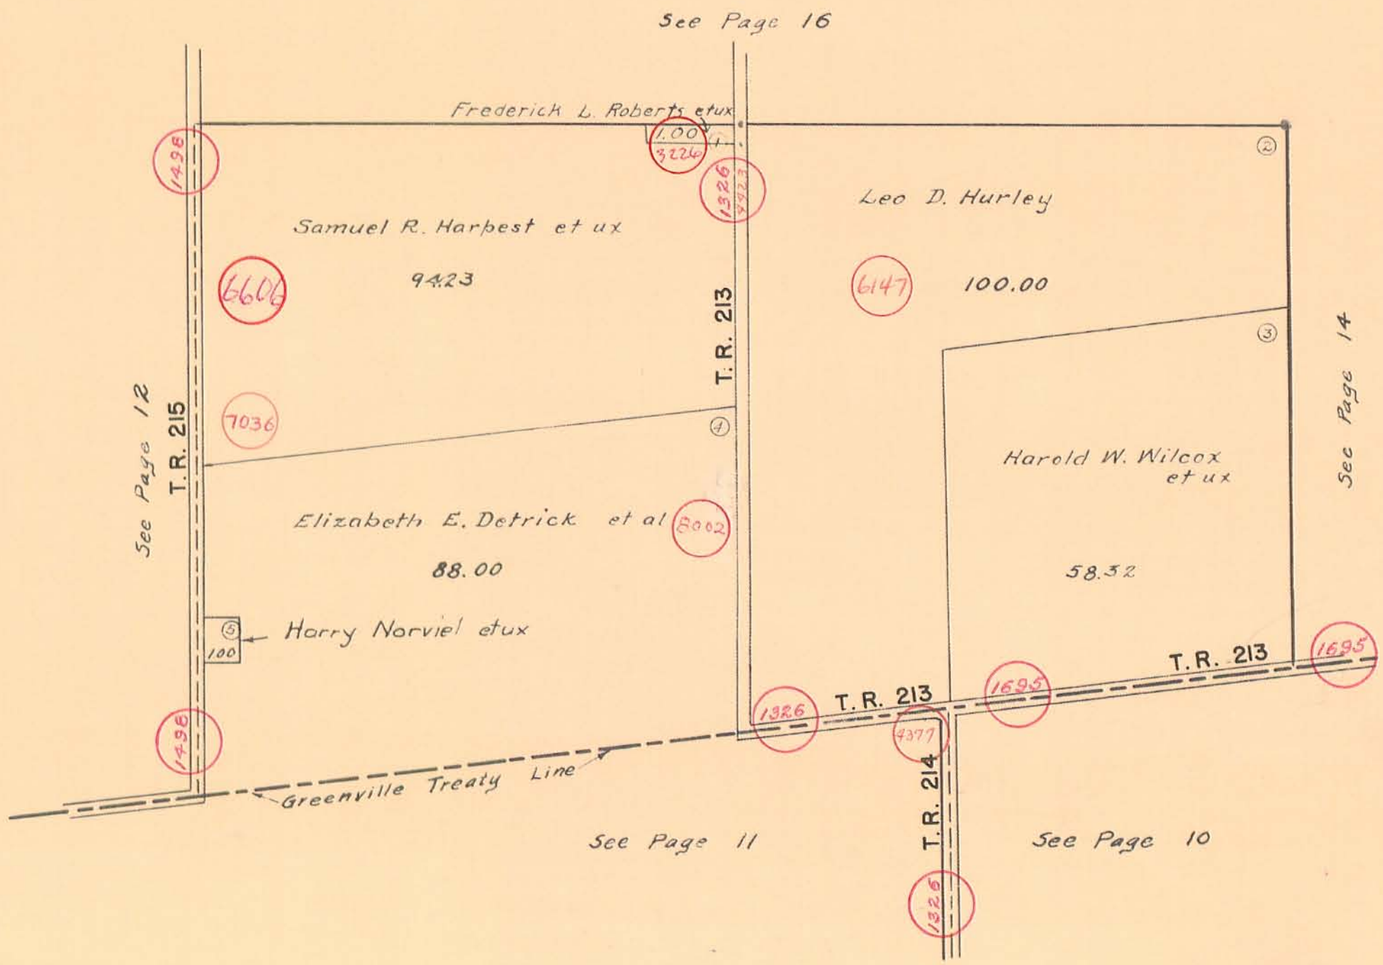
SCALE 10 CHAINS TO THE INCH