


SECTION 36 TOWN 6 S. RANGE 8 E. VIRGINIA MILITARY SURVEY 12276

SCALE 200 FEET TO THE INCH

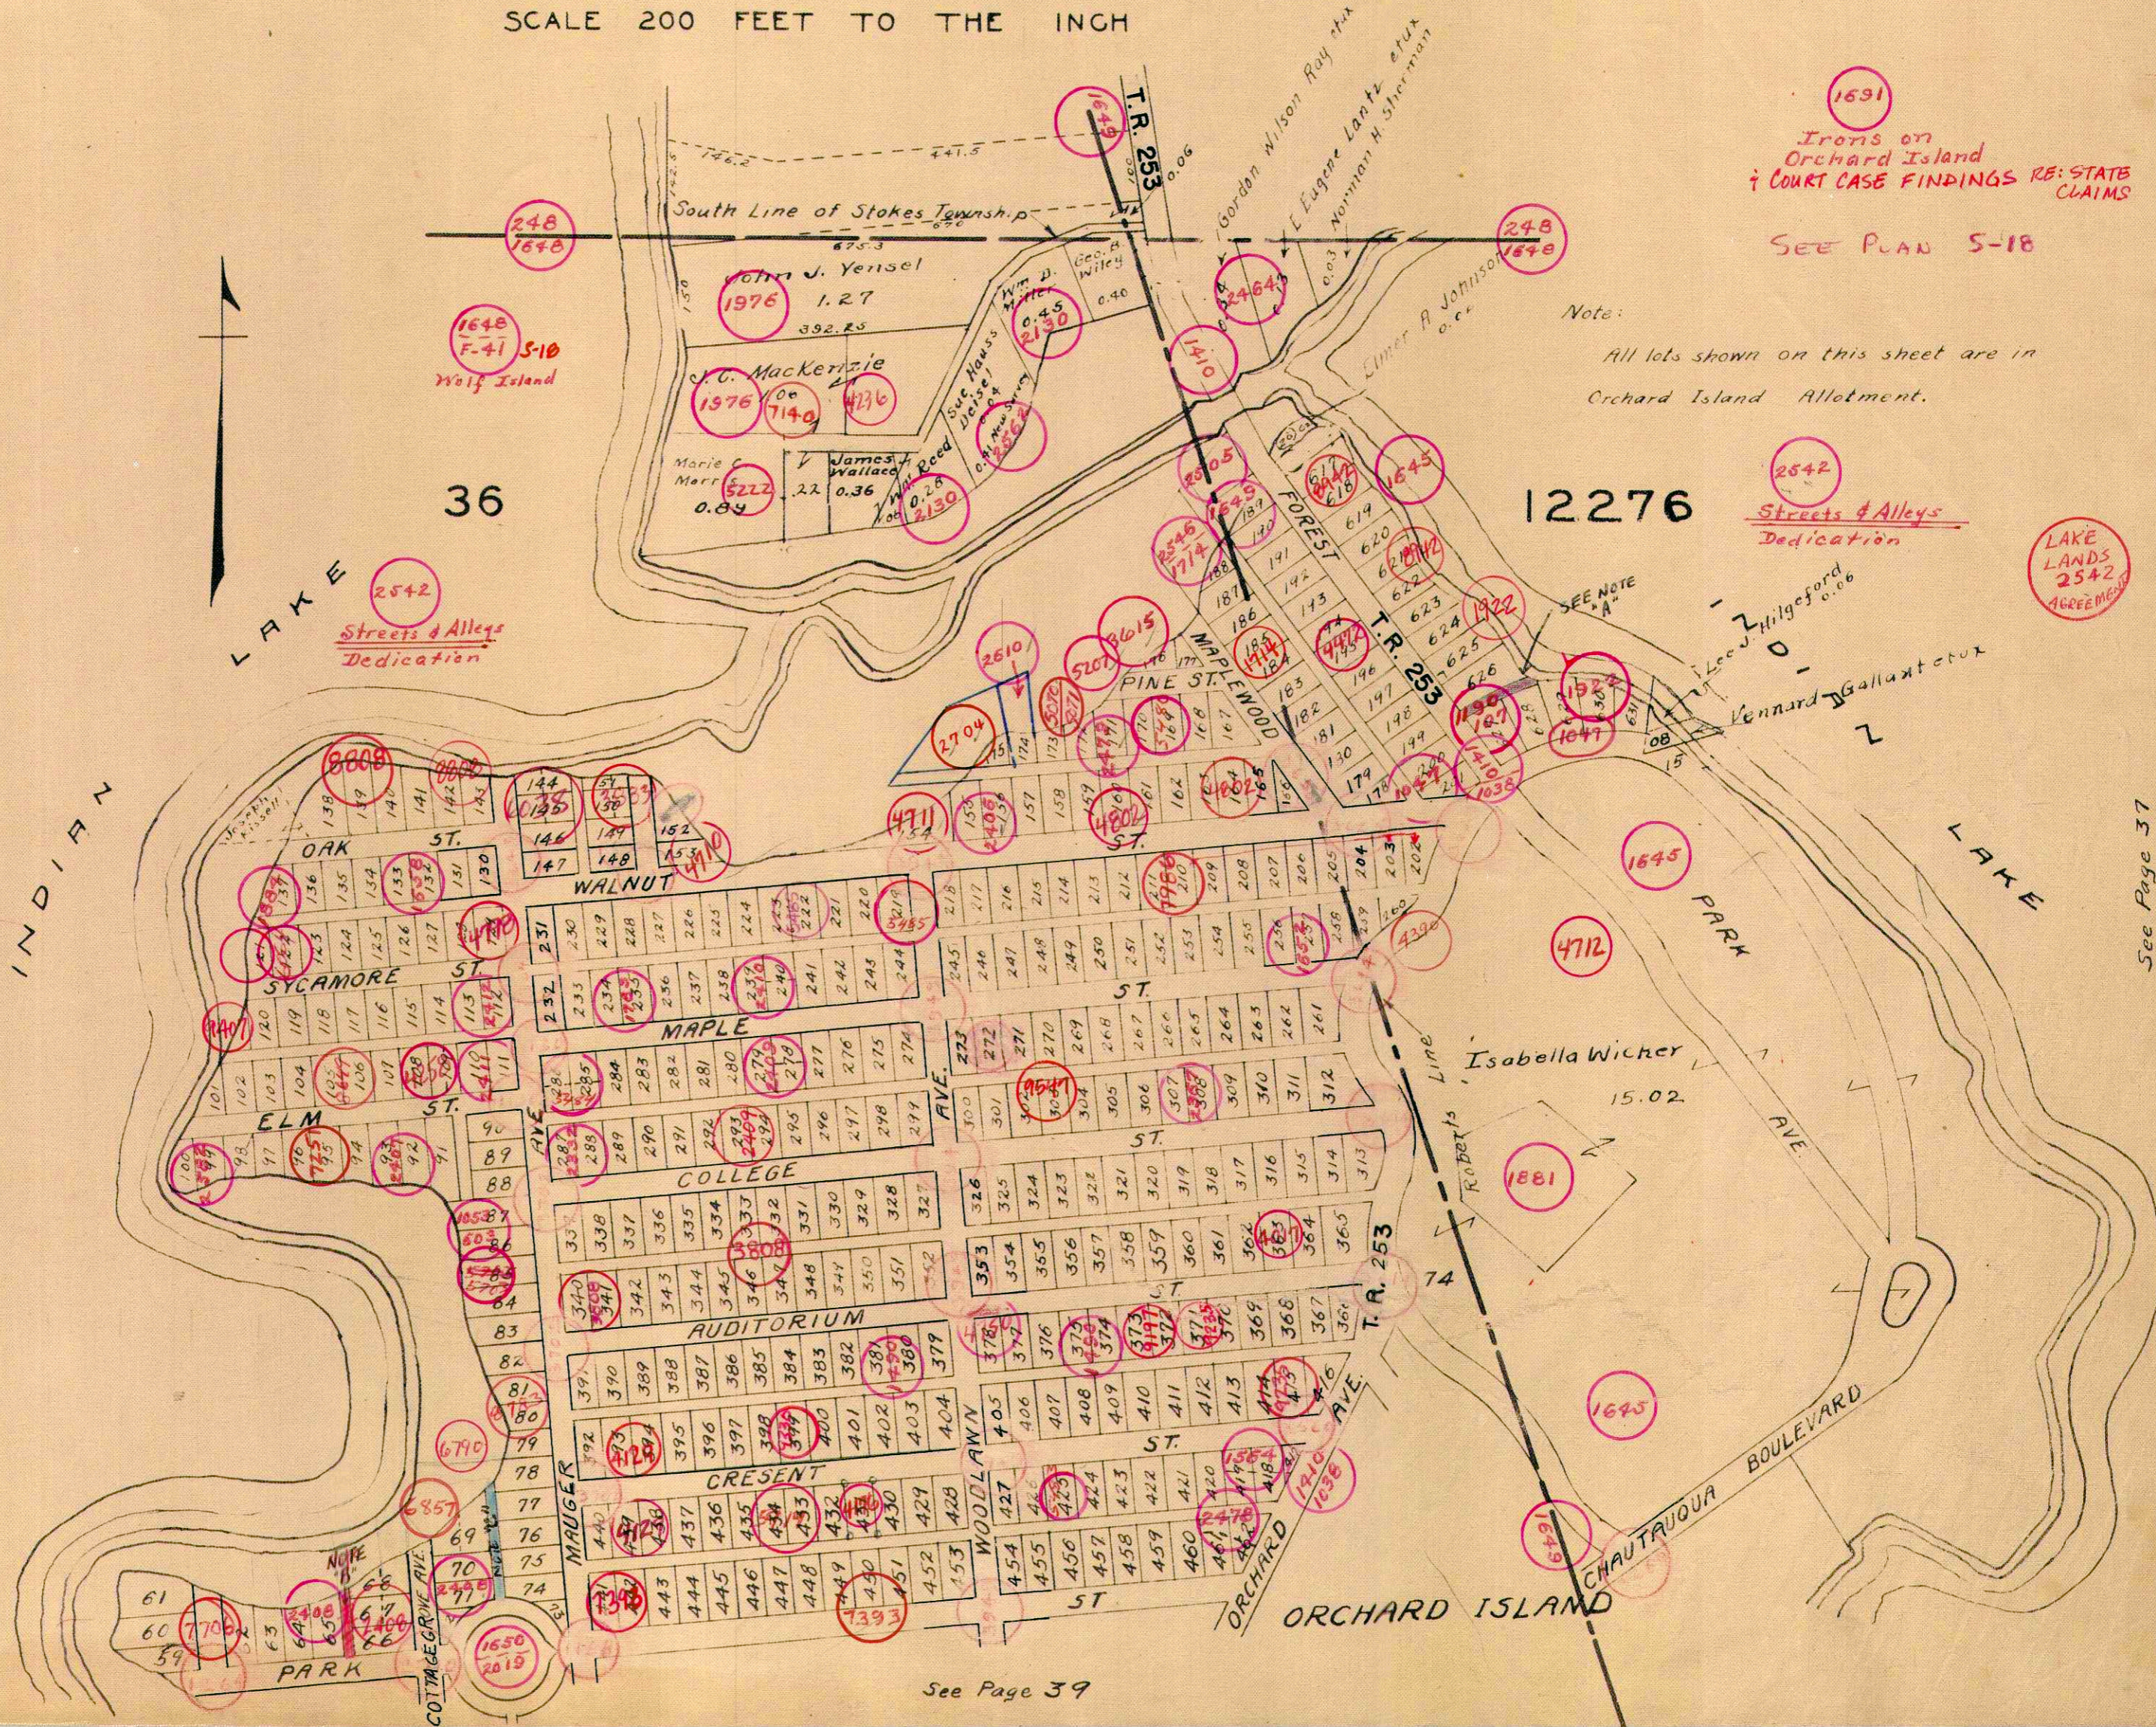

See Page 26

See Page 37

See Page 39

1691
Irons on Orchard Island
+ COURT CASE FINDINGS RE: STATE CLAIMS
SEE PLAN 5-18

Note:
All lots shown on this sheet are in Orchard Island Allotment.

2542
Streets & Alleys Dedication

LAKELANDS 2542 AGREEMENT

SEE NOTE "A"