ROAD NO. 57
LAKE and HARRISON TOWNSHIP
LOGAN COUNTY
1932

1/1

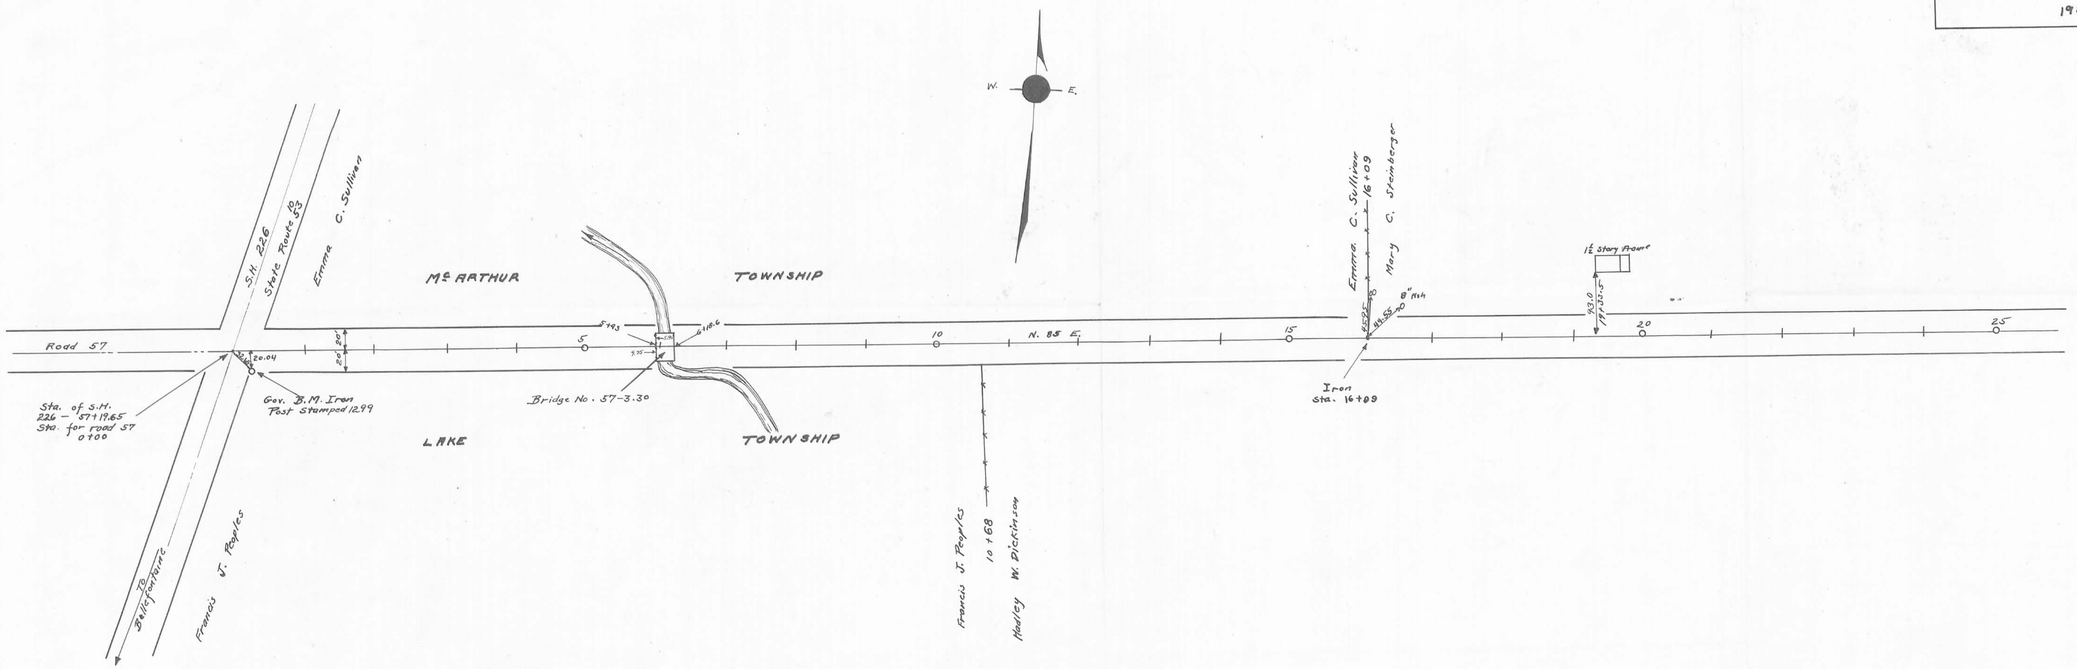

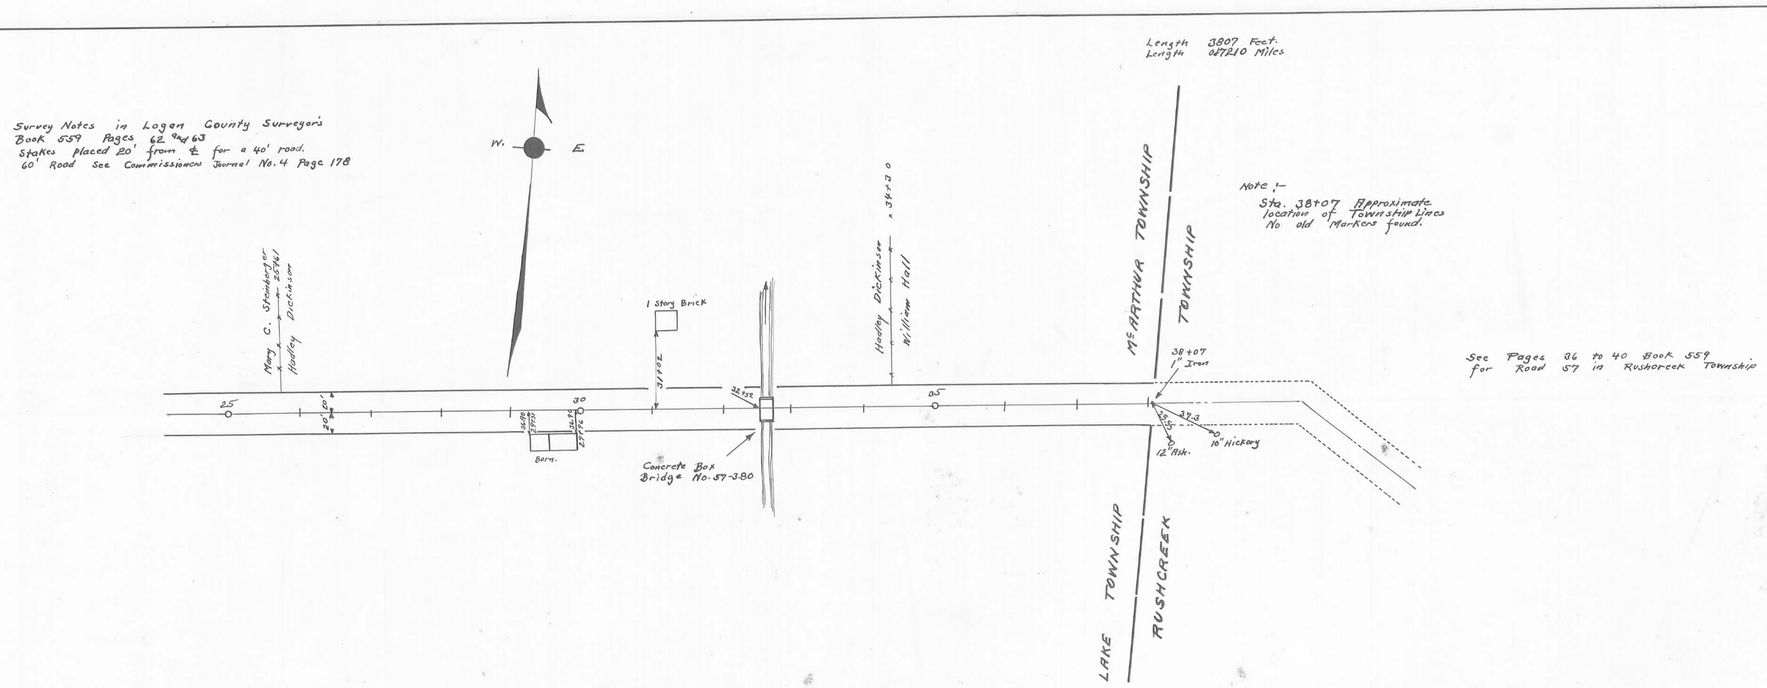

1429

INDEXED ON MAP

X-57A