ROAD NO. 132
PERRY TOWNSHIP
LOGAN COUNTY
1933

1/1

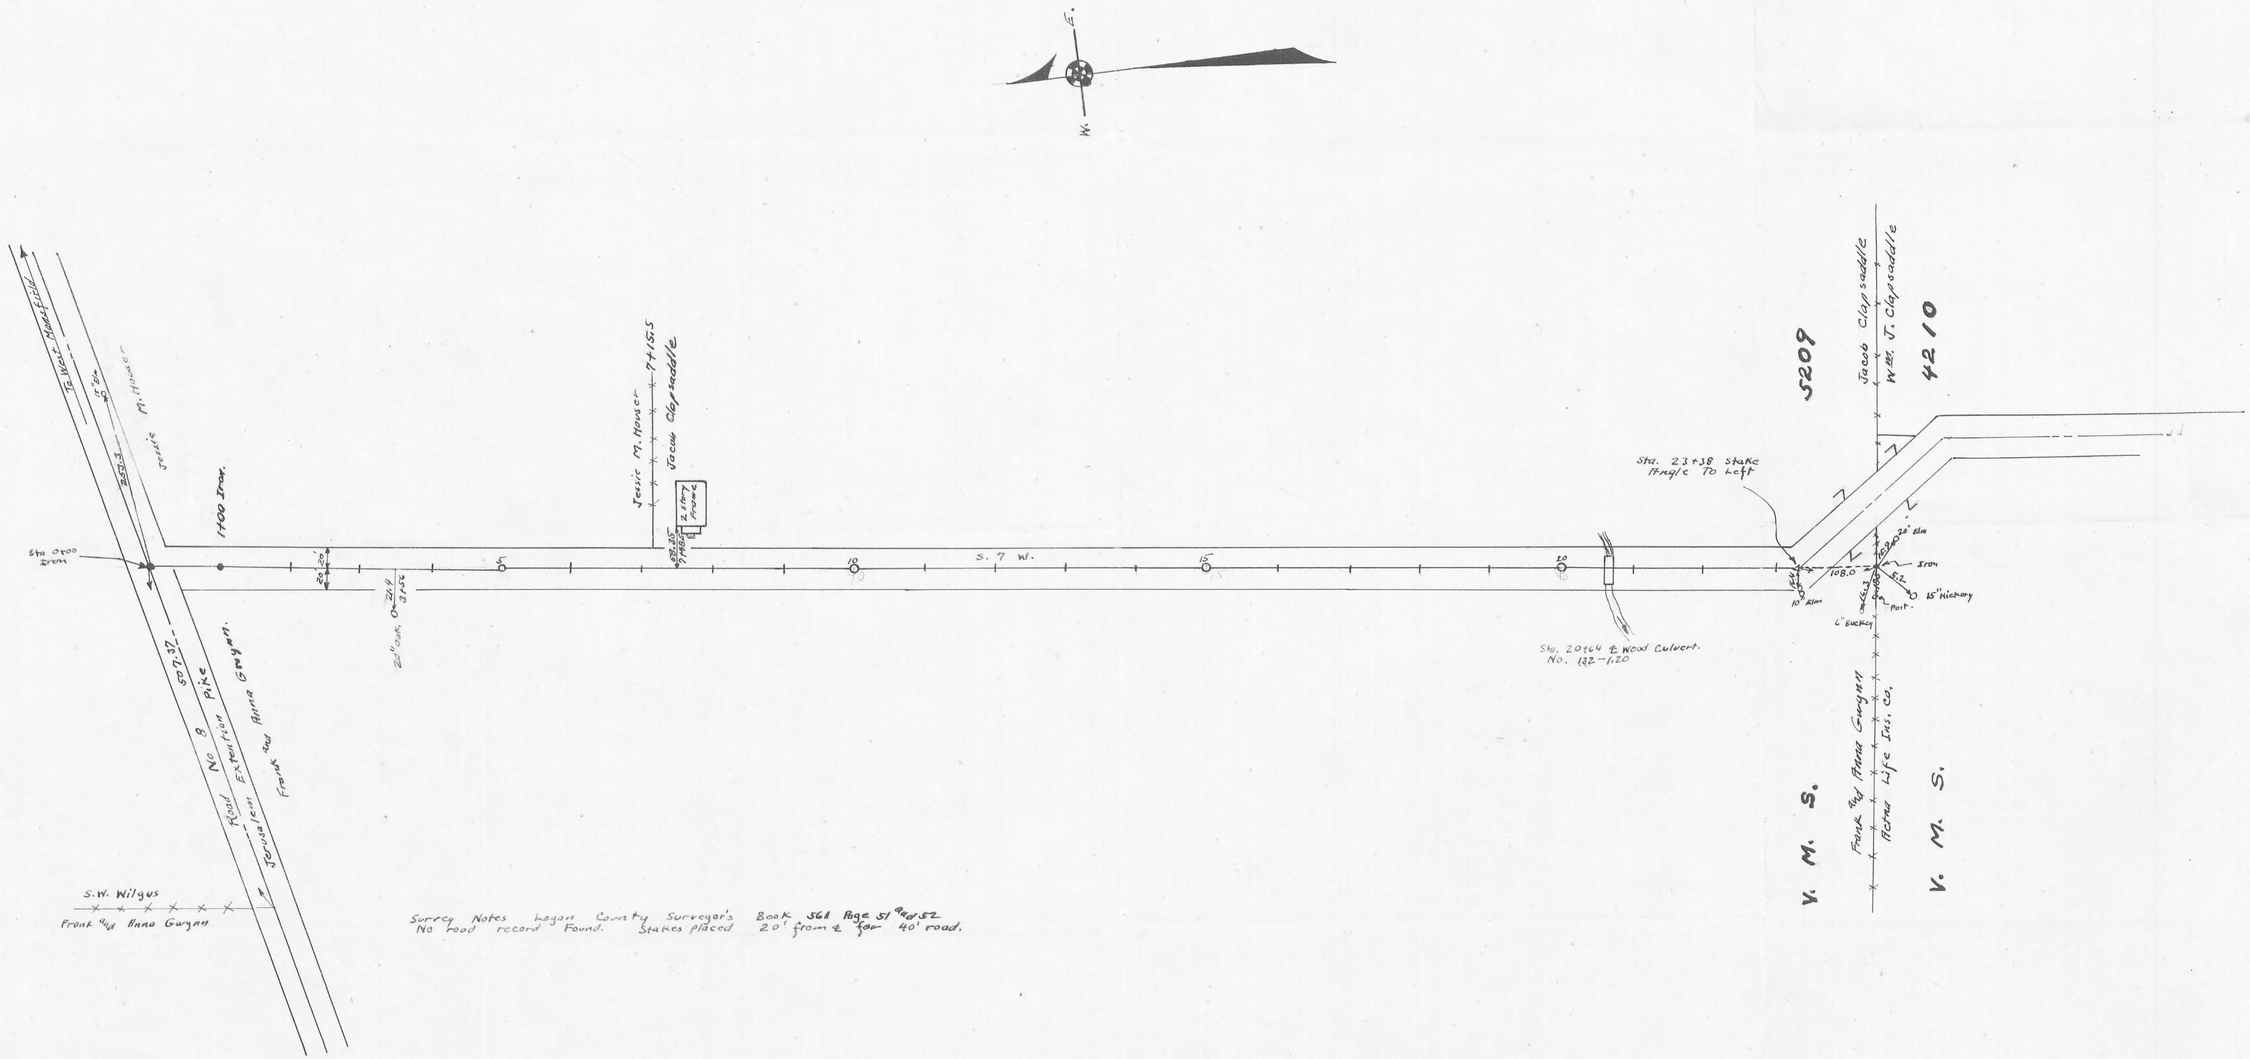

Survey Notes Logan County Surveyor's Book 561 Page 51 and 52
No road record Found. Stakes placed 20' from ℄ for 40' road.

1488
INDEXED ON MAP

A. F. Wing 19. C.E.
1933

X-132