

FAIRVIEW CEMETERY

LOGAN CO MIAMI TWP.

OFFICIAL PPROJECT NOS. 465-42-3-467 & 665-42-3-232


ACRES 10

PAGES 4

LEGEND

HISTORY

- ① REVOLUTIONARY WAR
- ⑩ WAR OF 1812
- ⑯ WAR WITH MEXICO
- ⑲ CIVIL WAR
- ⑳ SPANISH-AMERICAN WAR
- ⑳ WORLD WAR

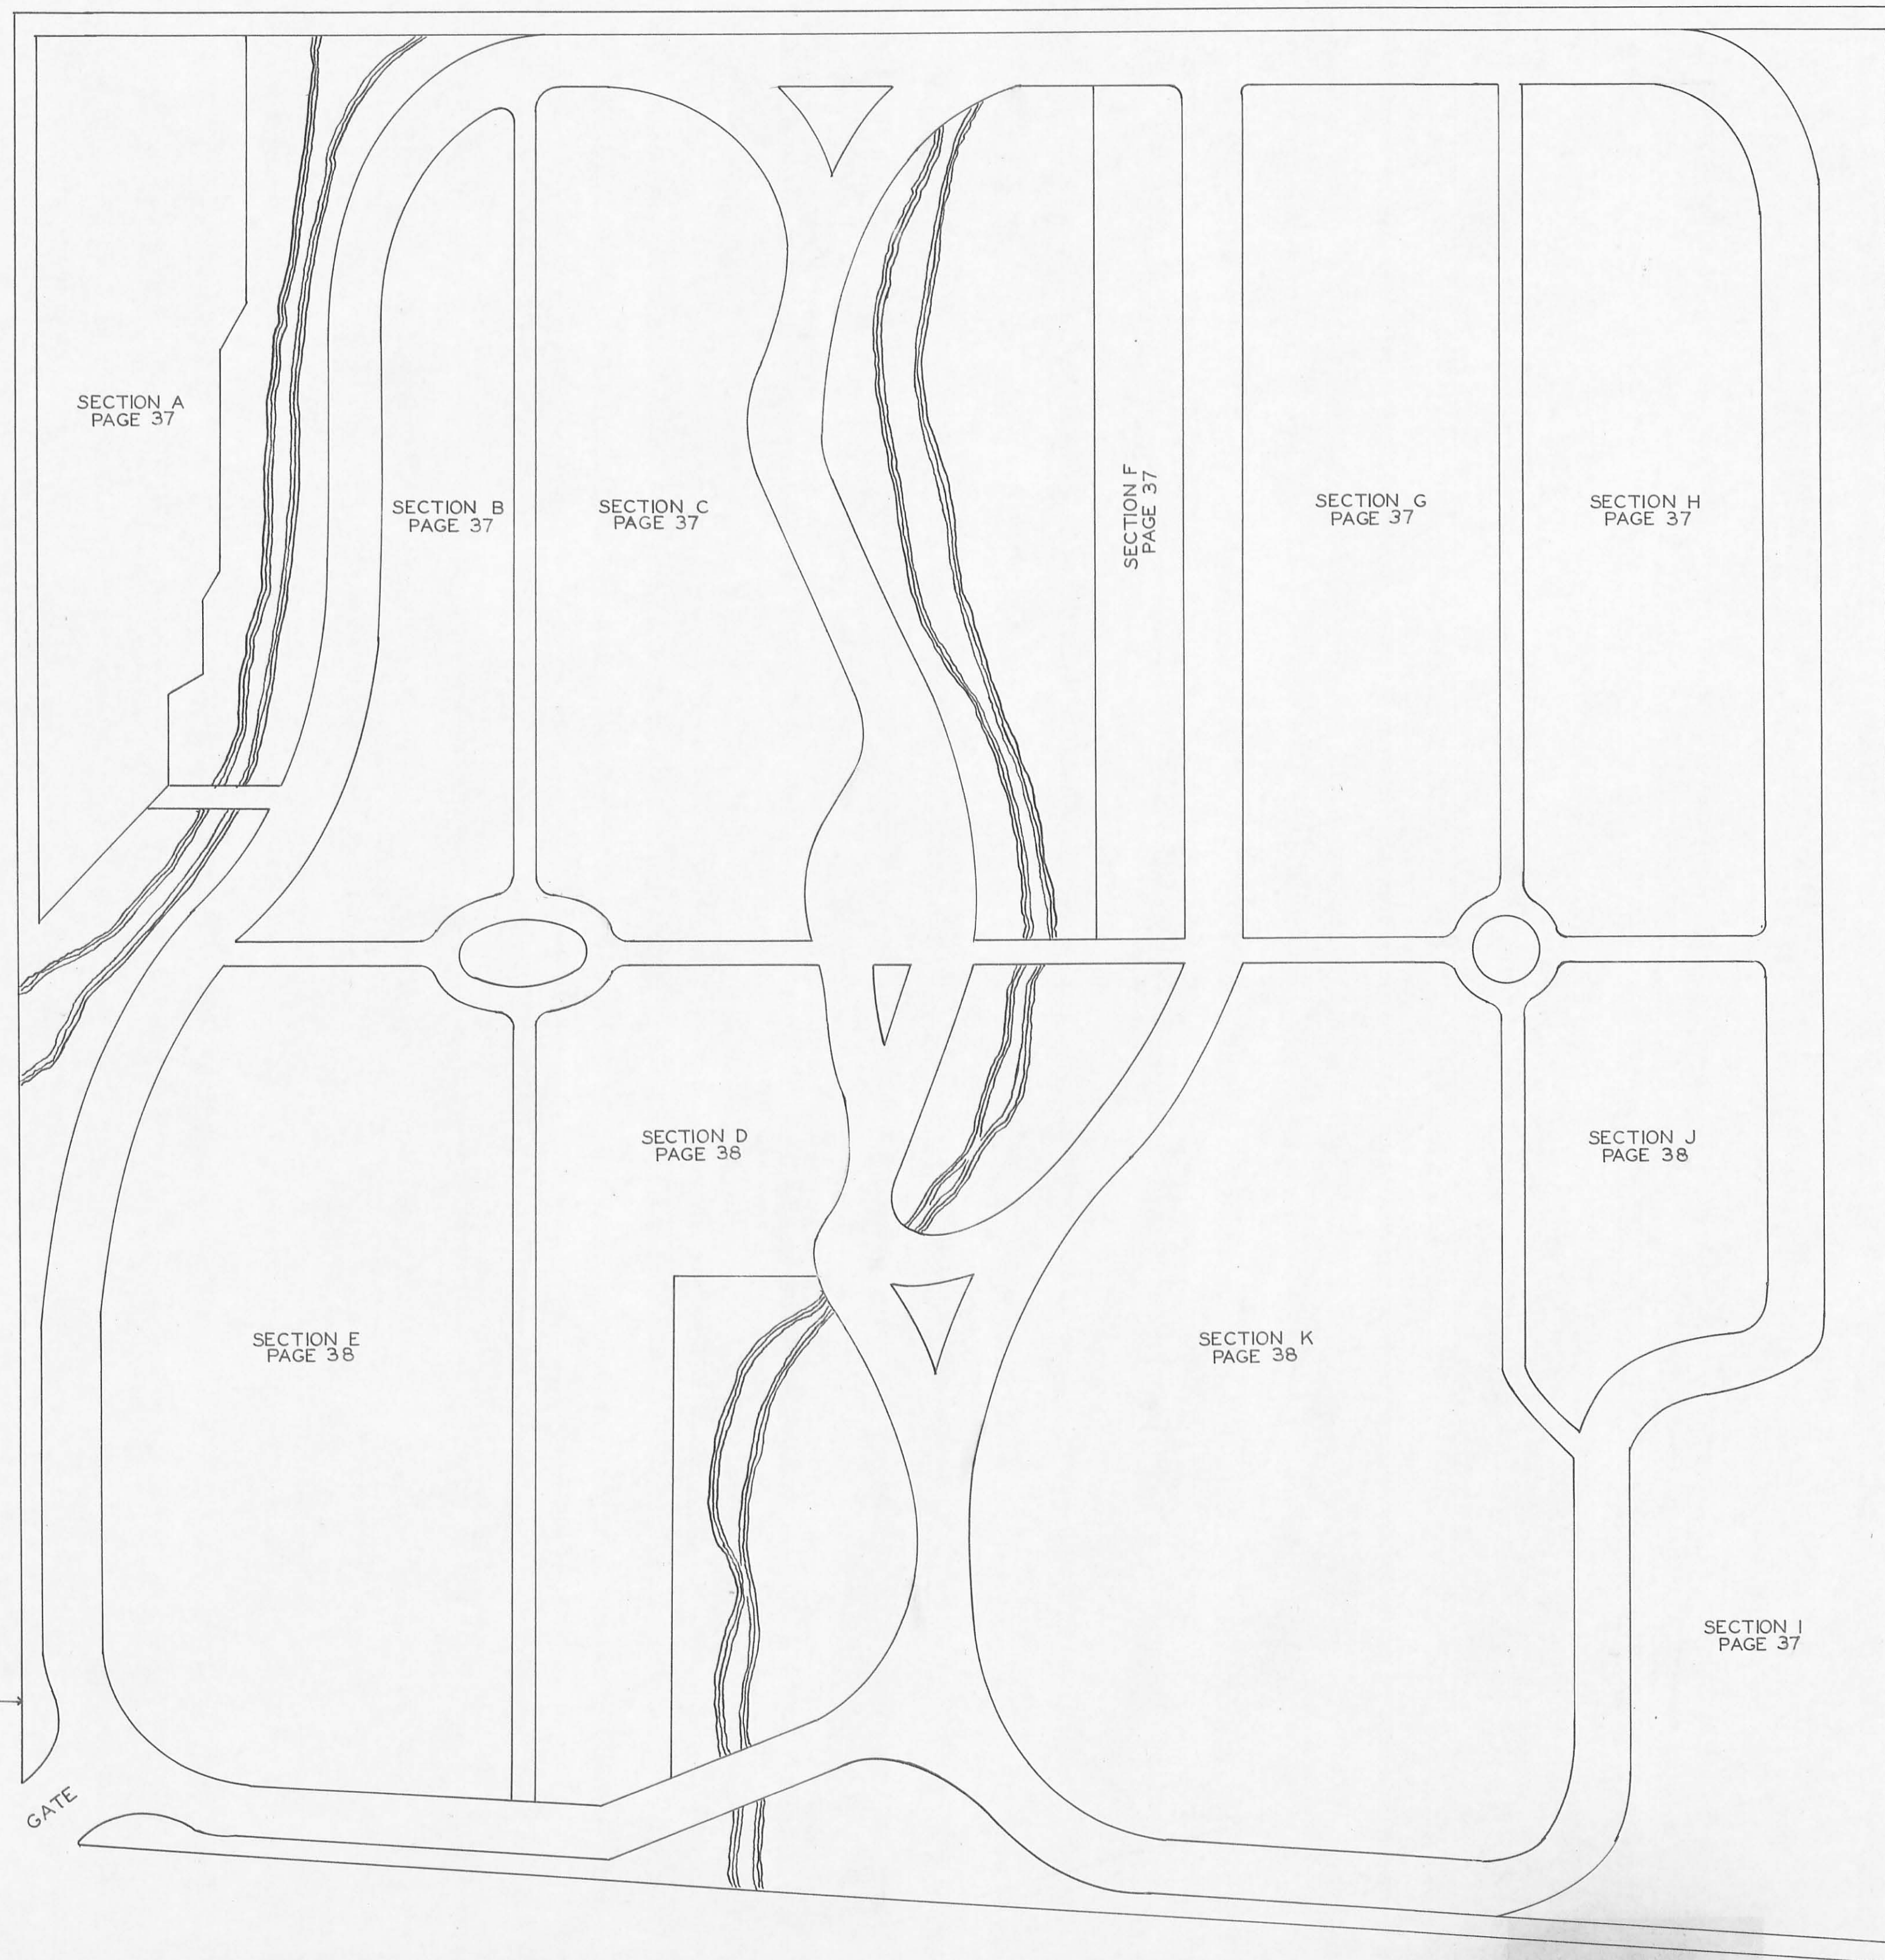

SECTION A
PAGE 37

SECTION B
PAGE 37

SECTION C
PAGE 37

SECTION F
PAGE 37

SECTION G
PAGE 37

SECTION H
PAGE 37

SECTION D
PAGE 38

SECTION J
PAGE 38

SECTION E
PAGE 38

SECTION K
PAGE 38

SECTION I
PAGE 37

GATE

30'

C-34

T-13

U.S. 69 2 MI

LEGEND
 SEC=SECTION L=LOT R=ROW
 G=GRAVE W=WAR
 X=POSITION UNKNOWN

NAME	SEC	L	R	G	W	NAME	SEC	L	R	G	W
* ALEXANDER CHAS						PURKEYPILE ISAAC					*
ALLEGACH AARON	C	96		2		ROE ABRAM H	C	112		2	19
ARTHUR JOEL J	B	17		1	19	SMITH JOSEPH R.	C	38		3	19
BALL SAMUEL	B	2		3	19	WEBB JOSEPH V	C	131		2	31
BROWN JAMES A	C	11		3	19	YOST GEORGE W	C	14		4	19
BROWN JOHN S	B	0		1	19	VALENTINE ROBERT	B	43			2
BUTLER CHARLES H	B	38		3	19						
CURL WILLIAM T	C	66		4	19						
DAVIS	B	12		5	19						
HAHN STANTON	C	36		1	31						
HARBOUR HERSCHEL R	B	18		1	31						
HARTER OLIVER	C	16		3							
HEDGES J M	C	95		2	19						
HILL WILLIAM L	C	64		3	19						
KISER NEWTON	B	12		2	19						
KRESS MARTIN	C	39		3	19						
MELHORN JACOB	C	57		4	19						
METCALF E T	C	79		4	19						
NEVERS CHARLES O	C	128		3	19						



SCALE 1"=20'



SUPPLEMENTARY LIST

NAME	SEC	L	R	G	W
CURL O. P.	E	117		4	
CURTIS EDWARD	E	106		4	
MOORE ROBERT JR.	E	76		1	
MERRIMAN J. EDWARD	E	22		1	
MASON GEORGE W.	D	1	4	19	

NAME	SEC	L	R	G	W
ALLEBAUGH EDWIN J.	E	17		3	19
BARNES WM.	K	151		1	19
BLUE EZRA	E	143		1	19
BROWN FOREST	K	154		1	31
CAMPBELL W. S.	E	18		5	
CASTLE PRICE	E	47		2	19
CHAMBERS ABSOLOM	E	105		1	19
CLARK DANIEL	K	59		2	
CLAY JACOB F.	E	2		1	19
CLAY LEWIS D.	E	15		3	31
CLAY SIMON P.	E	124		1	19
CLONINGER PHILIP	E	123		1	19
COST JONATHAN S.	E	12		3	19

NAME	SEC	L	R	G	W
COST JACOB	E	6		3	19
CURL ALFRED M.	E	117		2	31
CURL LEWIS	E	45		1	19
CURL NELSON	E	147		1	19
CURL WILLIAM H.	D	13		2	19
GABLE JACOB	E	162		2	19
GEORGE MASON W.	D	1	4	19	
HEDGES ROBERT F.	K	51		1	31
HILLINGS JOHN M.	E	131		1	19
HOLMES JOHN B.	E	121		3	19
HUBBLE CLARENCE	K	135		4	31
KRESS JACOB	E	147		3	19

NAME	SEC	L	R	G	W
MC KINNIE WILLIAM	K	139		5	19
MC MILLEN SAMUEL Q.	K	74		5	19
MULFORD GEO. P.	D	39		2	19
PATTON OLIVER	D	45		1	19
PATTON SAMUEL M.	E	95		1	19
PLUMMER GREENBERRY	K	69		1	19
PRATT DAVID A.	E	132		3	19
ROADS RUDOLPH B.	K	42		3	19
ROADS WILLIAM	K	42		3	31
ROBERTS C. E.	E	5		2	31
ROWLEY FREEMAN E.	D	33		4	31
ROWLEY J. F.	D	33		2	19
SCHERTZ JACOB	E	128		1	
SHIPLEY E. B.	K	112		2	19
SMITH WILLIAM E.	E	36		3	
SPEECE N. V.	E	42		3	19
WILLIAMS SAMUEL K. E.		4		1	19

SCALE 1" = 20'



FAIRVIEW CEMETERY

LOGAN CO. RICHLAND TWP.

OFFICIAL PROJECT NOS. 465-42-3-467 & 665-42-3-232


9.27 ACRES

5 PAGES

LEGEND

HISTORY

- ① REVOLUTIONARY WAR
- ⑩ WAR OF 1812
- ⑯ WAR WITH MEXICO
- ⑲ CIVIL WAR
- ⑳ SPANISH-AMERICAN WAR
- ㉑ WORLD WAR

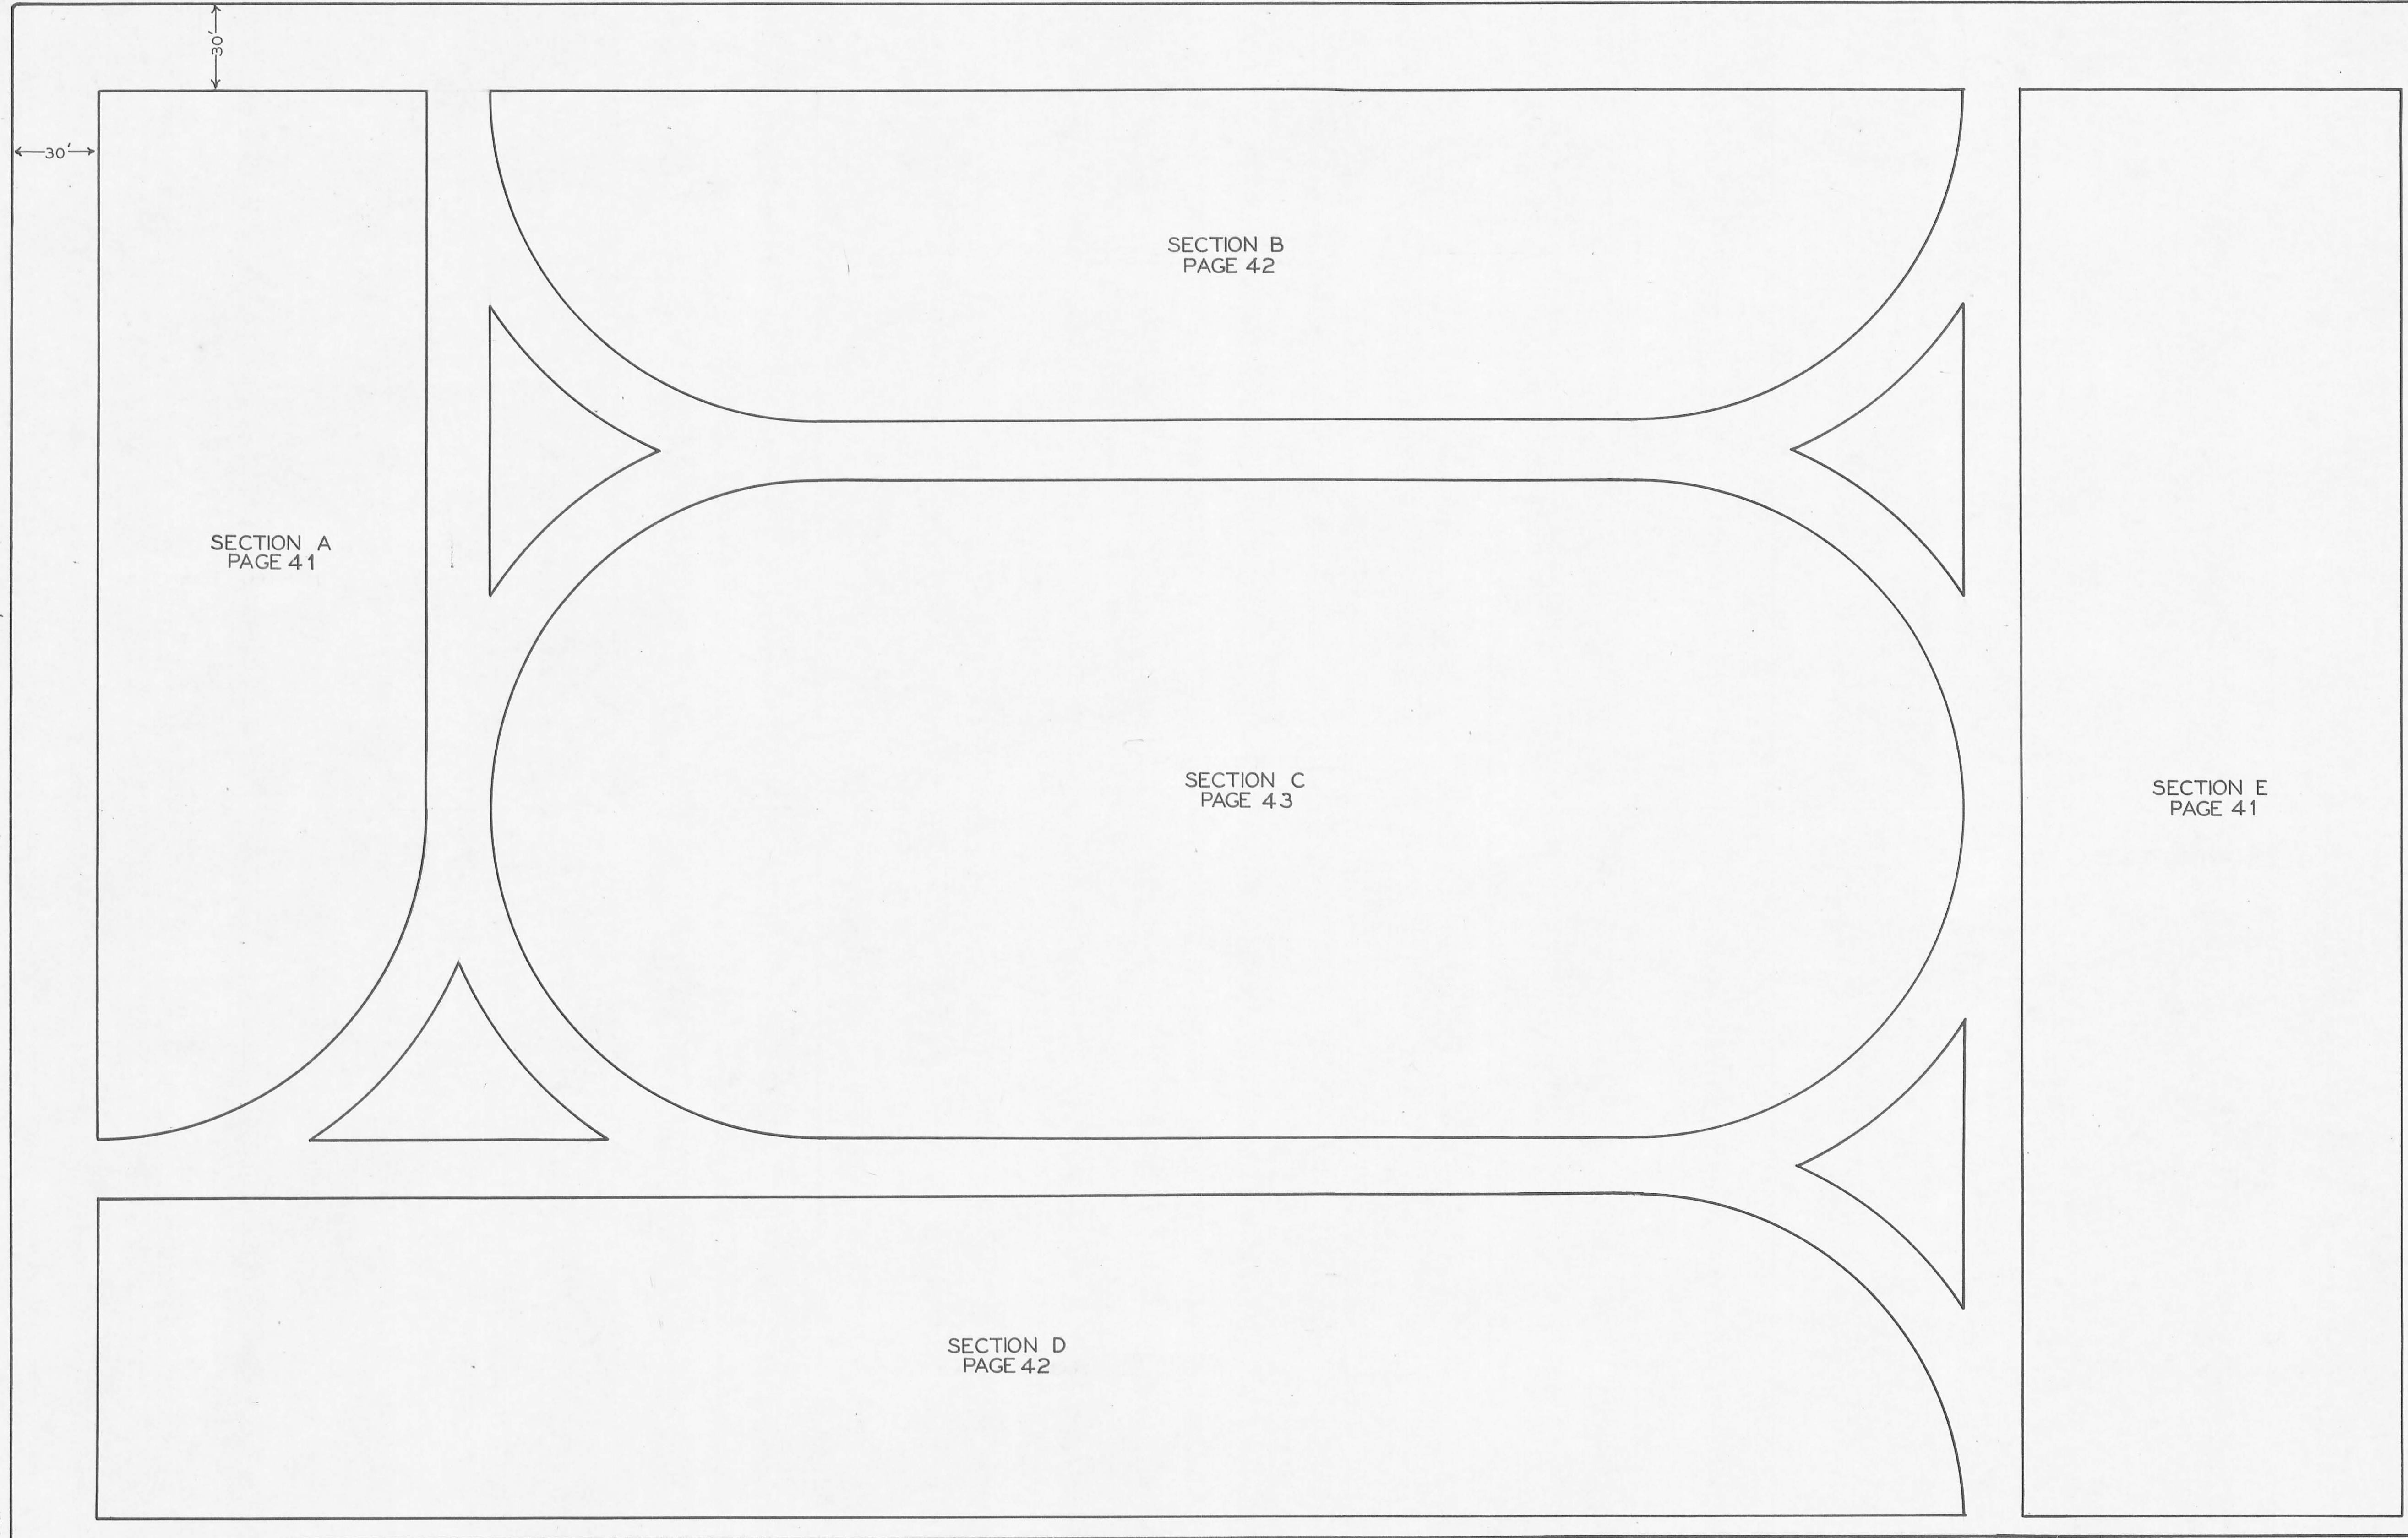

SECTION A
PAGE 41

SECTION B
PAGE 42

SECTION C
PAGE 43


SECTION D
PAGE 42

SECTION E
PAGE 41

↑
N
↓
1" = 30'


T-107

NAME	SEC	L	R	G	W
BROWN TRUETT D	1			1	31
COLVIN WILLIAM	97			4	19
GARRETT WILLIAM L	100			6	19
GROVES ROBERT	17			2	16
HAGUE JOSEPH	49			4	19
JOHN JOHN W	151			7	25
LEASE WILLIAM H H	76			2	19
LOWE JAMES	68			4	19
LOWERY JOHN	40			3	19
MURPHY DANIEL	149			7	19
MC ILUANIAN JAMES K	16			6	19
MC KIRAHAN JOHN	121	A		3	19
ROBB ROBERT J	70			4	19
SICKLES WILLIAM L	66			5	19
STOUT GEORGE H	38			8	19
STOUT JOHN H	38			7	19
STIVELY JOHN	38	A		2	19
ZIMMERMAN ELIJAH D.	18			3	19
Sickles, Walter A.	103			3	25
* Smith James Russell					

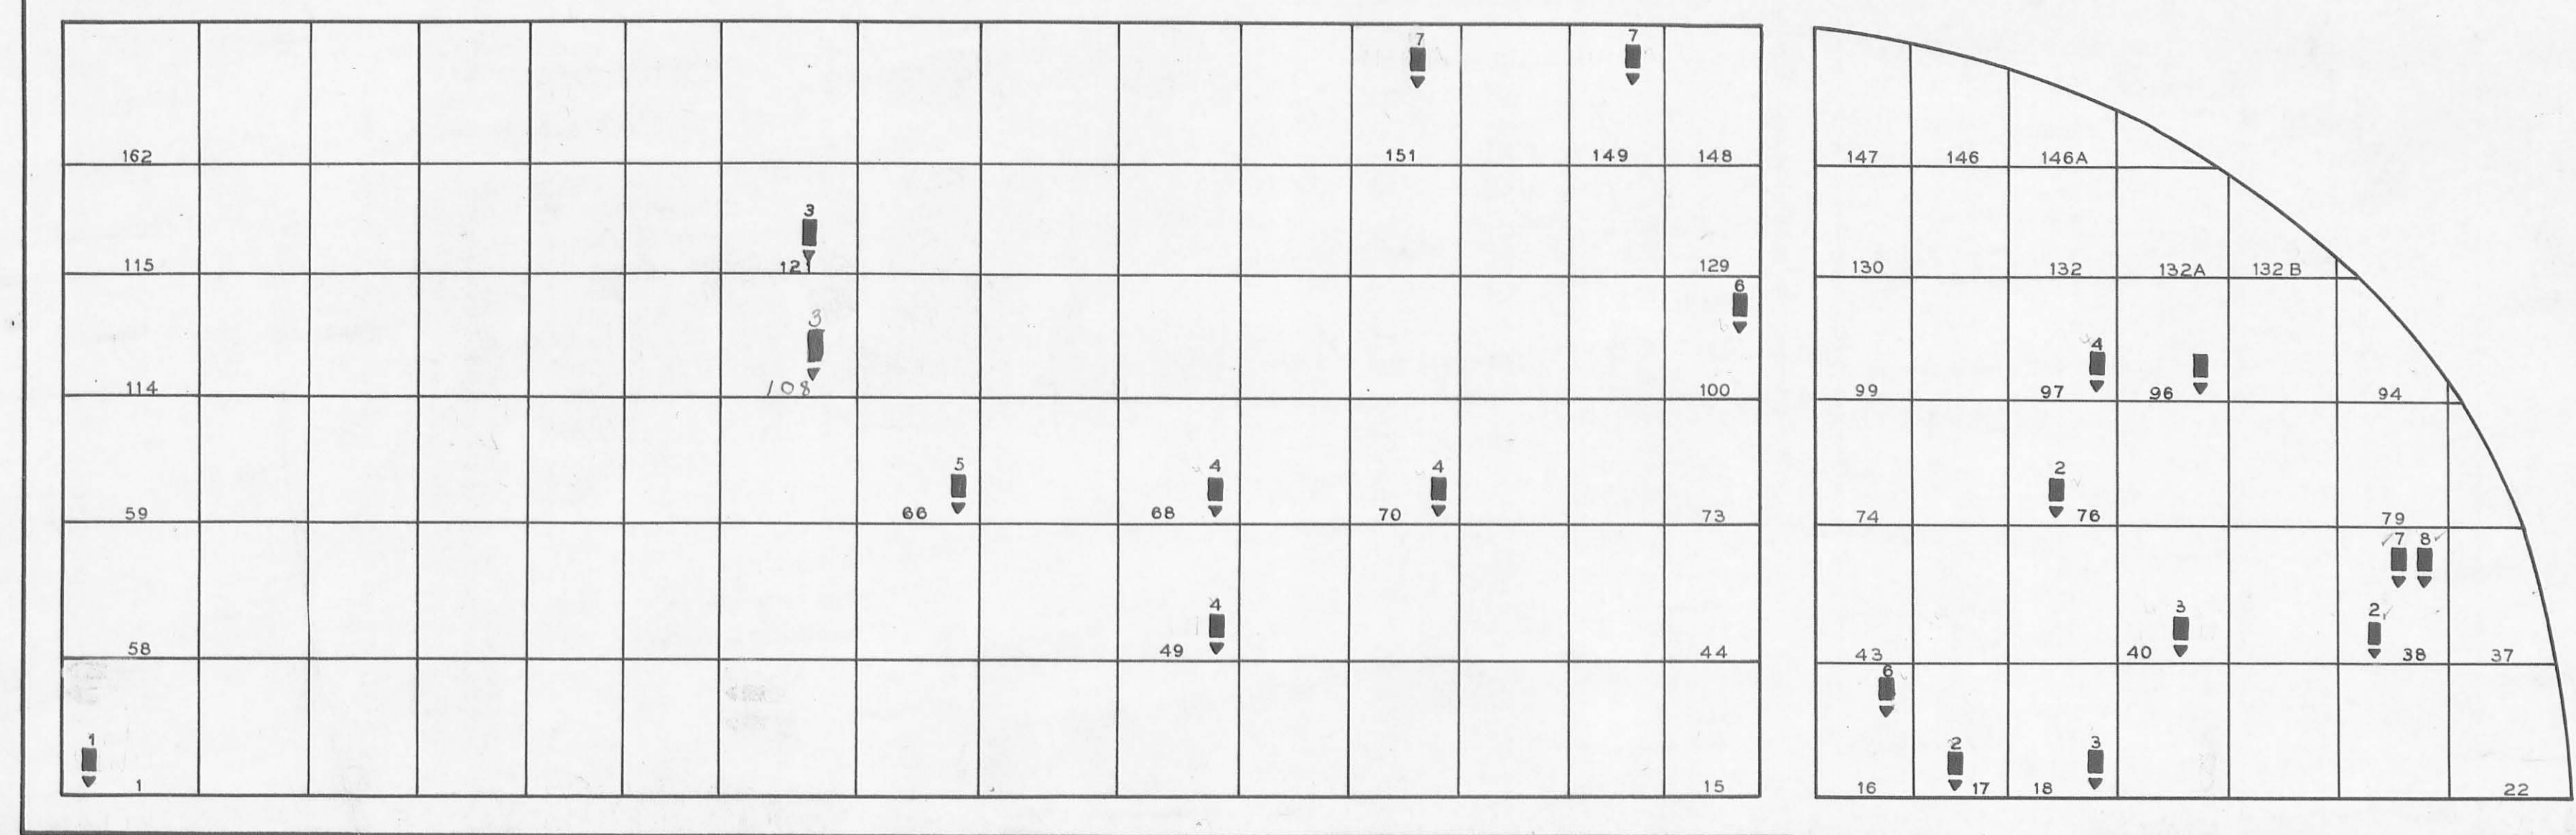


SECTION A

W.H.S.
SCALE 1"=20'

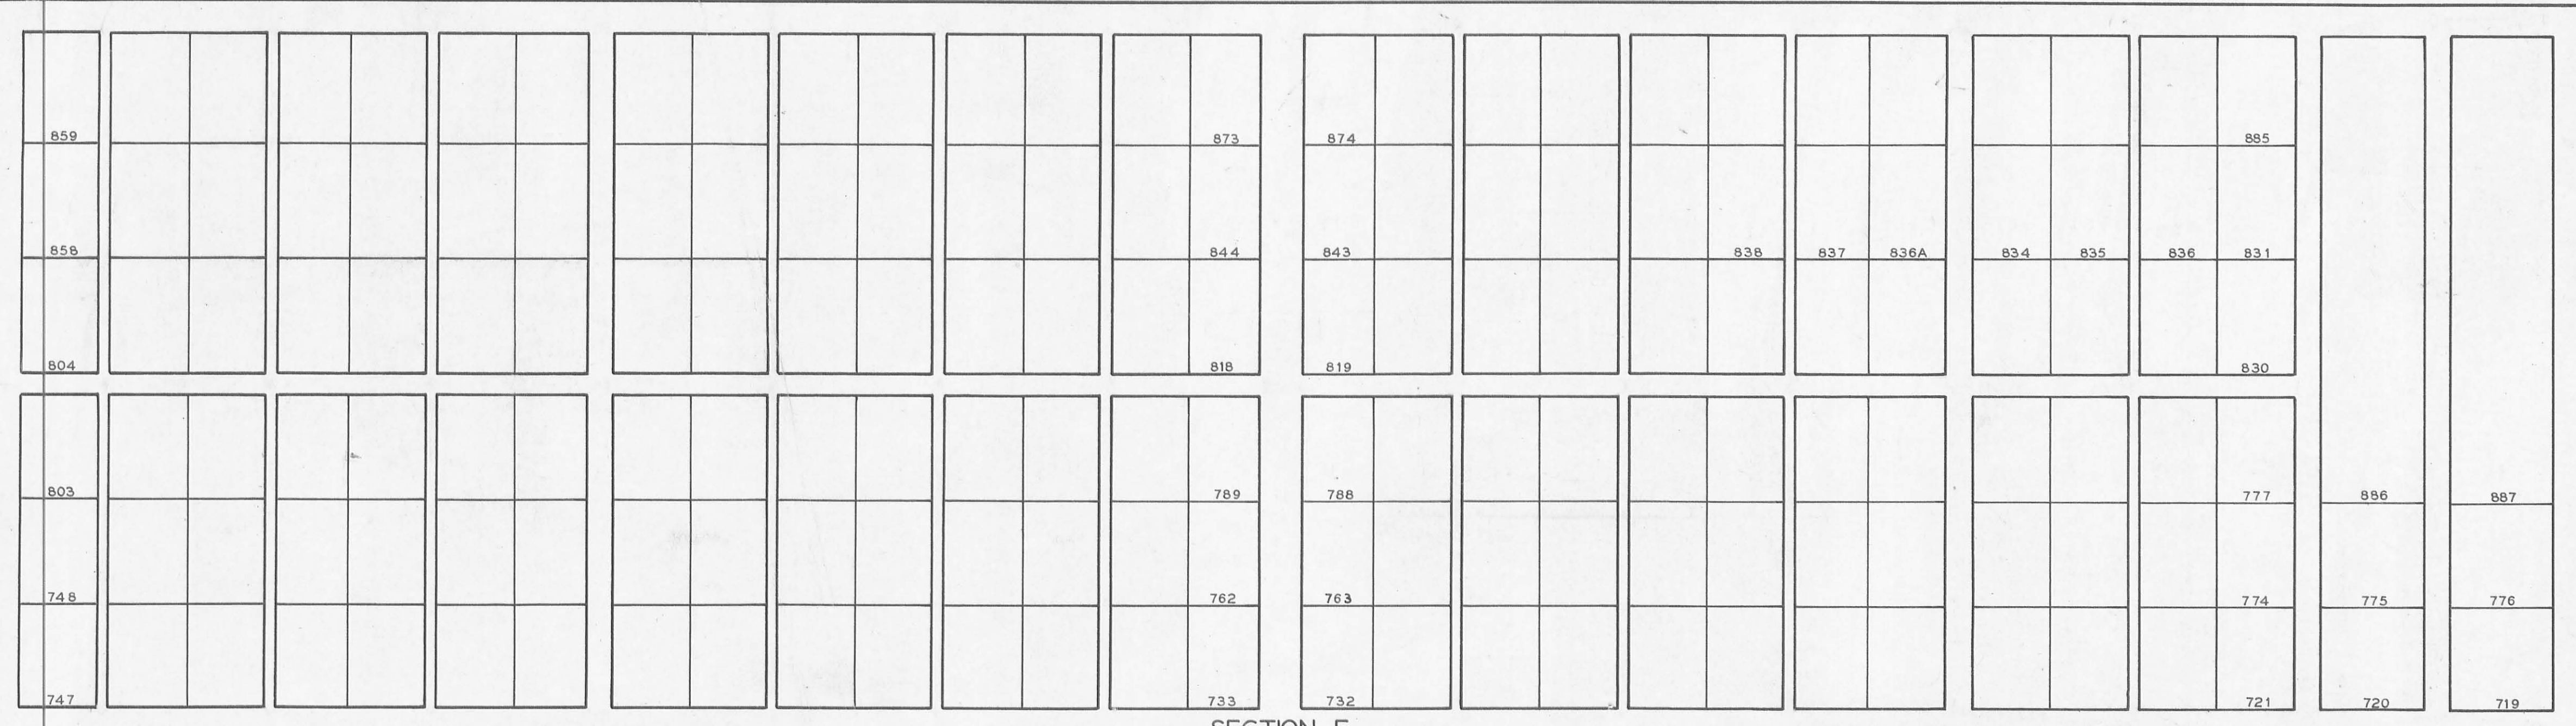

SECTION E


LEGEND
SEC=SECTION L=LOT R=ROW
G=GRAVE W=WAR
X=POSITION UNKNOWN

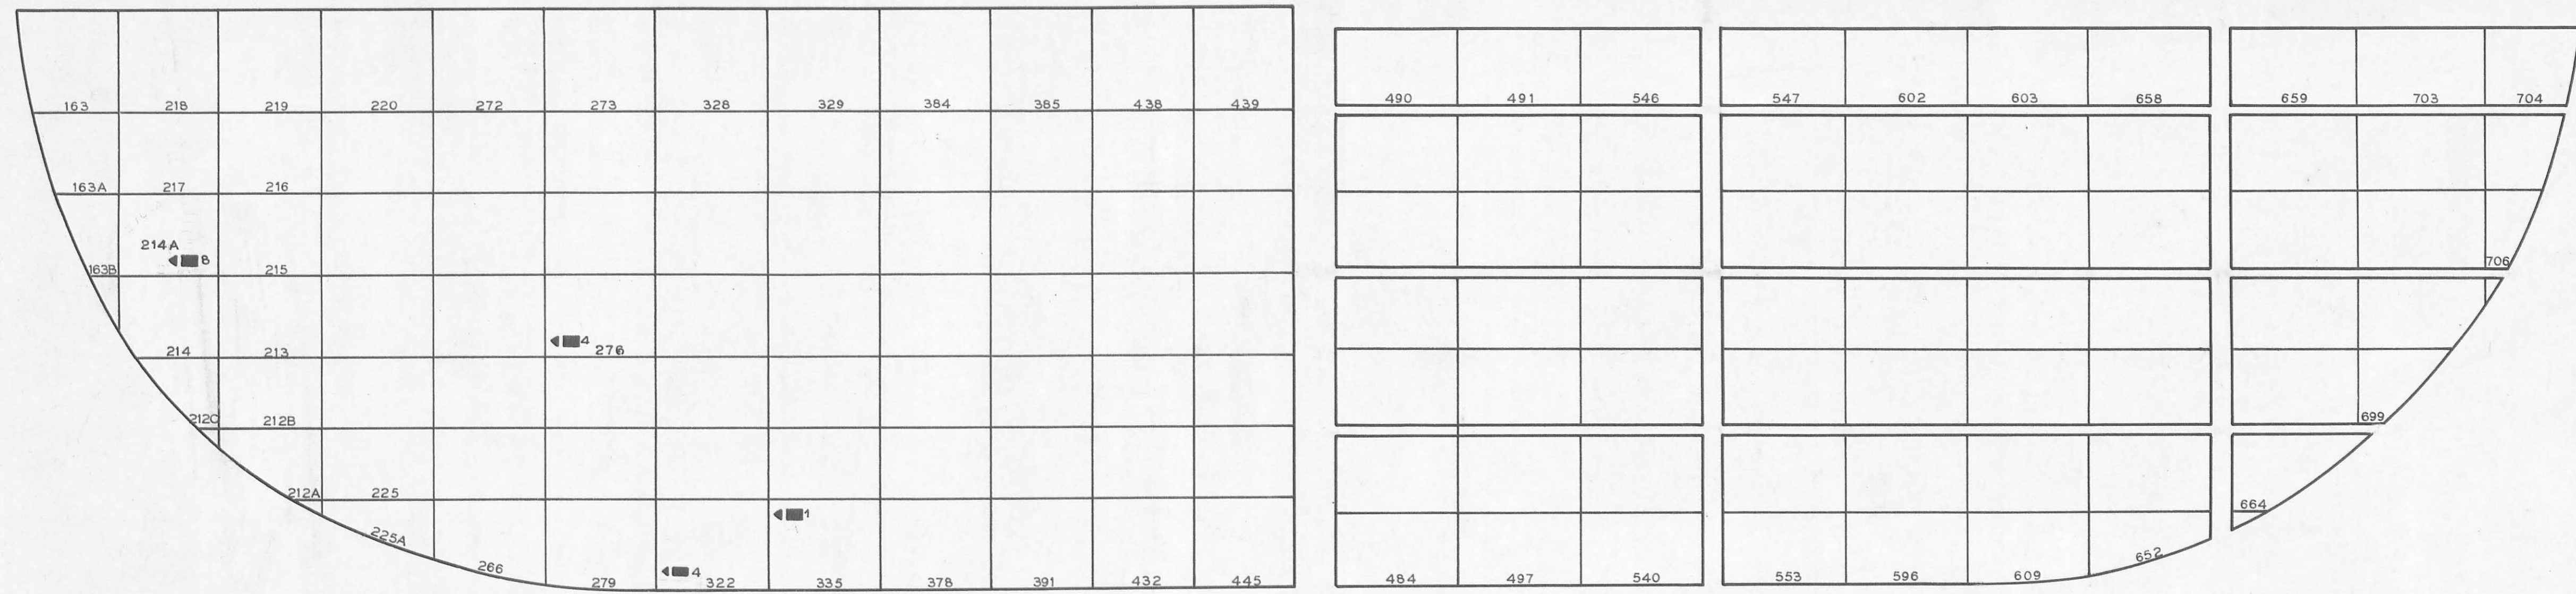

SECTION B



SCALE 1"=20'

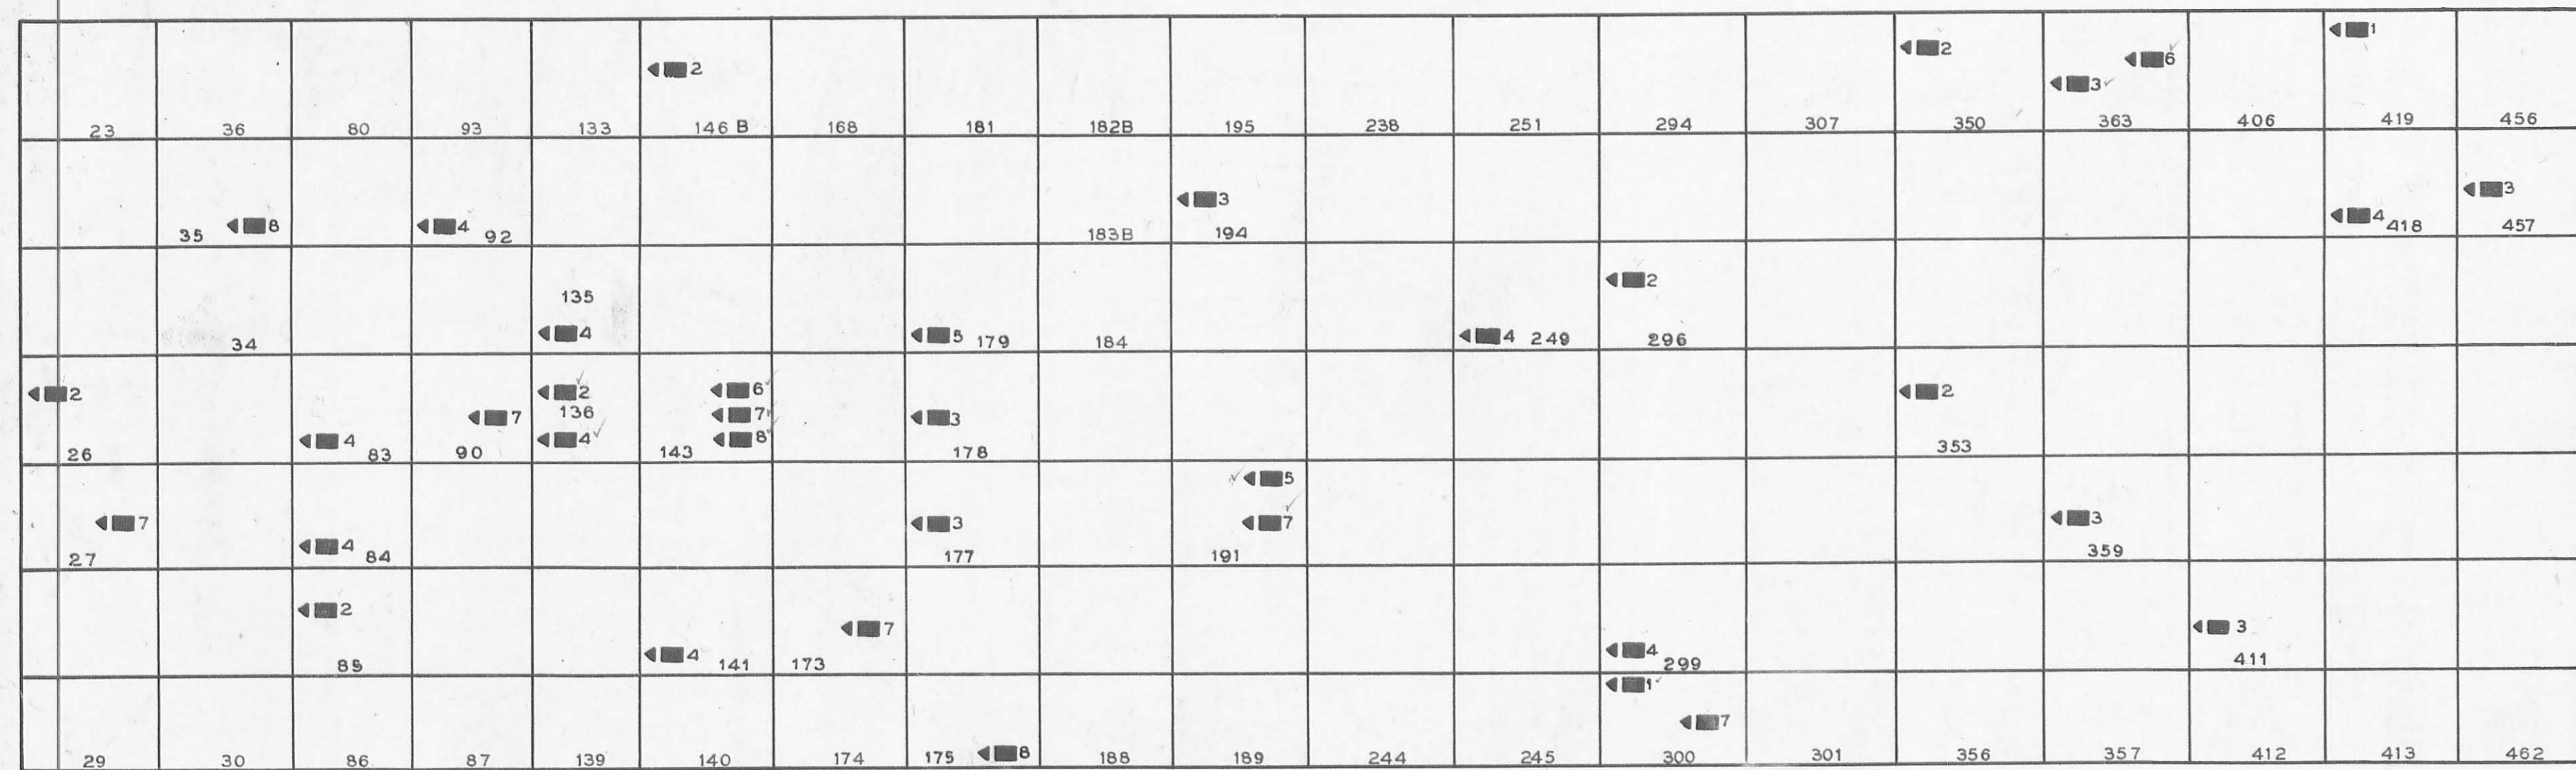


SECTION D

NAME	SEC	L	R	G	W
ALEXANDER JOHN W	135		4	19	
ALEXANDER W M	143		7	19	
ASHBY JOHN	136		2	19	
BASIL ADAM	411	D	4	19	
BANNING JOHN C	418		4	19	
BECK HIRAM	35		8	19	
BENSHOFF JOHN F	179		5	19	
CARNES MARTINVILLE	26		2	19	
CULLISON RICHARD W	146-B		4	19	
DAUGHERTY JOHN B	249	D	4	19	
DRAKE FRANCIS M	363		3	19	
GIRARD WILLIAM W	300		1	31	
GROW HENRY	143		8	19	
HANNUM WM M	335		1	19	
HENDERSHOUT WILLIAM H	85		2	19	
HESS WM	296		2	19	
JOHNSON A	299		4	19	
JONES GEO W	173		7	25	
KIRK DAVID W	194		3	19	
MANAHAN CLAYTON F	92		4	31	
MARLOW WM T	457		3	19	
MILLER SAMUEL T	141		4	19	
MCCLAIN JAS	353		2	19	
MC KINNON BENJAMIN W	177		3	19	
PATTERSON J. C.	322	B	4	19	
PENDERGAST JOHN W	136		4	19	
PRICE OSMAN	359		3	19	
PIERSON CLAUD	191		5	31	
RAGAN JAMES K P	300		7	19	
RUNION JACOB	90		7	19	
RUSSELL WM H	84		4	19	

NAME	SEC	L	R	G	W
SEELEY WILLIAM S	27		7	31	
SCOTT WM M	419		1	19	
SMITH ARCHIBALD N	143		6	19	
STEWART JAMES I	214-A		8	19	
WILCOX ALEXANDER	191		7	19	
WILCOX JOHN	178		3	19	
WILLIAMS JEFFERSON	363		6	19	
WILLETT SAMUEL L	83		4	19	
WINDHAM HAROLD C	276		4	31	
WISECUP NOAH	175		8	19	
WYLIE ABRAHAM P	350		2	19	

LEGEND
 SEC=SECTION L=LOT R=ROW
 G=GRAVE W=WAR
 X=POSITION UNKNOWN

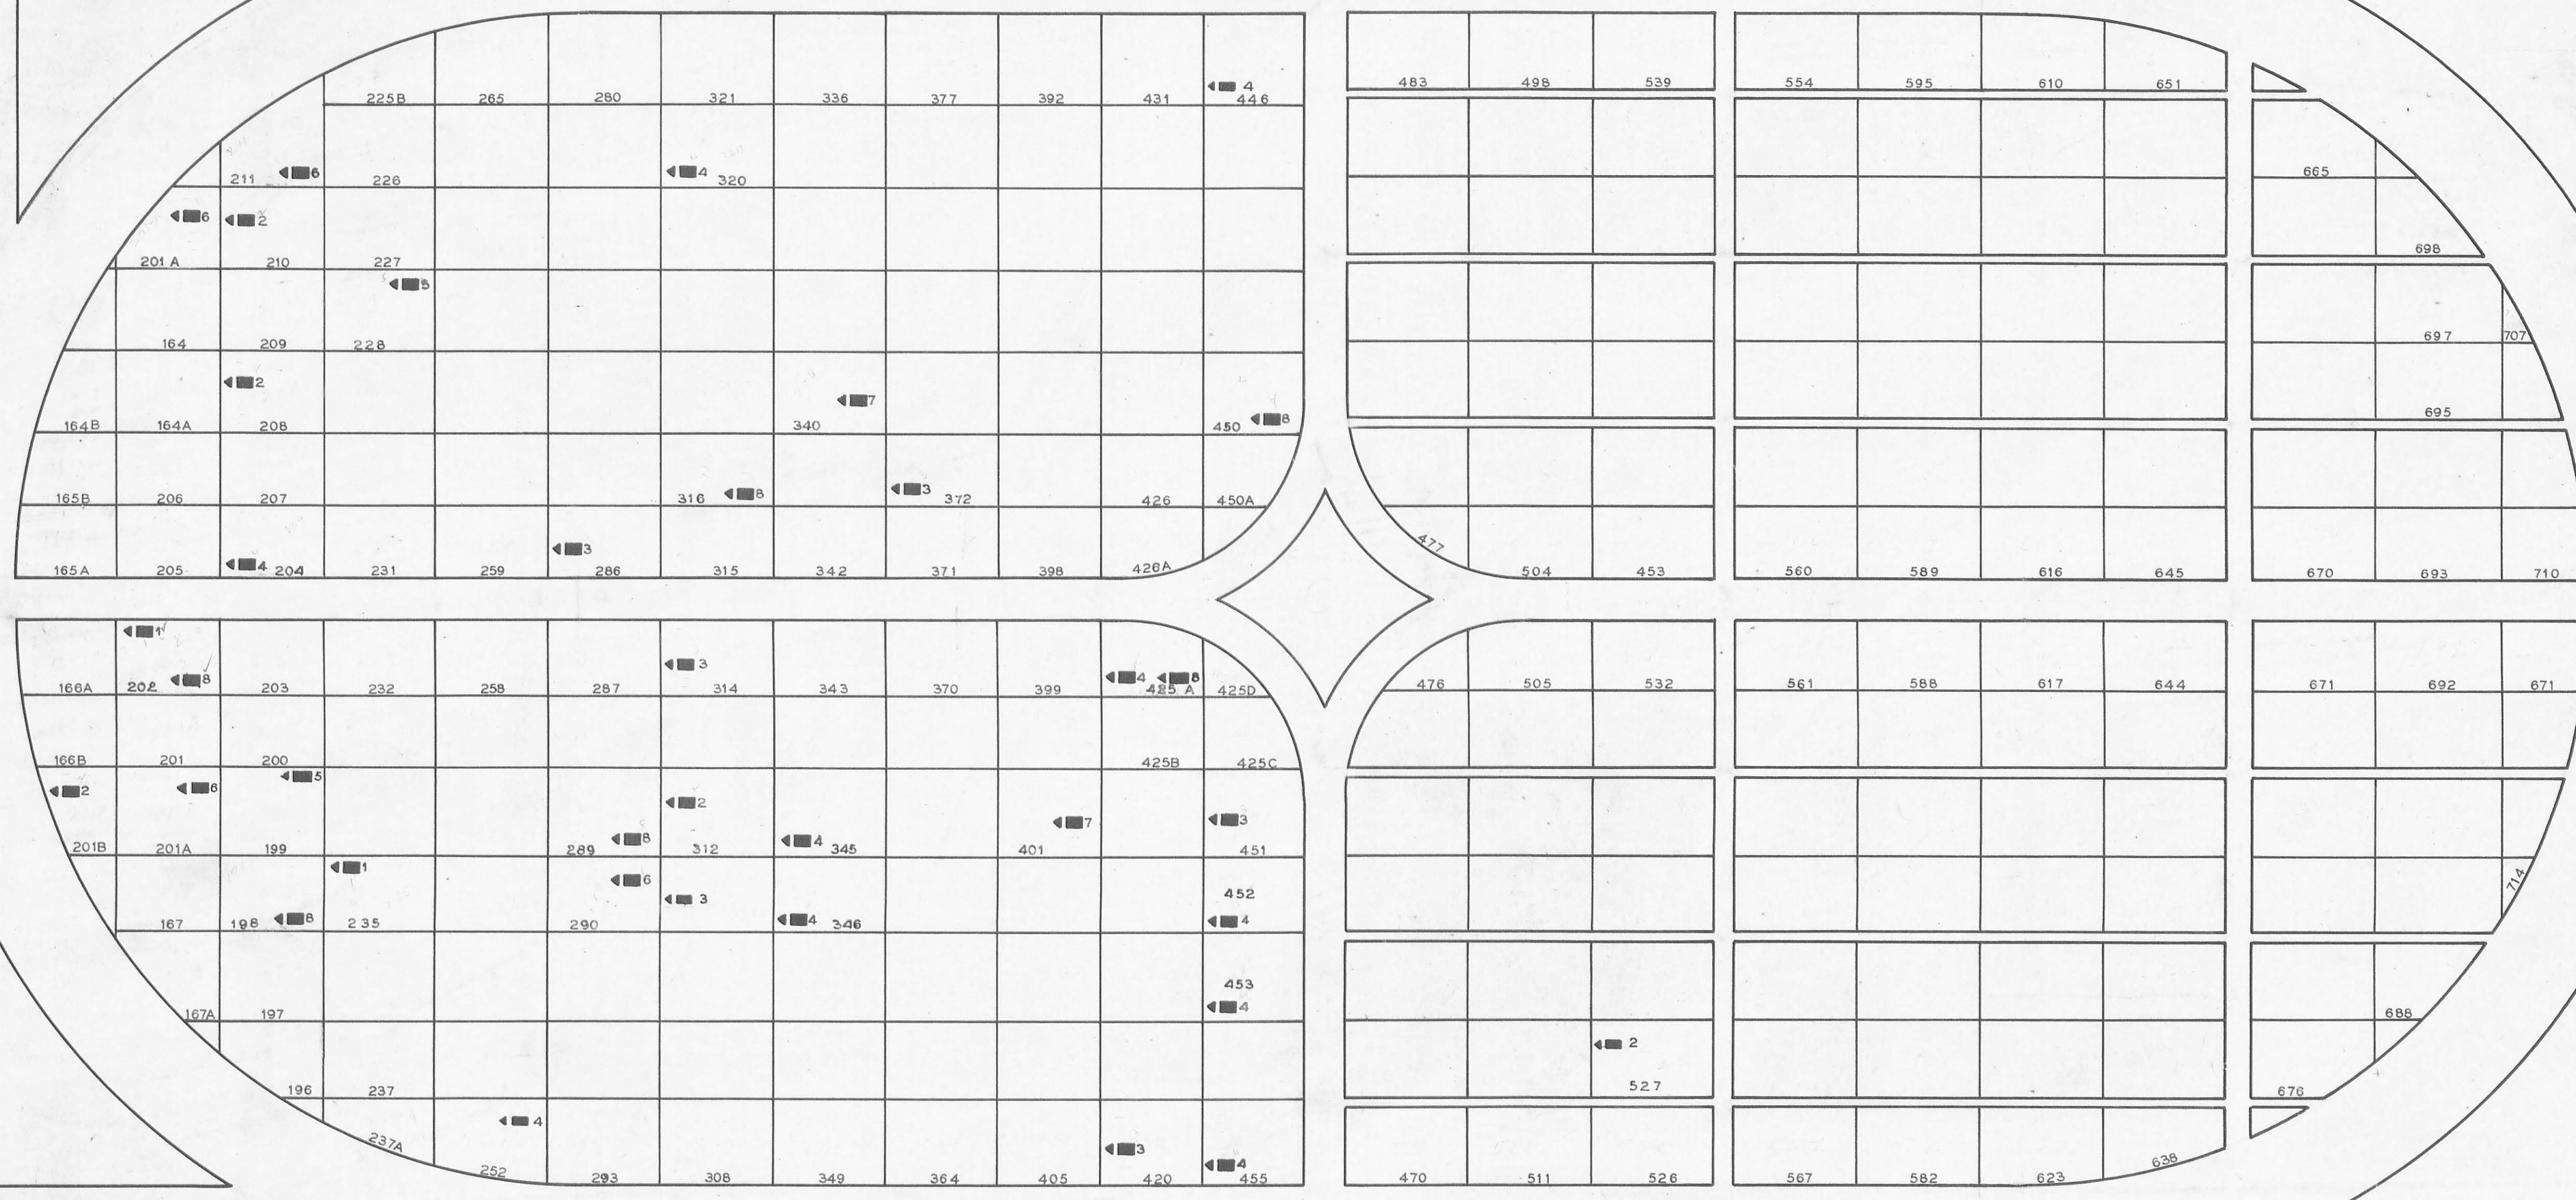

NAME	SEC	L	R	G	W
BENNETT JAS M		346		4	19
CARDER JOHN H		201-B		2	19
CLINT HENRY M		455		2	19
COLLINS JAMES		211		6	19
CRUMRINE JOHN C		420		3	19
DENNIS JOSEPH F		340		7	19
FRY JOHN CLAYTON		228		5	31
GLASGOW ROBERT F		453		4	19
HARROD THOMAS N		452		4	19
HULL JOSEPH		290		6	19
JEFFERS CHRISTIAN A		345		4	19
KIBLINGER BENJAMIN		286		3	19
LYLE JOHN W		210		2	19
MAINS CHARLES		425-A		4	19
MUSTAIN JAS B		235		1	19
MCCLURE ALANZO C		320		4	19
MC CONNELL ALEXANDER F		201-A		6	19
MCINTIRE EDWARD D		204		4	19
NELSON THOMAS		401		7	19
SCOTT JOHN		318		8	19
SESSLER THOMAS E		198		19	19
SOUT WILLARD E		372		3	19
SYDNER JACOB		314		6	19
VALENTINE ROLLA H C		289		8	19
VANDOSTRAN FRANCIS X		208		2	31
WINDHAM THOMAS H		312		19	19
WRIGHT BENJ F		202		19	19
WRIGHT BENN J		202		19	19
YOUNG ISAAC		450		8	19

SUPPLEMENTARY LIST


NAME	SEC	L	R	G	W
COVINGTON WM. H.	C	311		3	19
CURL CHARLES H.	C	454		3	19
NASH CLARENCE R.	C	446		4	31
SAYLOR GEORGE W.	C	527		2	19
WALLACE WILLIAM C.	C	252		4	19
MAINS EDWARD H.	C	425 A		6	19
HARROD MINOR S.	C	199		5	19

SECTION C

SCALE 1"=20'

LEGEND
 SEC=SECTION L=LOT R=ROW
 G=GRAVE W=WAR
 X=POSITION UNKNOWN

NAME	SEC	L	R	G	W
BROWN WILLIAM H.			8	14	19
FULTON JOSEPH G.			12	41	
FULTON THOMAS			12	40	10
JOHNSON GEORGE W.			15	18	19
KIRKLAND WILLIAM A.	3			8	19
MITCHELL MATTHEW			12	28	10
PASH COLBERT F. B.	4			1	19
MITCHELL MATTHEW		13		26	

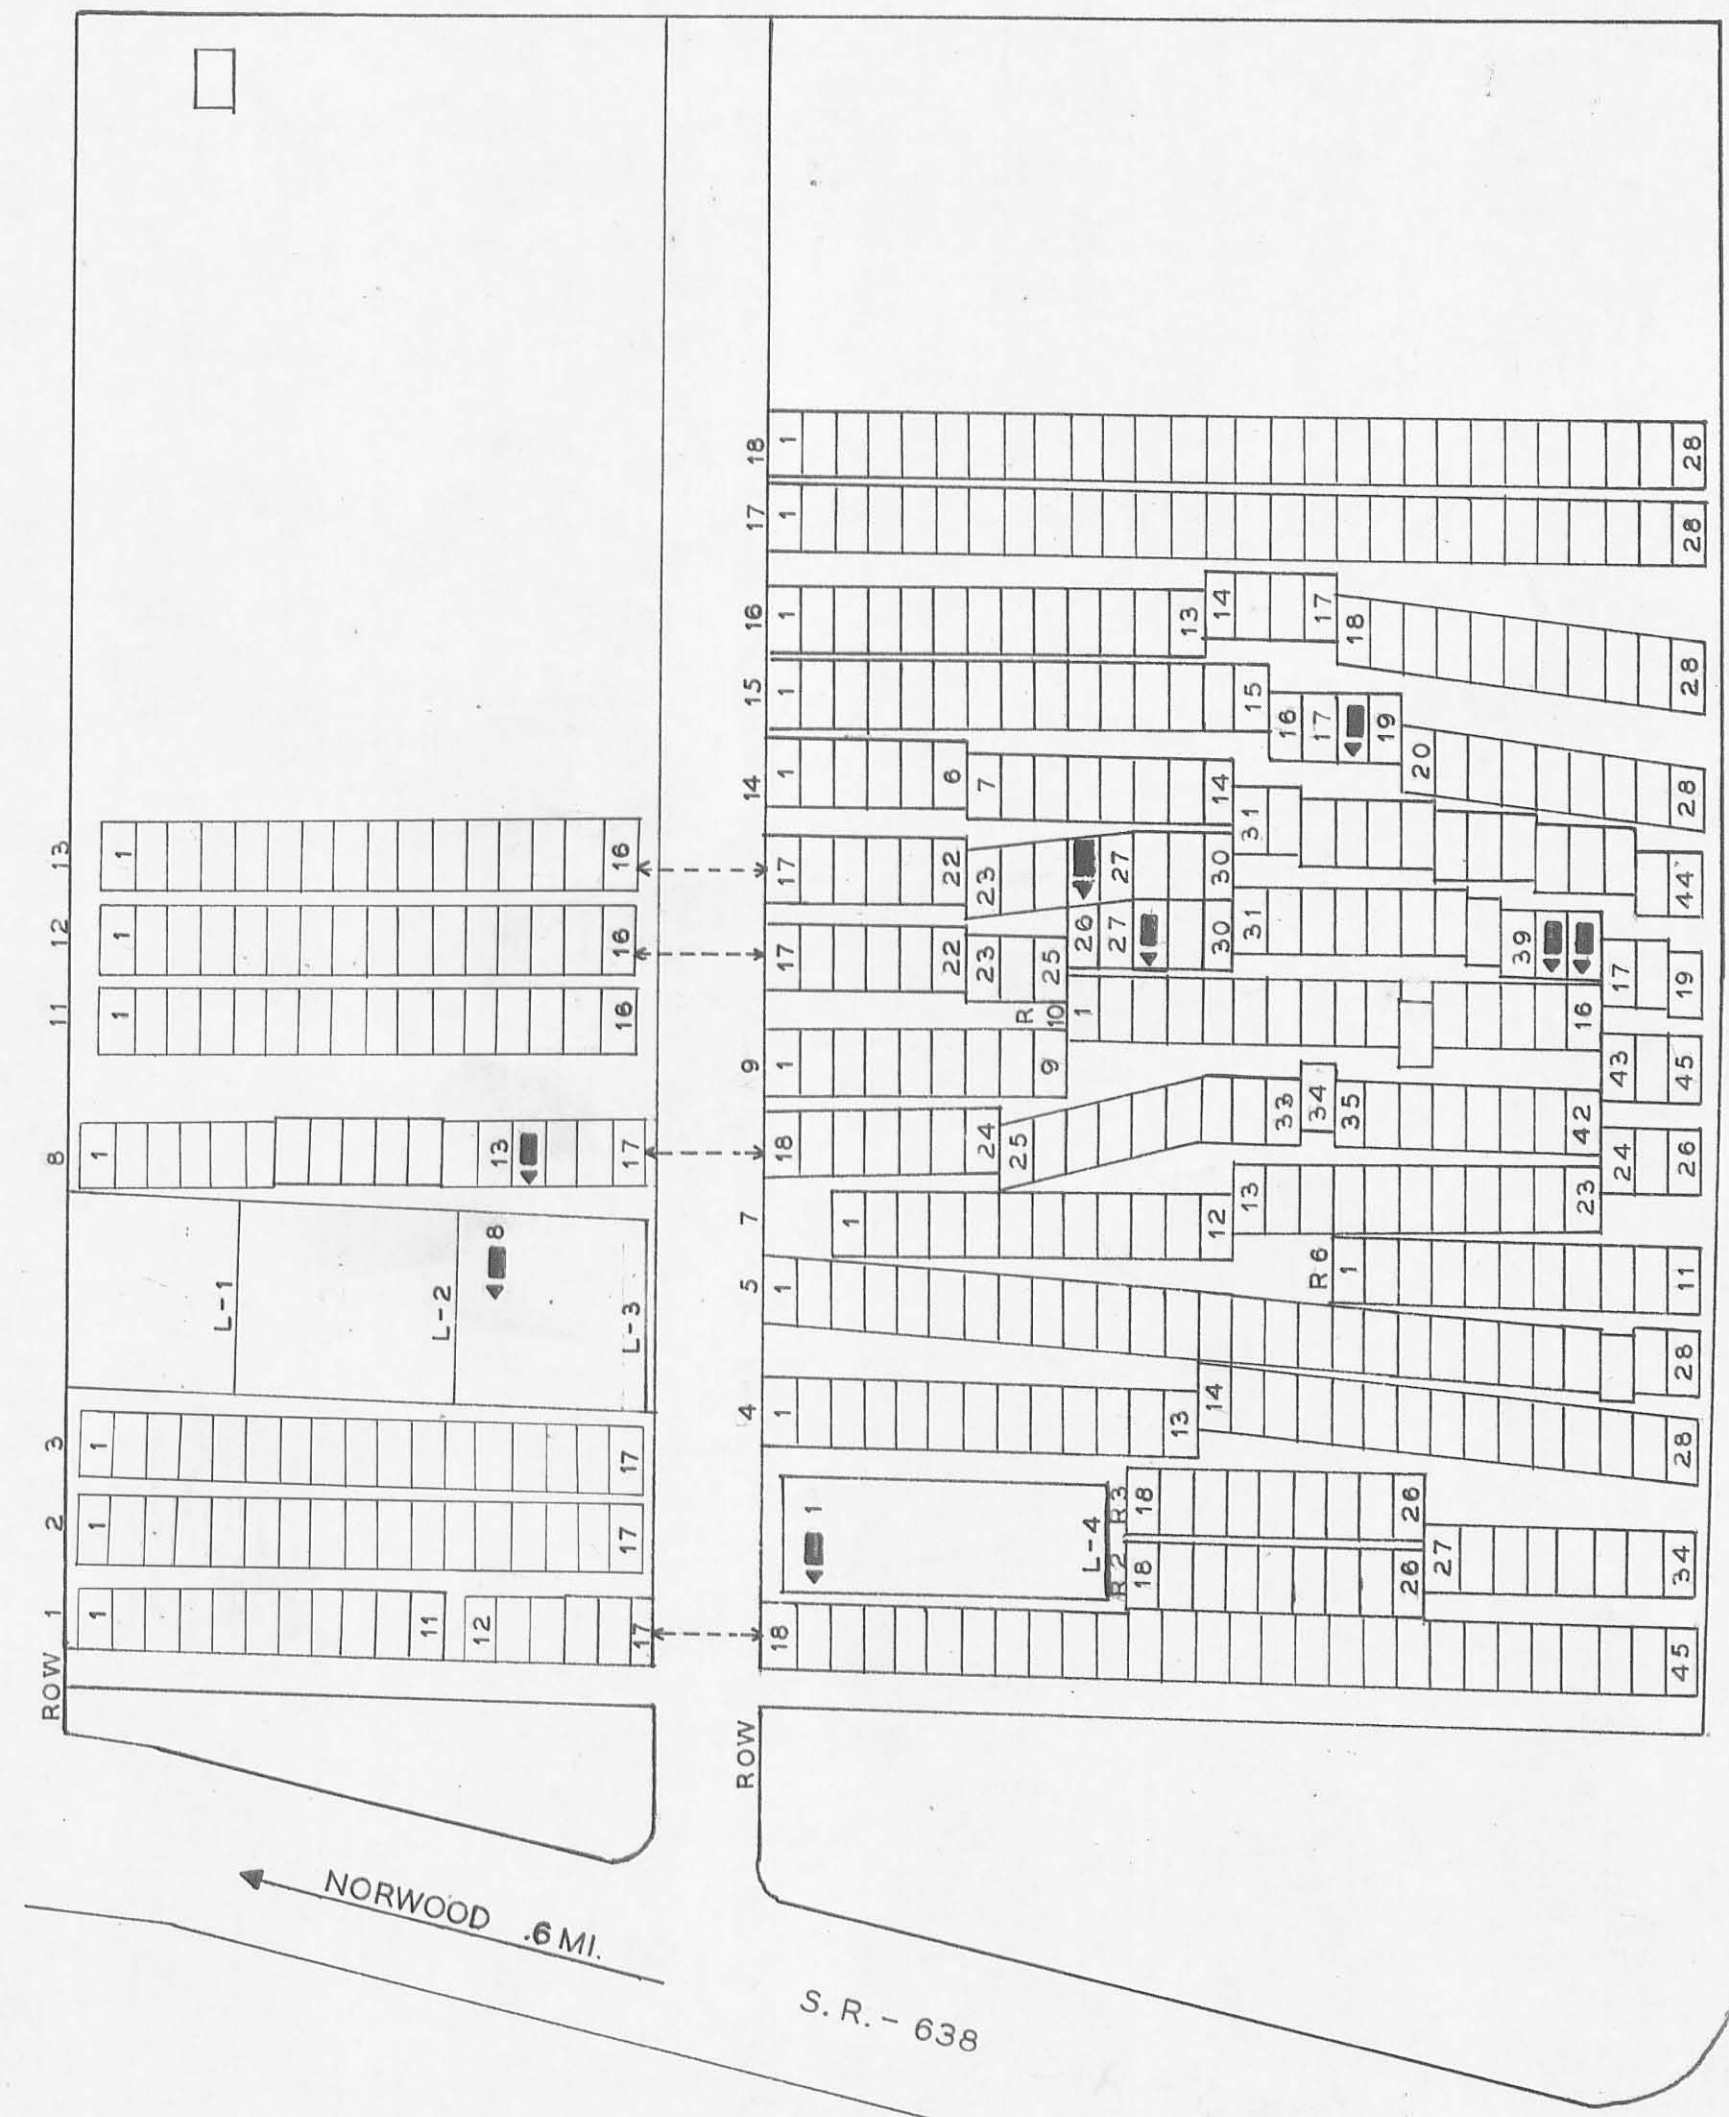

S. R. - 274

4775

FULTON CEMETERY

LOGAN CO. M^CARTHUR TWP.

OFFICIAL PROJECT NOS. 465-42-3-467&665-42-3-232

<p>LEGEND</p> <p>① REVOLUTIONARY WAR</p> <p>⑩ WAR OF 1812</p> <p>⑱ MEXICAN WAR</p> <p>⑳ CIVIL WAR</p> <p>㉕ SPANISH AM. WAR</p> <p>㉖ WORLD WAR</p>	<p>HISTORY</p>
--	-----------------------

SCALE 1" = 20' ACRES 0.75

46-7-3

NAME	SEC	L	R	G	W
AIKEN D. C.				9	5 19
BROWN WM. H.				1	38 19
BIYAN JOHN W.				3	30
COOPER JOHN				20	18 19
COOPER JOHN				19	46 10
COWGILL ALONZO G.				17	4 19
COWGILL ARRON				15	4 19
COWGILL JONATHAN G.				8	35 19
FOLK HENRY E.	14				6
FOSTER H. H.				15	35 19
GARWOOD PERL				7	27 19
GARWOOD SPENCER W.				7	30 19
INSKEEP HIRAM M.				8	48 19
JORDAN WILLIAM H.	25				5 19
MARSHALL WM. C.				10	8
NORVIEL D. S.				1	33 19
ORAN MARION G.				2	43 19
STOKES OLIVER P.	26				2 19
WARNER MILLER				2	27 19



T - 153

0.2 MI.

MIDDLEBURG 1.4 MI.

T - 157

LEGEND
 SEC=SECTION L=LOT R=ROW
 G=GRAVE W=WAR
 X=POSITION UNKNOWN

GARWOOD CEMETERY

LOGAN CO. ZANE TWP.

OFFICIAL PROJECT NOS. 465-42-3-467 & 665-42-3-232

LEGEND	HISTORY
① REVOLUTIONARY WAR	
⑩ WAR OF 1812	
⑮ WAR WITH MEXICO	
⑰ CIVIL WAR	
⑳ SPANISH AM. WAR	
⑳ WORLD WAR	
SCALE 1"=20'	1.4 ACRES