


NAME	SEC	L	R	G	W
COE BENJAMIN	6		67	19	
COOVER WILLIAM	8		34	19	
DICKINSON THOMAS	1		17	10	
ELLIOT JOSEPH E	3		63	19	
ELLIOT THOMAS	1		2	19	
FRENCH JOSEPH	7		63	19	
LAPORT ZEPHANIAH	5		5	19	
MARMON JOSEPH E	6		63	19	
REAMES EZRA	7		44	19	
REAMES CALEB	11		2	10	
REAMES JEREMIAH	11		1	10	
WATKINS BENJAMIN	1		58	10	
WATKINS ENOS B.	6		28		
WATKINS EZEKIEL	4		6	19	
WICKERSHAM JOSEPH	1		7	10	

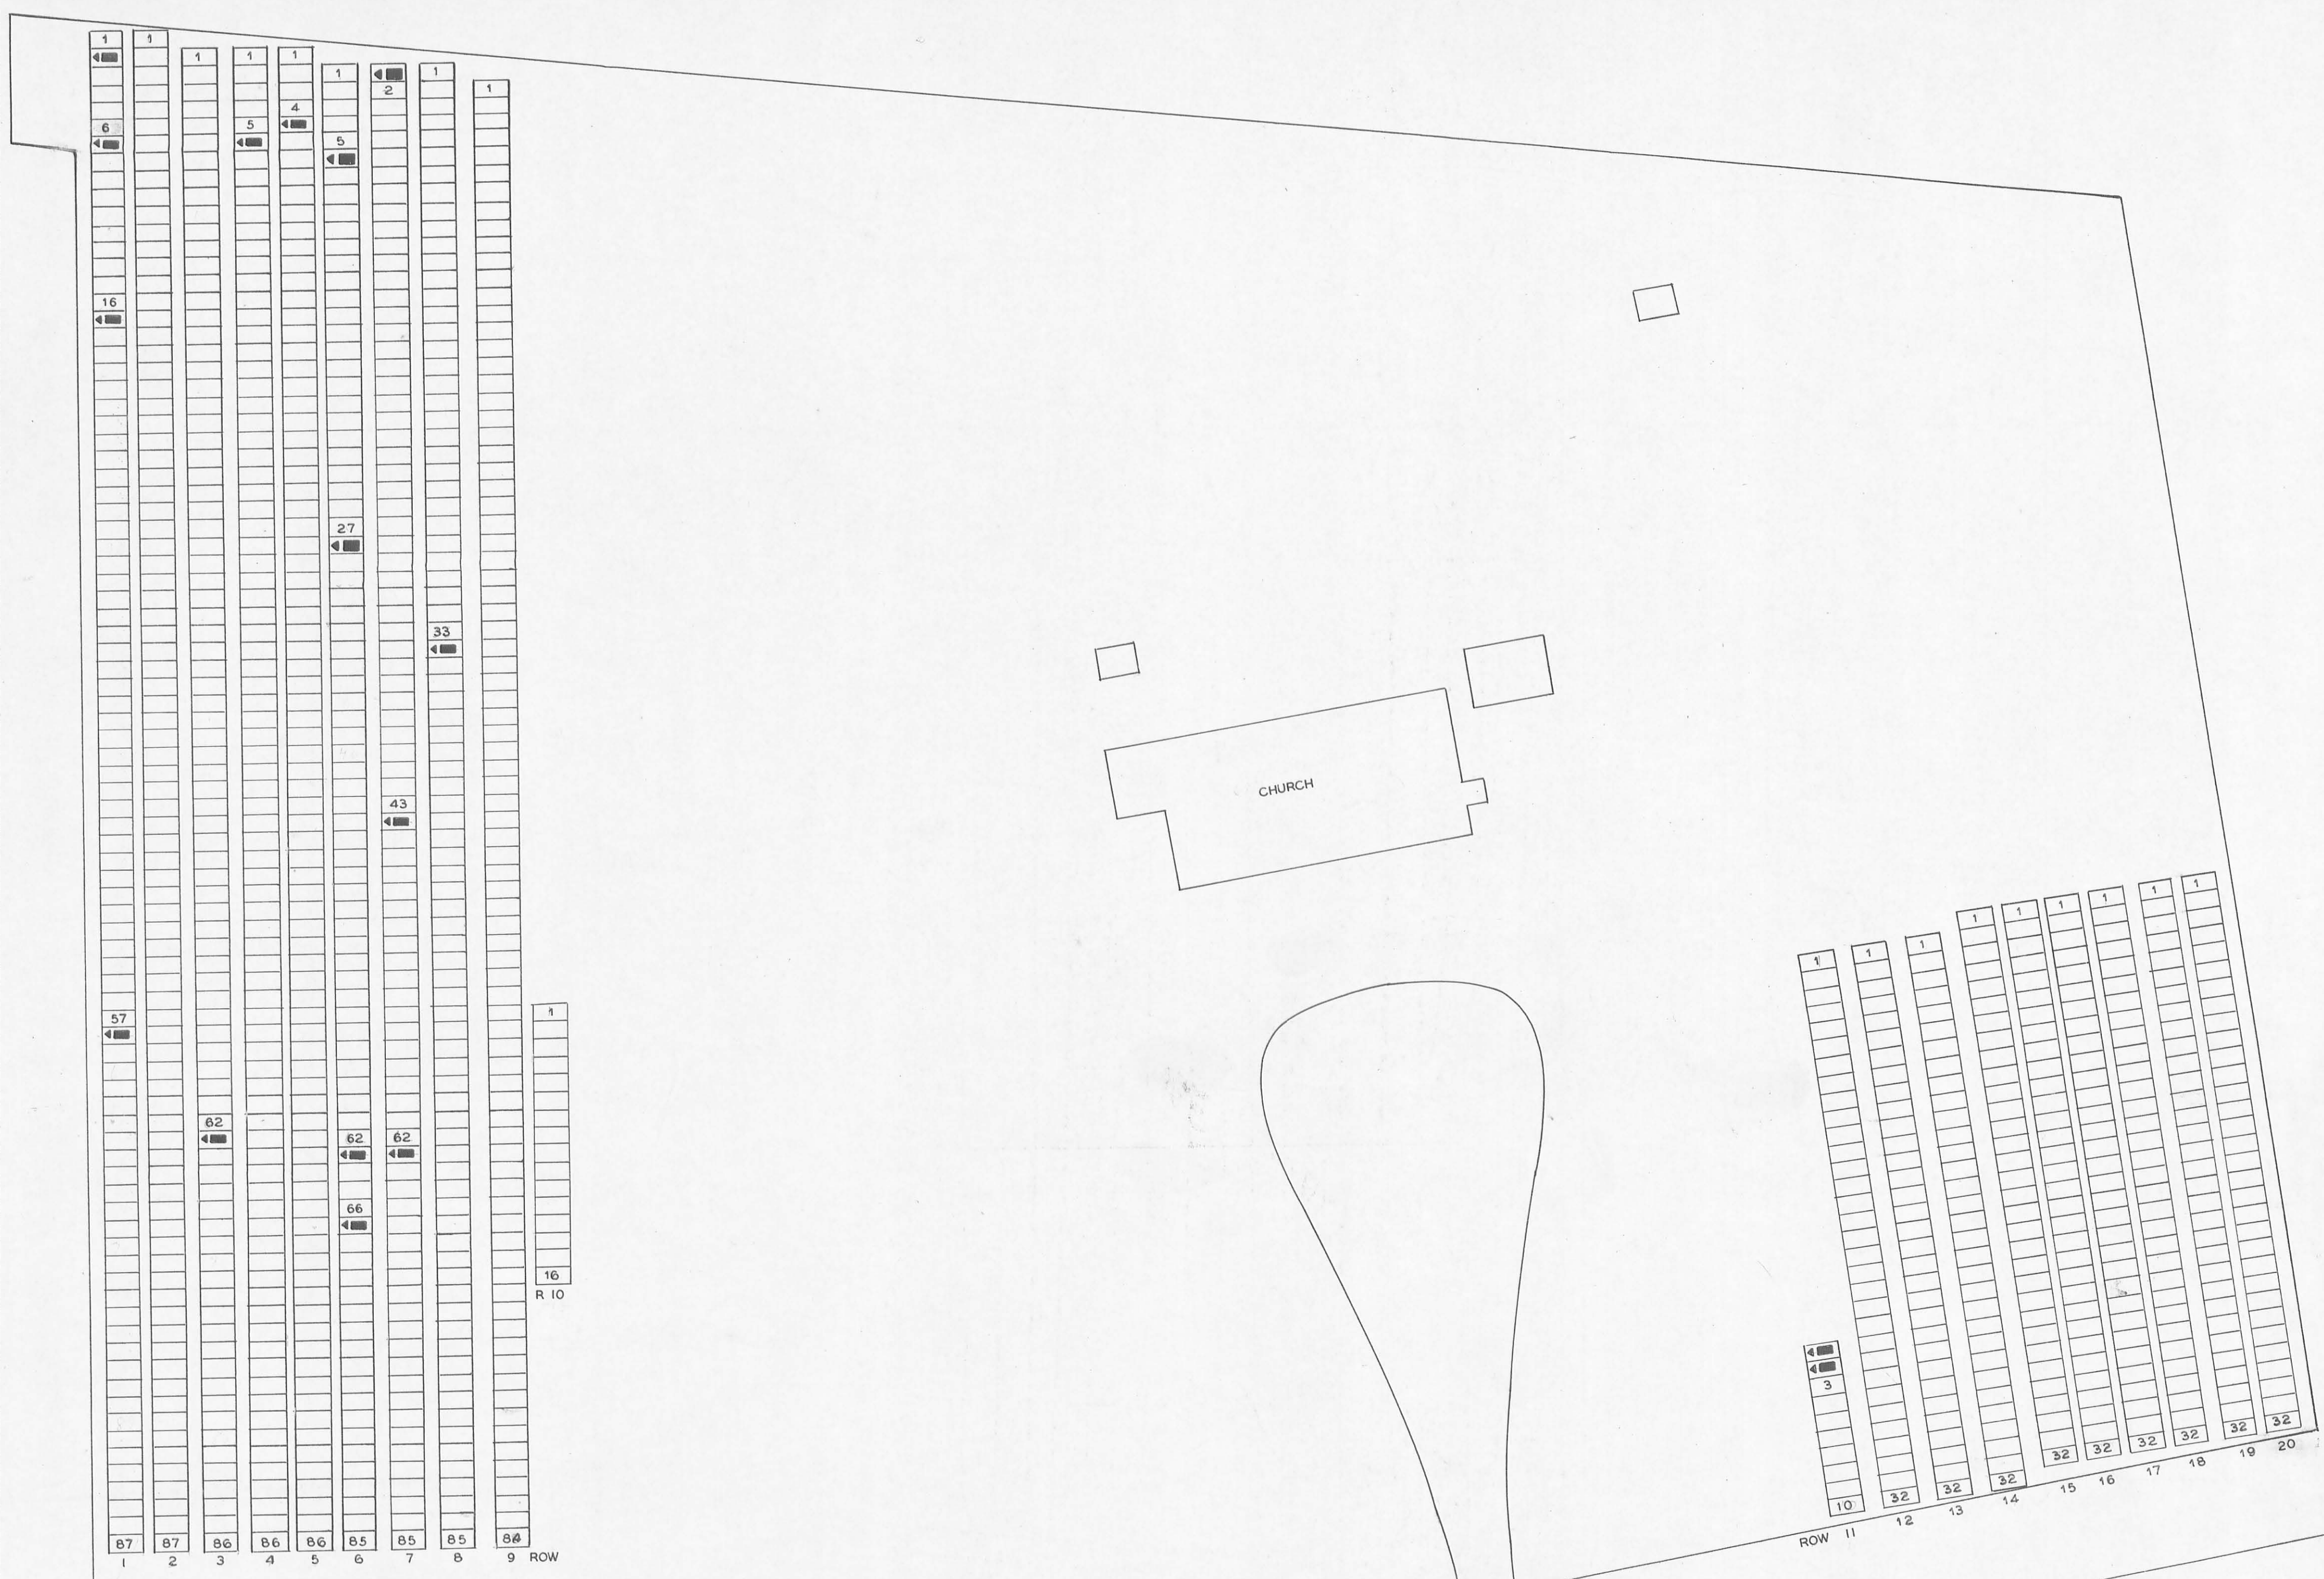

SCALE 1"=20'

GOSHEN CEMETERY

LOGAN CO. JEFFERSON TWP.

OFFICIAL PROJECT NOS. 465-42-3-467 & 665-42-3-232

LEGEND	HISTORY
①	REVOLUTIONARY WAR
⑩	WAR OF 1812
⑪	MEXICAN WAR
⑬	CIVIL WAR
⑳	SPANISH AM. WAR
㉑	WORLD WAR

SCALE 1"=20'
ACRES 2.00

LEGEND
 SEC=SECTION L=LOT R=ROW
 G=GRAVE W=WAR
 X=POSITION UNKNOWN

ZANESFIELD 1 MI. ←
 U.S. - 33

C-28

46-4-2

WESTMANS FIELD 2 MI.

C-142

2 MI TO C-2



NAME	SEC	L	R	G	W
BALDWIN ALSINAS			10	5	19
BRANNAN RICHARD	11			2	
BRANSON JAMES H.	13			3	
CASTLE WILLIAM N.	6			3	19
CLAPSADLE FRED R.	227			5	31
COLBERT ICHABOD C.	27			5	19
CURL WILLIAM H.	105			3	19
DOWELL GEORGE H.	66			4	19
FISHER CHARLES			11	18	19
FRY HENRY	71			3	19
FRY ROBERT	41			3	19
FOUT JASPER	27			2	19
GORDON JAMES R.	32		7	2	19
GORDON JOHN E.				31	18
GRANT NATHANIEL C.	54			2	19
GREEN HADI	77			2	
HAMILTON JEREMIAH	97			3	19
HARSHFIELD ARMAND	169			5	31
HATCHER WILLIAM	18			6	19
HOSACK WILLIAM	11			4	19
HOWARD PETER			4	7	1
KELLER FREDERICK D.	48			5	19
KELLER FREDERICK T. J.	32			5	19
KELLER JOSEPH A.	86			3	19
KELLER WILLIAM S.				3	19
LINE WILLIAM A.			18	14	19
MANN EDWARD S.			5	3	19
MC CULLY MILTON	31			2	19
MC DONALD HAMILTON	14			5	19
PAINTER R. M.			18	18	19
PERKINS ATLAS			4	21	19
PERKINS LEONIDAS			4	22	19
POWELL JOSHUA			1	11	19
REA JOHN			6	5	10
RILEY ANDREW A.	5			2	19
RILEY WILLIAM B.	63			6	19
RUDISILLY HENRY			1	26	1
SIMPSON DANIEL	46			3	19
SKIDMORE CALVIN			7	20	19
SKIDMORE JOHN F.			20	14	19
SKIDMORE JOSEPH			18	21	19
SKIDMORE THOMAS	80			2	19
SKIDMORE WILLIAM			6	12	19
SMITH C. C.	36			4	19
TALLMAN J. W.			18	26	19
UNDERWOOD ALONZO	54			5	
UNDERWOOD HIRAM	122			4	19
VOTAW EMIL W.	128			2	31
WHITAKER JOSIAH			1	20	10
WHITAKER JOSIAH J.			1	25	18
WILGUS WILLIAM C.	110			6	19
WINNER LLOYD	28			3	31
SUPPLEMENTARY LIST					
ROBERTS PAUL			4	6	
TALLMAN BENJAMIN B.	39			1	19
HARSHFIELD DONALD	169			10	31

SSZ

**GREENLAWN
CEMETERY**

LOGAN CO. PERRY TWP.



OFFICIAL PROJECT NOS. 465-42-3-467 & 665-42-3-232

<p>LEGEND</p> <ul style="list-style-type: none"> ① REVOLUTIONARY WAR ⑩ WAR OF 1812 ⑯ WAR WITH MEXICO ⑰ CIVIL WAR ⑳ SPANISH AM. WAR ㉑ WORLD WAR 	<p>HISTORY</p>
---	-----------------------

SCALE 1" = 20' ACRES 4.00

46-10-3

NAME	SEC	L	R	G	W
AUSTIN ALBERT M.			8	13	19
AUSTIN JOHN H.			13	33	19
BEALS BEN. C.		6	16	19	
BRACKNEY GEORGE R.		17	18	19	
CHAMBERLAIN JEREMIAH		12	6	19	
DUNSON LEVI		19	18	19	
FISHER SHEPLER		11	11	19	
GREEK SAM'L		15	7	25	
HALL SAMUEL L.		5	10	31	
KITCHEN EDWARD		2	8	19	
LUSBY JOSIAH		2	45	19	
MILLER ELWOOD			2	50	31
MUSSELMAN JOHN A.	1	1	4	19	
RINGER BENJIMAN R.		17	27	19	
ROBERTS CALVIN		13	14	19	
ROBERTS JAMES		5	56	16	
WREN LEWIS		1	61	19	
WINTZ JOHN J.		1	56		

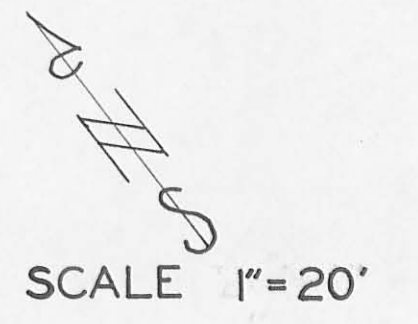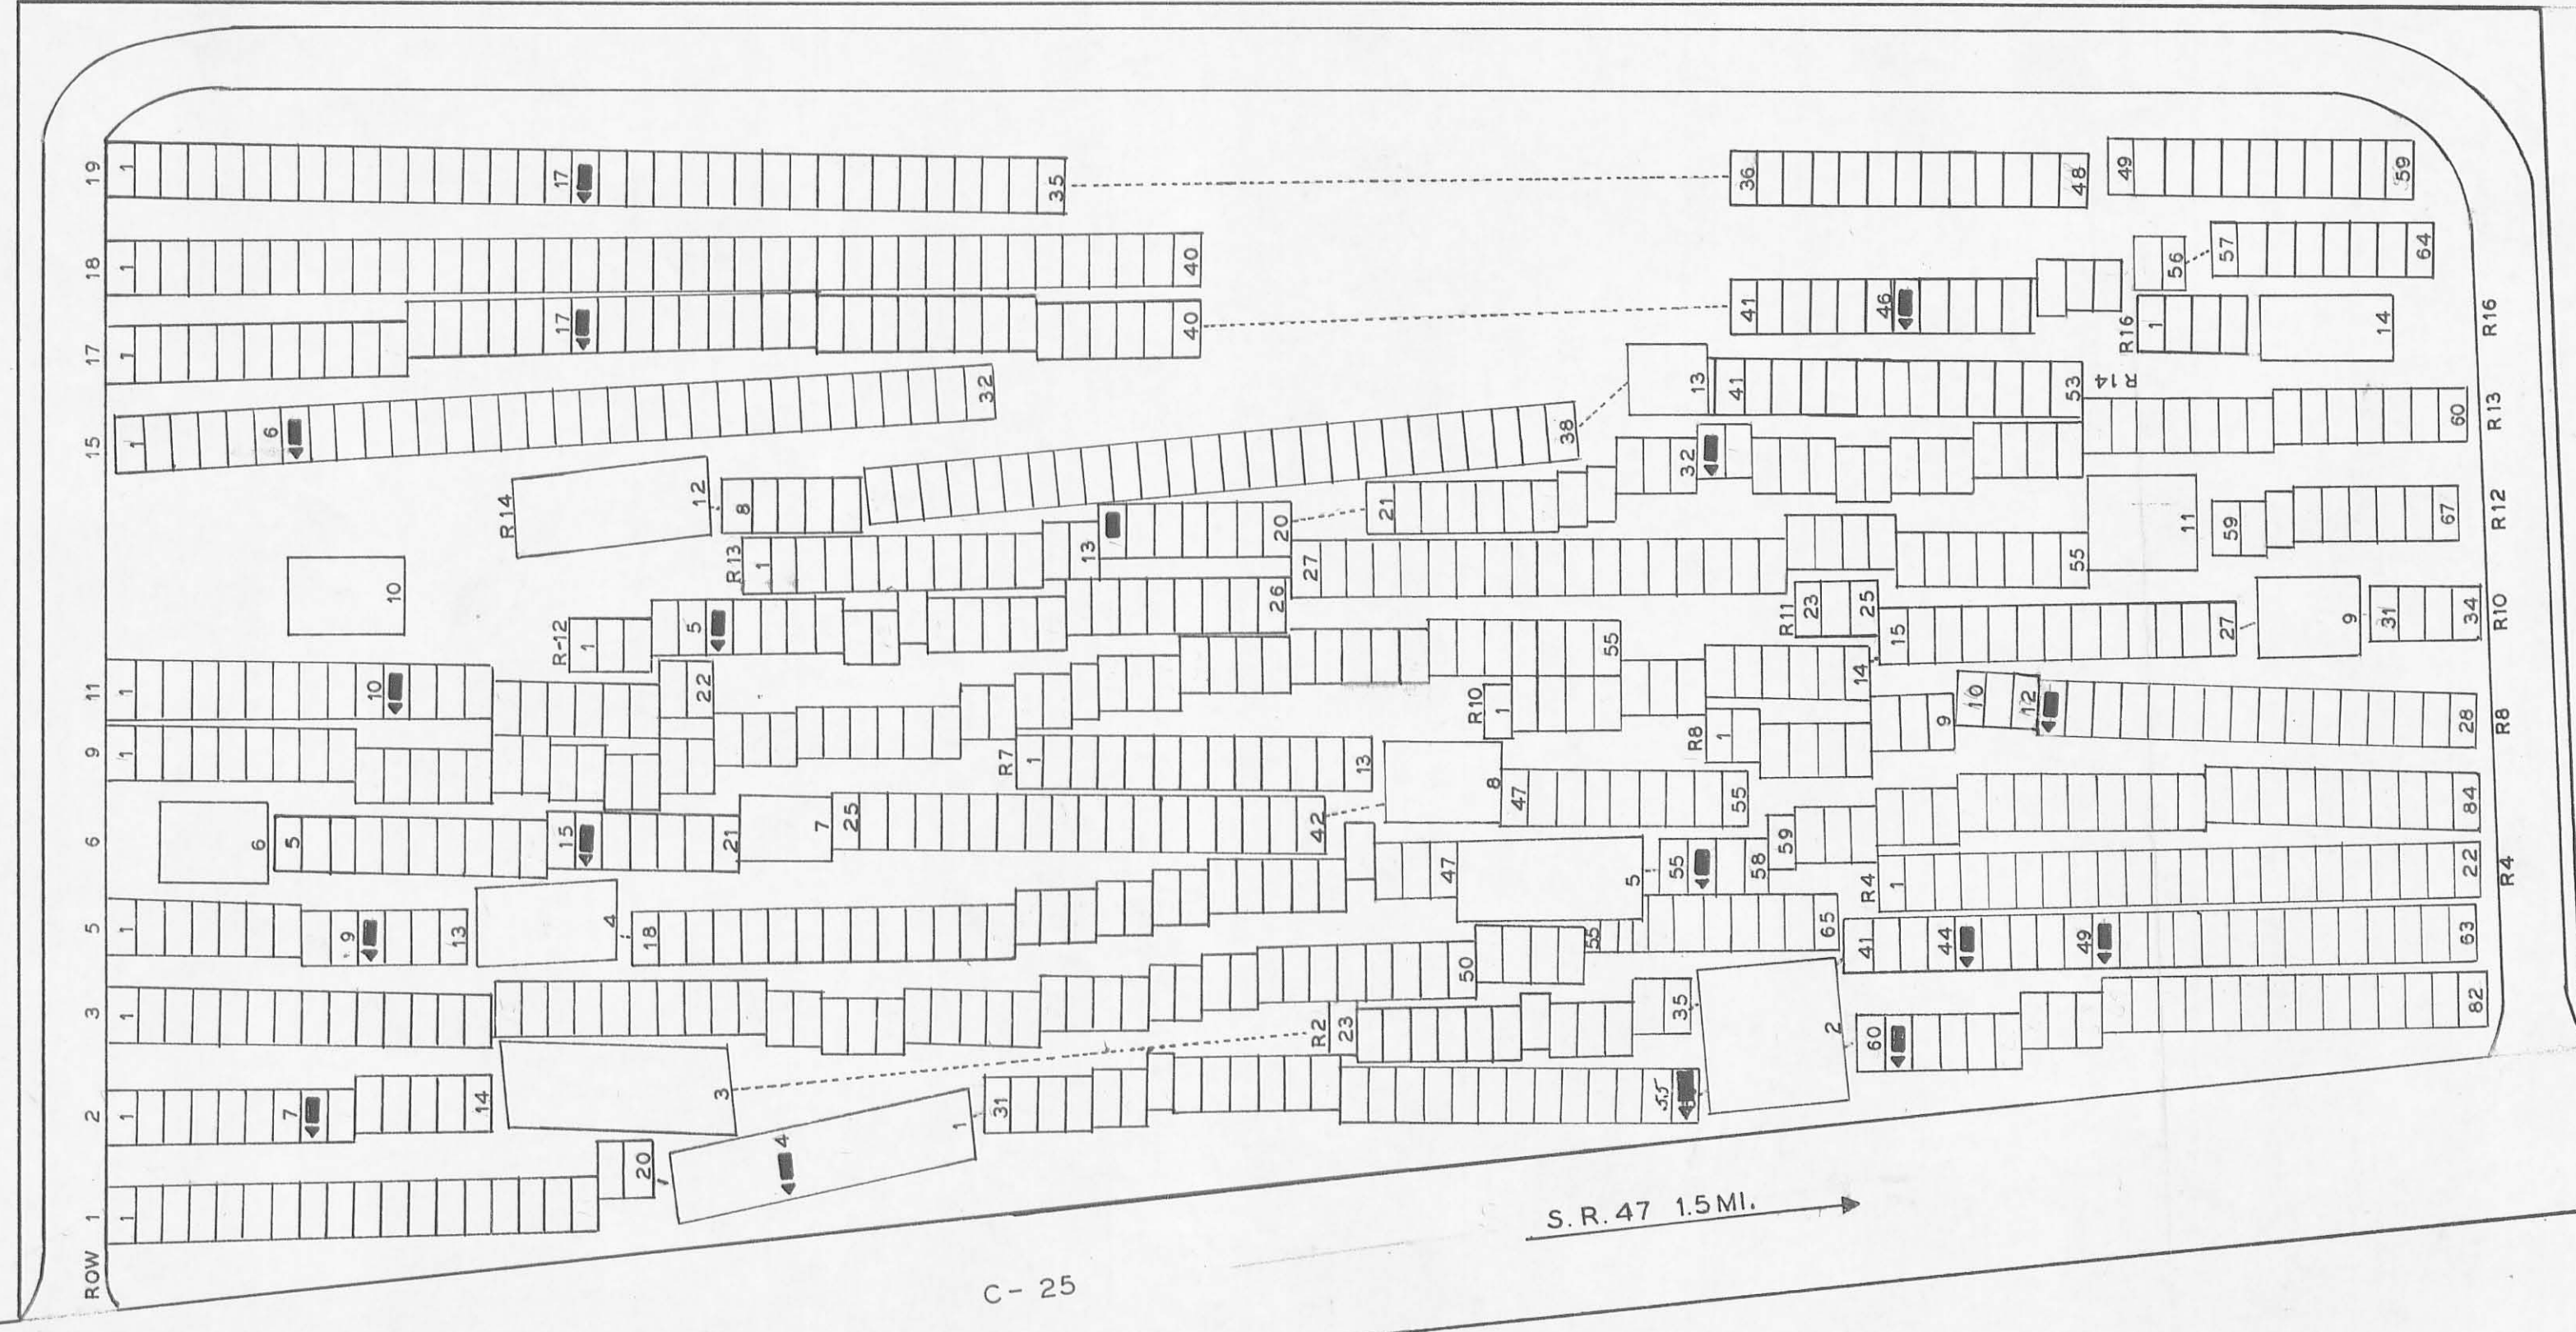

T - 57

LEGEND
 SEC=SECTION L=LOT R=ROW
 G=GRAVE W=WAR
 X=POSITION UNKNOWN

HARPER CEMETERY

LOGAN CO. RUSHCREEK TWP

OFFICIAL PROJECT NOS. 465-42-3-467 & 665-42-3-232

<p>LEGEND</p> <ul style="list-style-type: none"> ① REVOLUTIONARY WAR ⑩ WAR OF 1812 ⑬ WAR WITH MEXICO ⑰ CIVIL WAR ⑳ SPANISH-AM. WAR ⑳ WORLD WAR 	<p>HISTORY</p> <p>SCALE 1"=20'</p> <p style="text-align: right;">1.5 ACRE</p>
---	--------------------------------------------------------------------------------------



NAME	SEC	L	R	G	W
BENNET HENRY H			23	13	19
BICKHAM JOHN	245			16	19
BICKHAM ROBERT			27	19	14
CASSETT T N	238			2	19
COLLINS CHARLES C	106			1	31
CRAWFORD JOHN A	253			3	19
DOWELL JOHN H	98			4	19
DULANEY HARRISON	149			4	31
HAMOND	139			6	
HARROD DAVID B	126			4	19
HARROD JOHN	174			7	19
HARROD SAMUEL CAPT.		8		23	10
HERROD JOHN		8		25	10
IRWIN JAMES B		28		19	19
LEAF JAS H		1		1	19
MILLER JAMES S LIEUT.		9		27	19
MILLER ROBERT M	100			6	19
REID ROBERT			30	7	10
REID ROBERT A			30	4	19
REID JOSEPH G			30	5	19
REID WILLIAM J			30	5	19
ROGERS BENJAMIN			14	6	10
RUSSELL JOHN SR.			18	13	10
SIMPSON MATHEW			16	42	10
SIMPSON WILLIAM W			16	40	19
SMITH ELMER E	119			5	25
STEWART JAMES M		23		5	19
WISHART WILLIAM H	149		1		19

SCALE 1"=20'

HARROD CEMETERY

LOGAN CO. McARTHUR TWP.
OFFICIAL PROJECT NOS.-465-42-3-467&665-42-3-232

<p>LEGEND</p> <ul style="list-style-type: none"> ① REVOLUTIONARY WAR ⑩ WAR OF 1812 ⑯ WAR WITH MEXICO ⑰ CIVIL WAR ⑳ SPANISH AM. WAR ⑳ WORLD WAR 	<p>HISTORY</p> <p style="text-align: right;">2 ACRES</p>
---	-----------------------------------------------------------------

LEGEND
 SEC=SECTION L=LOT R=ROW
 G=GRAVE W=WAR
 X=POSITION UNKNOWN

HUNTSVILLE CEMETERY

LOGAN CO. McARTHUR TWP.

OFFICIAL PROJECT NOS. 465-42-3-467 & 665-42-3-232

5 ACRES

4 PAGES

LEGEND

- ① REVOLUTIONARY WAR
- ⑩ WAR OF 1812
- ⑯ WAR WITH MEXICO
- ⑲ CIVIL WAR
- ⑳ SPANISH-AMERICAN WAR
- ⑳ WORLD WAR



HISTORY

46-7-1

HUNTSVILLE .8 MI.

U.S.-33

SCALE 1"=20'

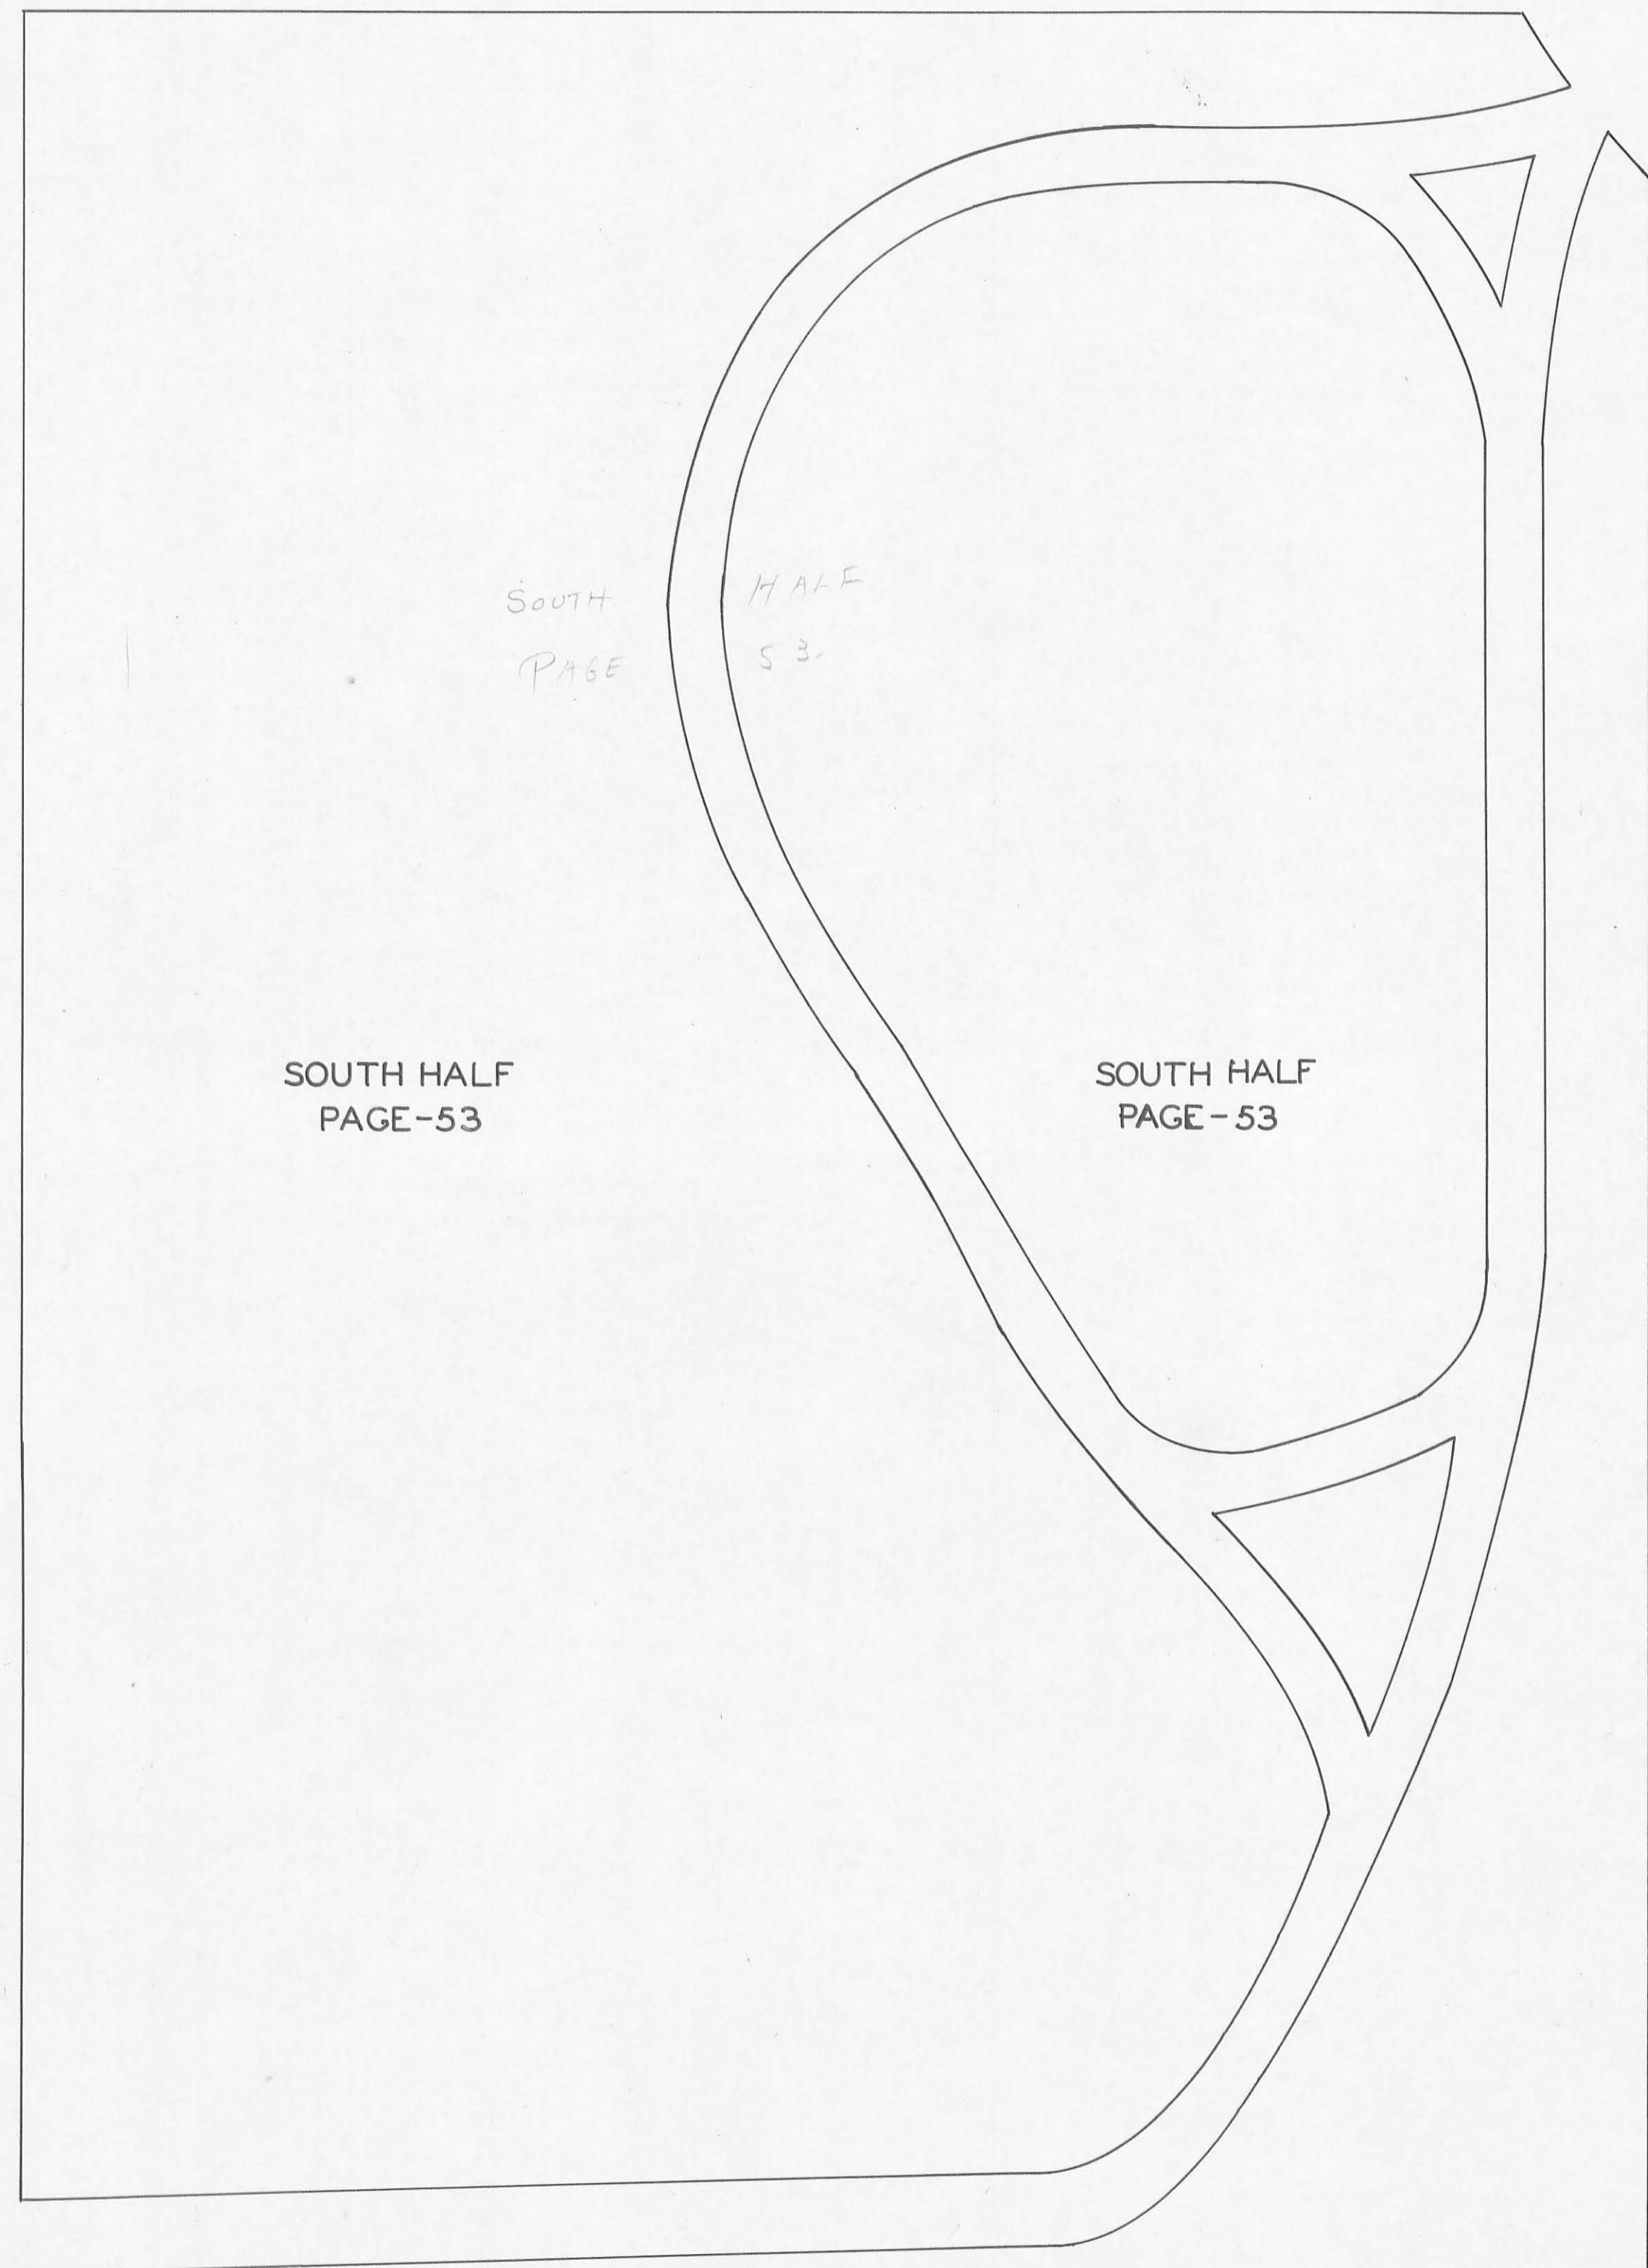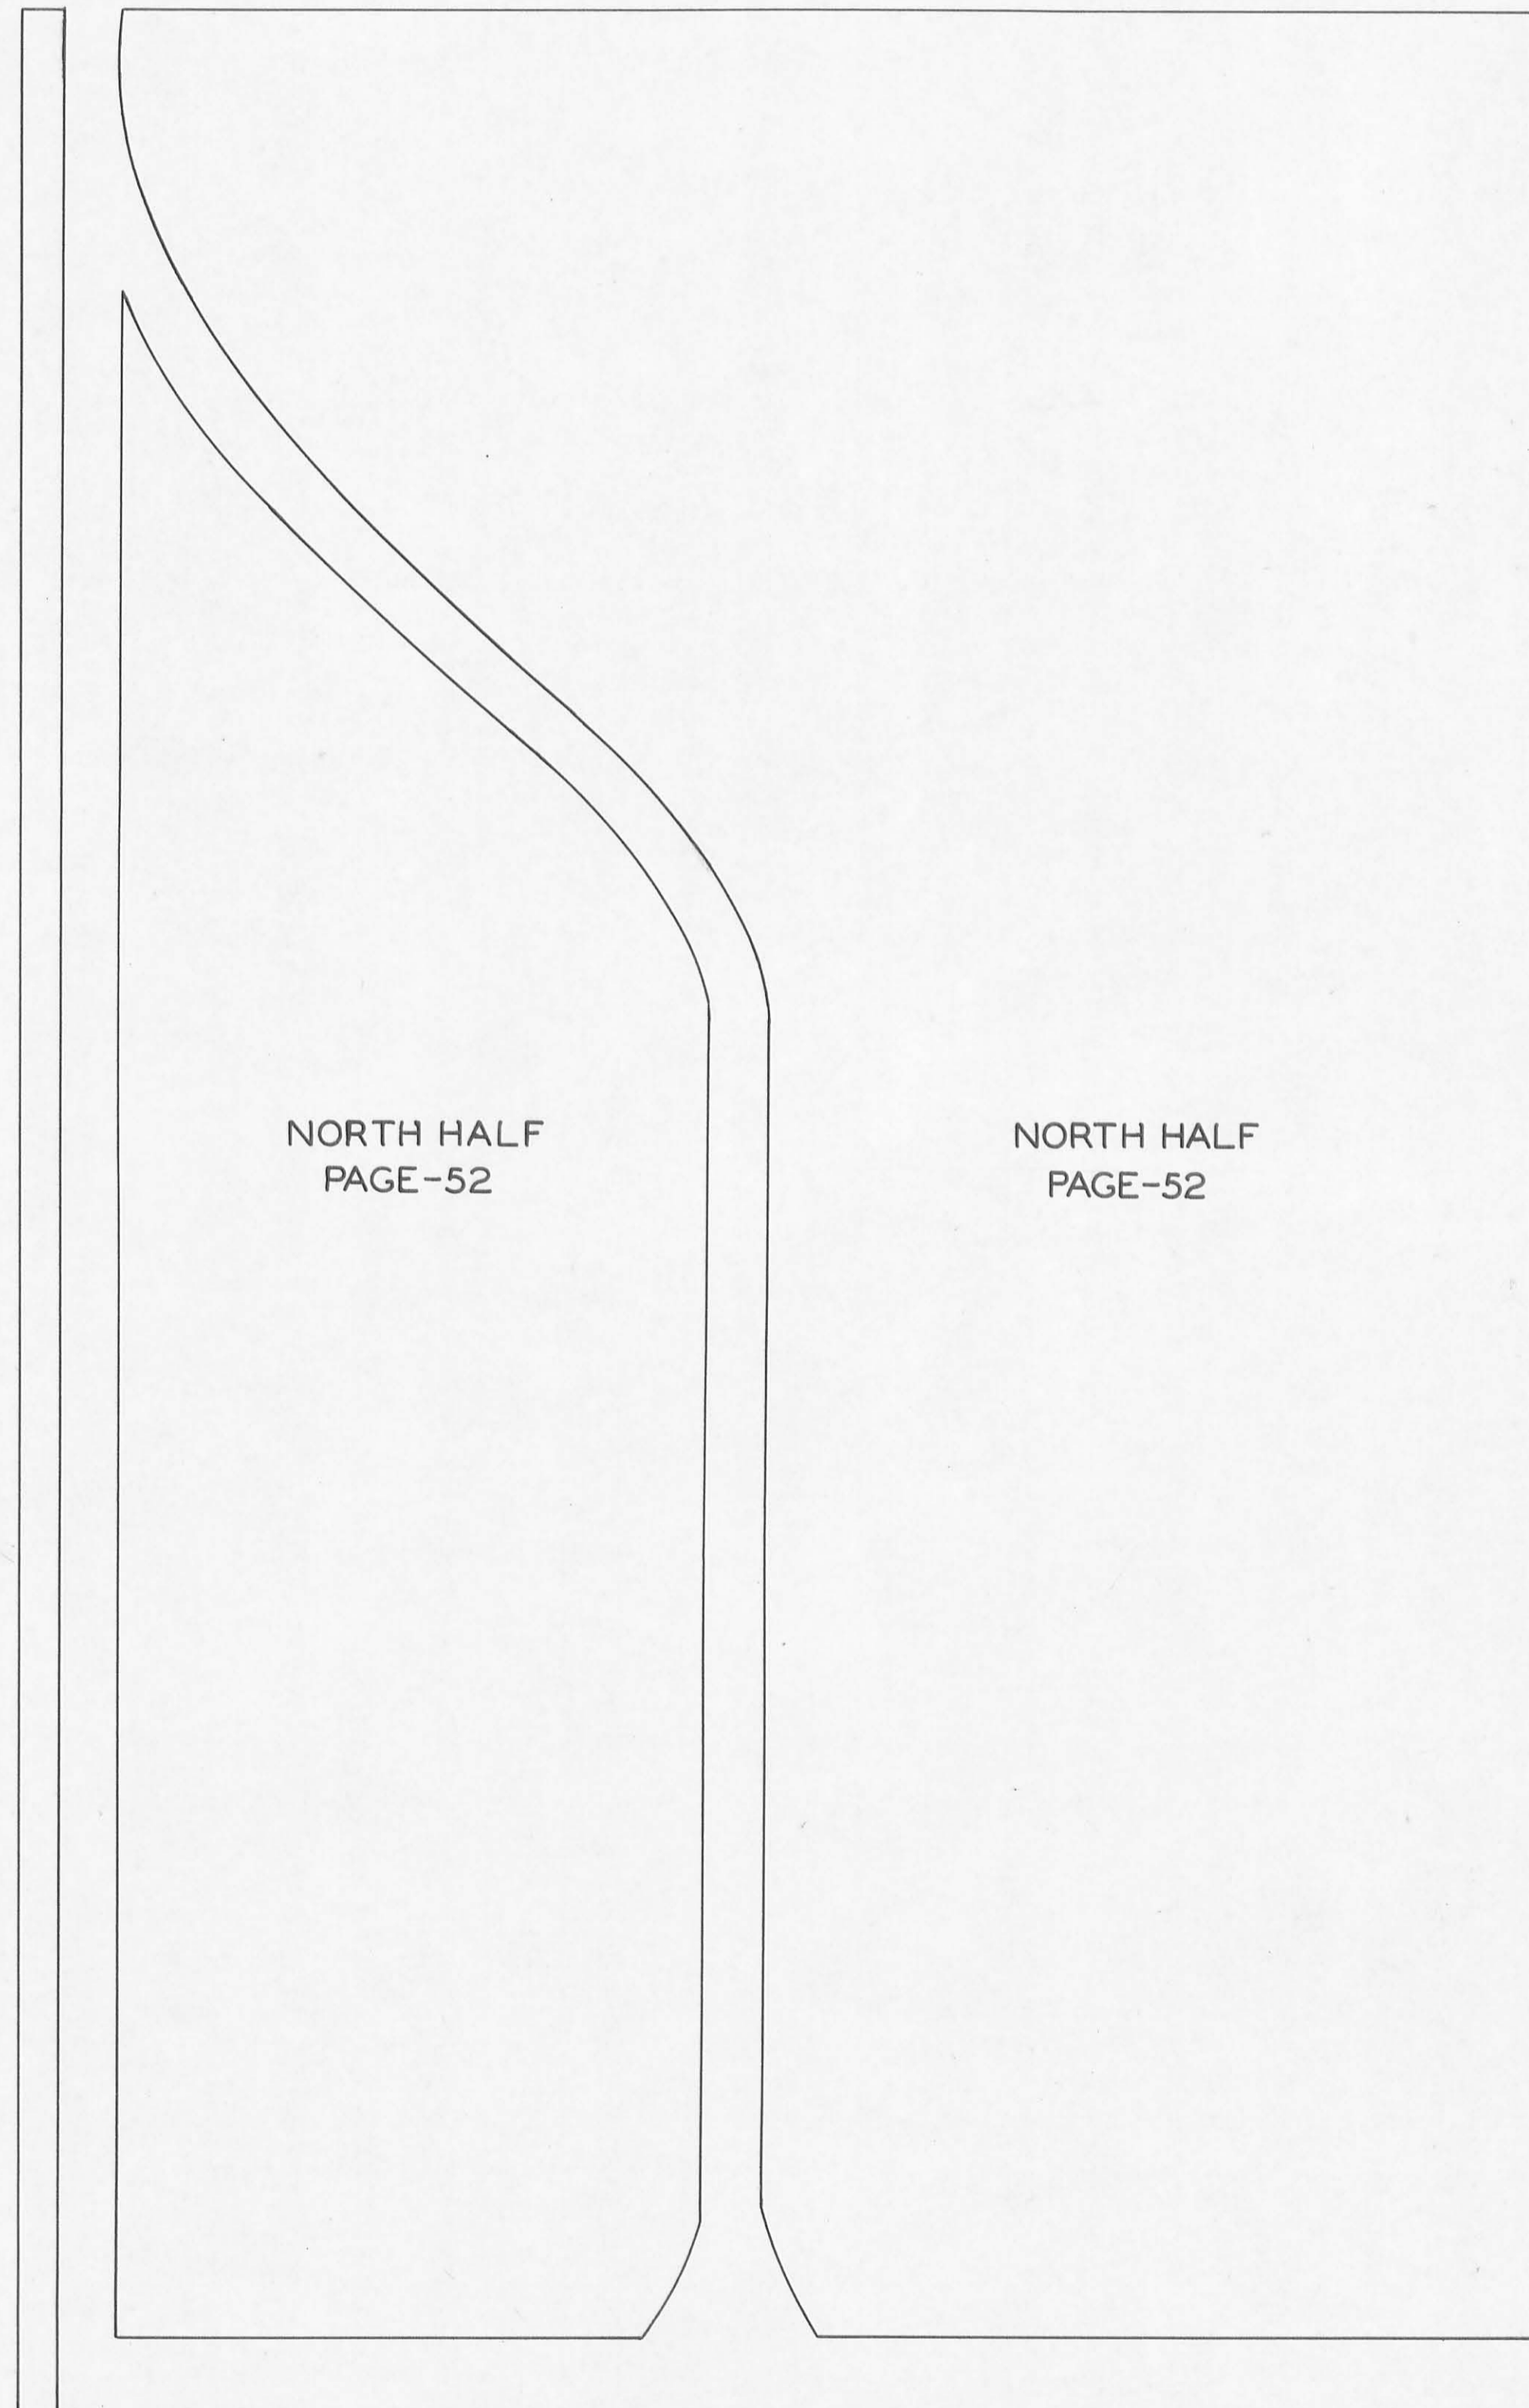


CO-37

SCALE 1"=20'

NAME	SEC	L	R	G	W
BEATTY WILLIAM W	5			6	19
DUCKER MART Y B	143			3	19
HOLBEN GEORGE	395			5	19
IDLE ELIJAH	198			2	19
ISRAEL JOHN H	75			1	25
JACOBS ARNOLD H	742			3	31
JAMES WILLIAM M	523			6	19
KING ALEXANDER	14			4	10
KNOTT'S MILTON T	113			2	19
LATSON JOSEPH	42			6	19
LEASE JOHN P	479			1	19
LYONS HARVEY C	580			2	25
MAY JOHN W	22			4	19
MORRIS THOMAS R	543			3	19
MURDOCK ARTHUR	16			4	19
POLLOCK JAMES S	31			6	19
RICKS JOSEPH B	488			4	31
RILEY WILLIAM	146			2	19
ROBB WM D	106			3	19
ROYER LESTER	116			7	31
SCOTT ABRAHAM B	83			5	19
SCOTT GAIL R	83			1	31
SHICK HENRY	689			4	31
WALLACE JOHN M	474			1	31
WILHITE CHURCH	34			5	19
YOESTING RAYMOND P	530			2	31


SUPPLEMENTARY LIST

DUNSON THOMAS	65			3	
EVANS WM.	50			5	19
FUNK JOSEPH	3			1	19
WAGNER LAFAYETTE	515			6	19
WHITAKER WILLIAM K.	128			2	19
Jones Murry E.	580			5	31

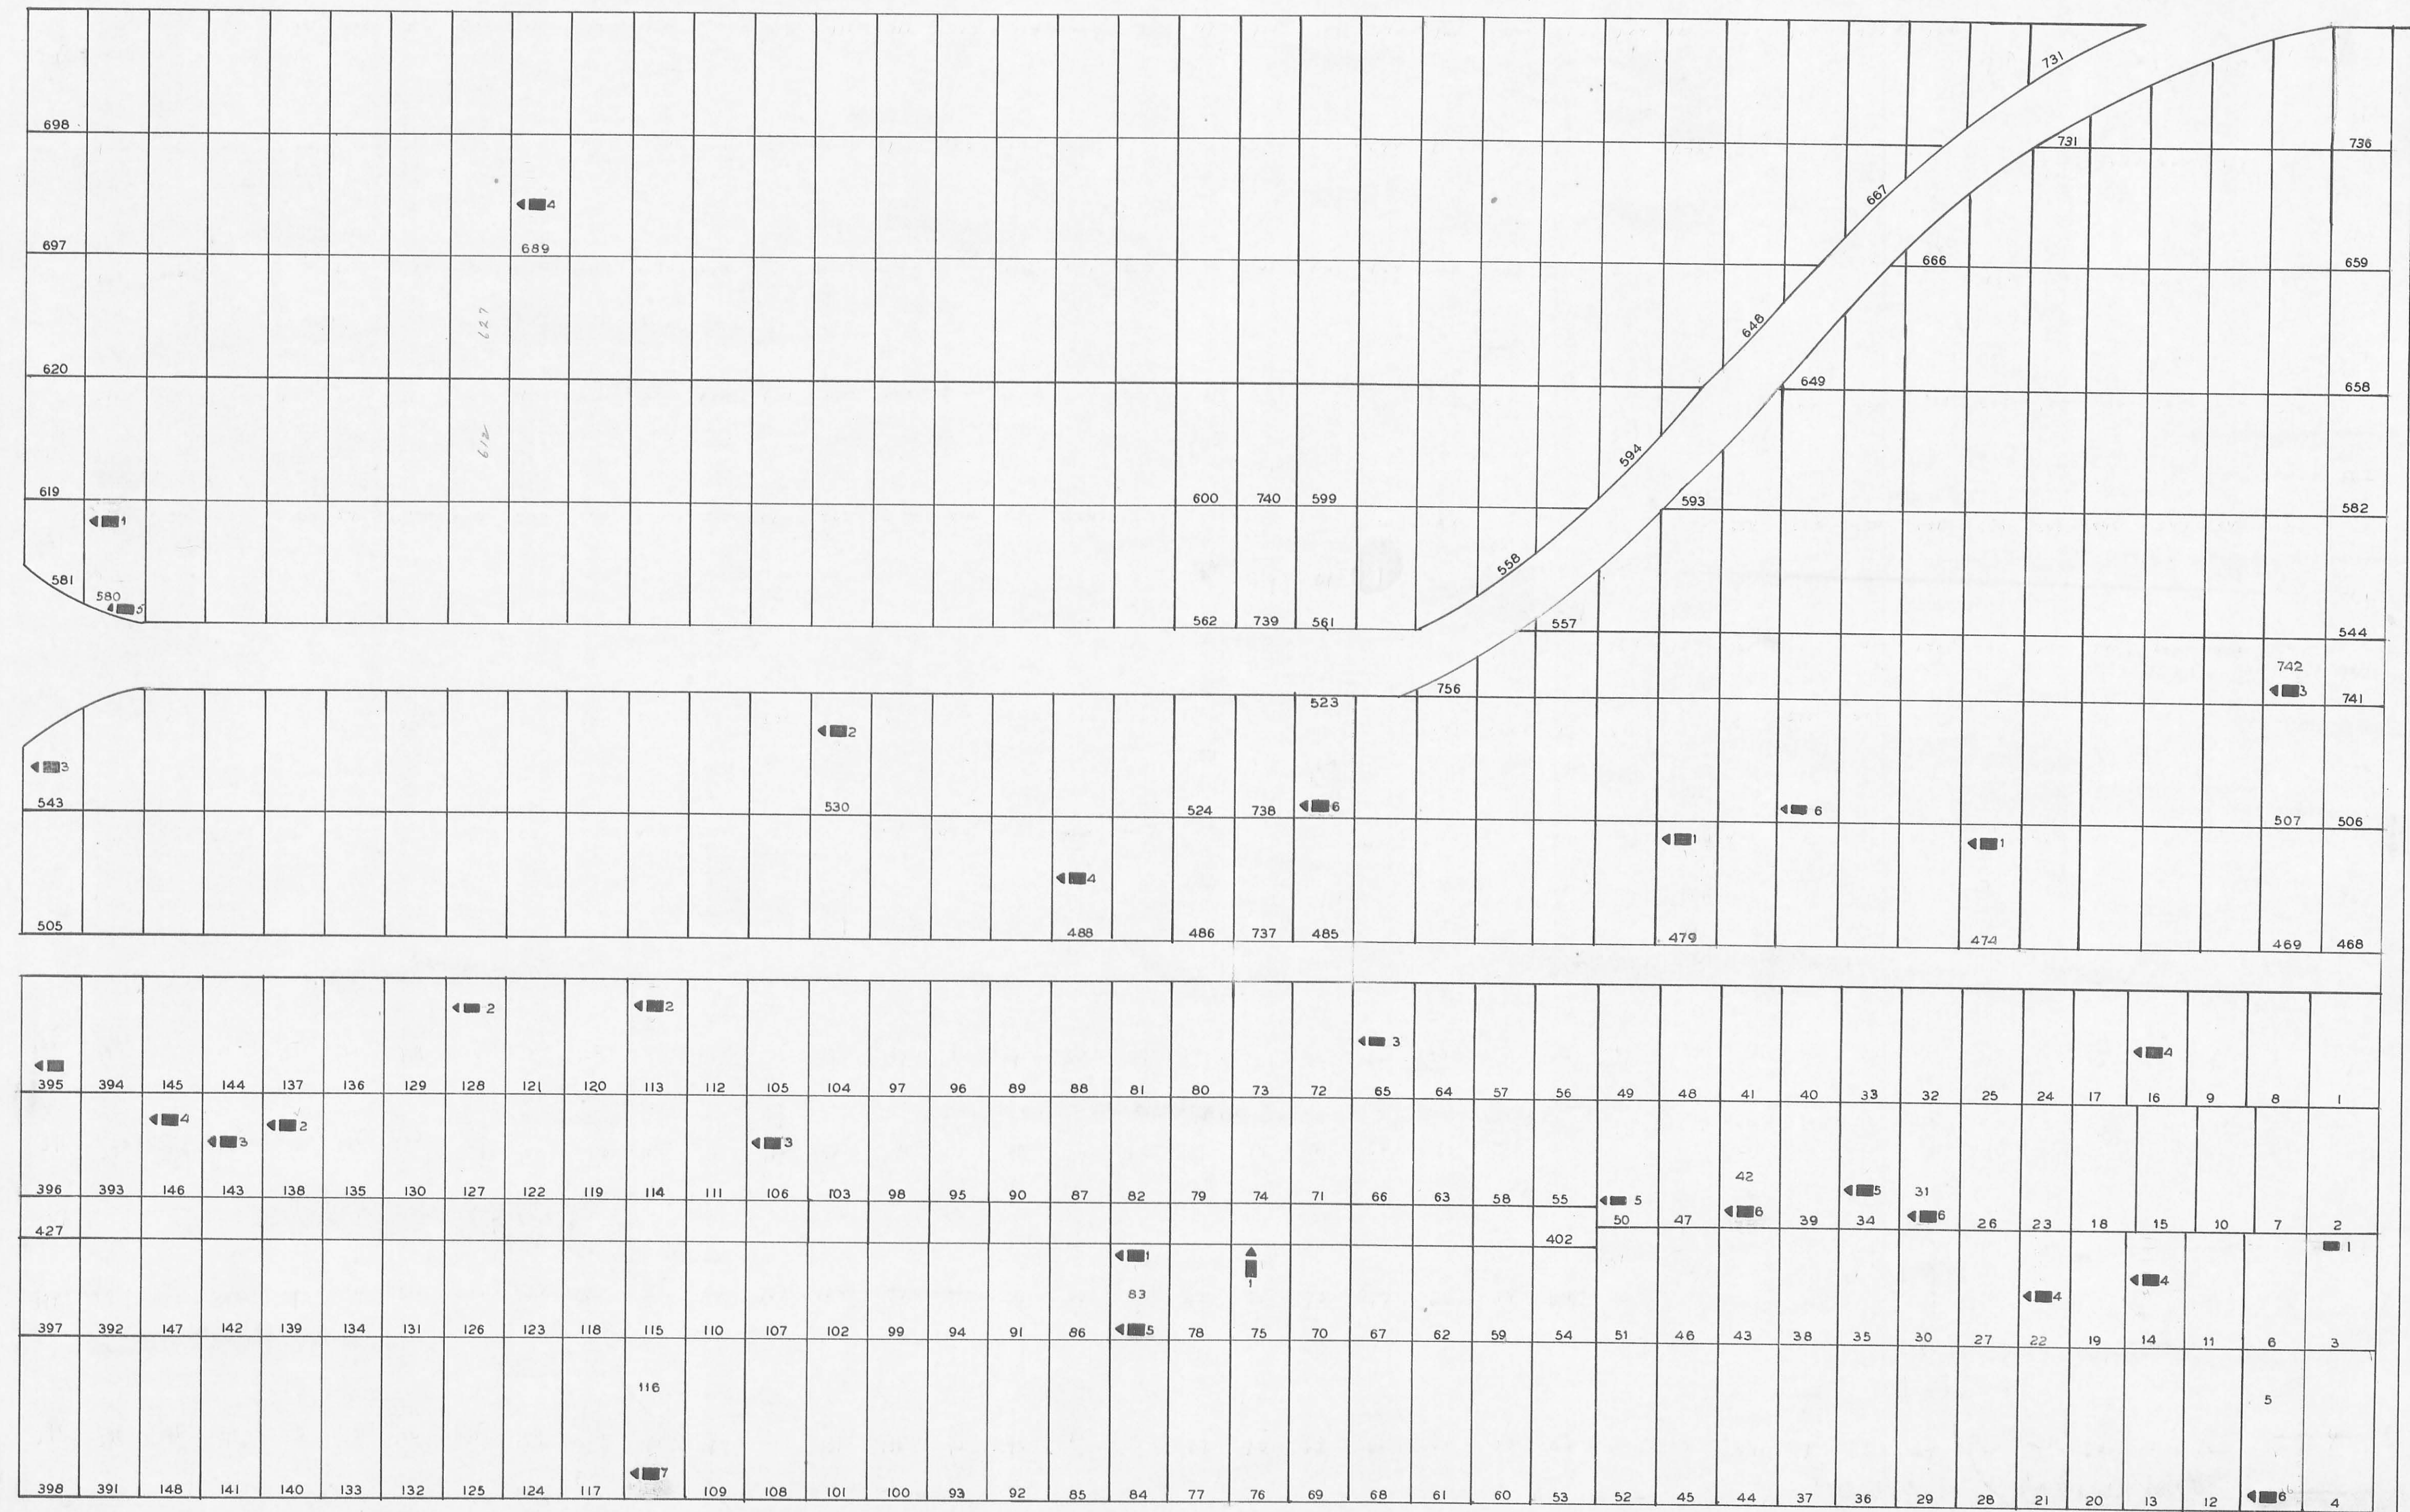


SCALE 1"=20'

LEGEND
 SEC=SECTION L=LOT R=ROW
 G=GRAVE W=WAR
 X=POSITION UNKNOWN

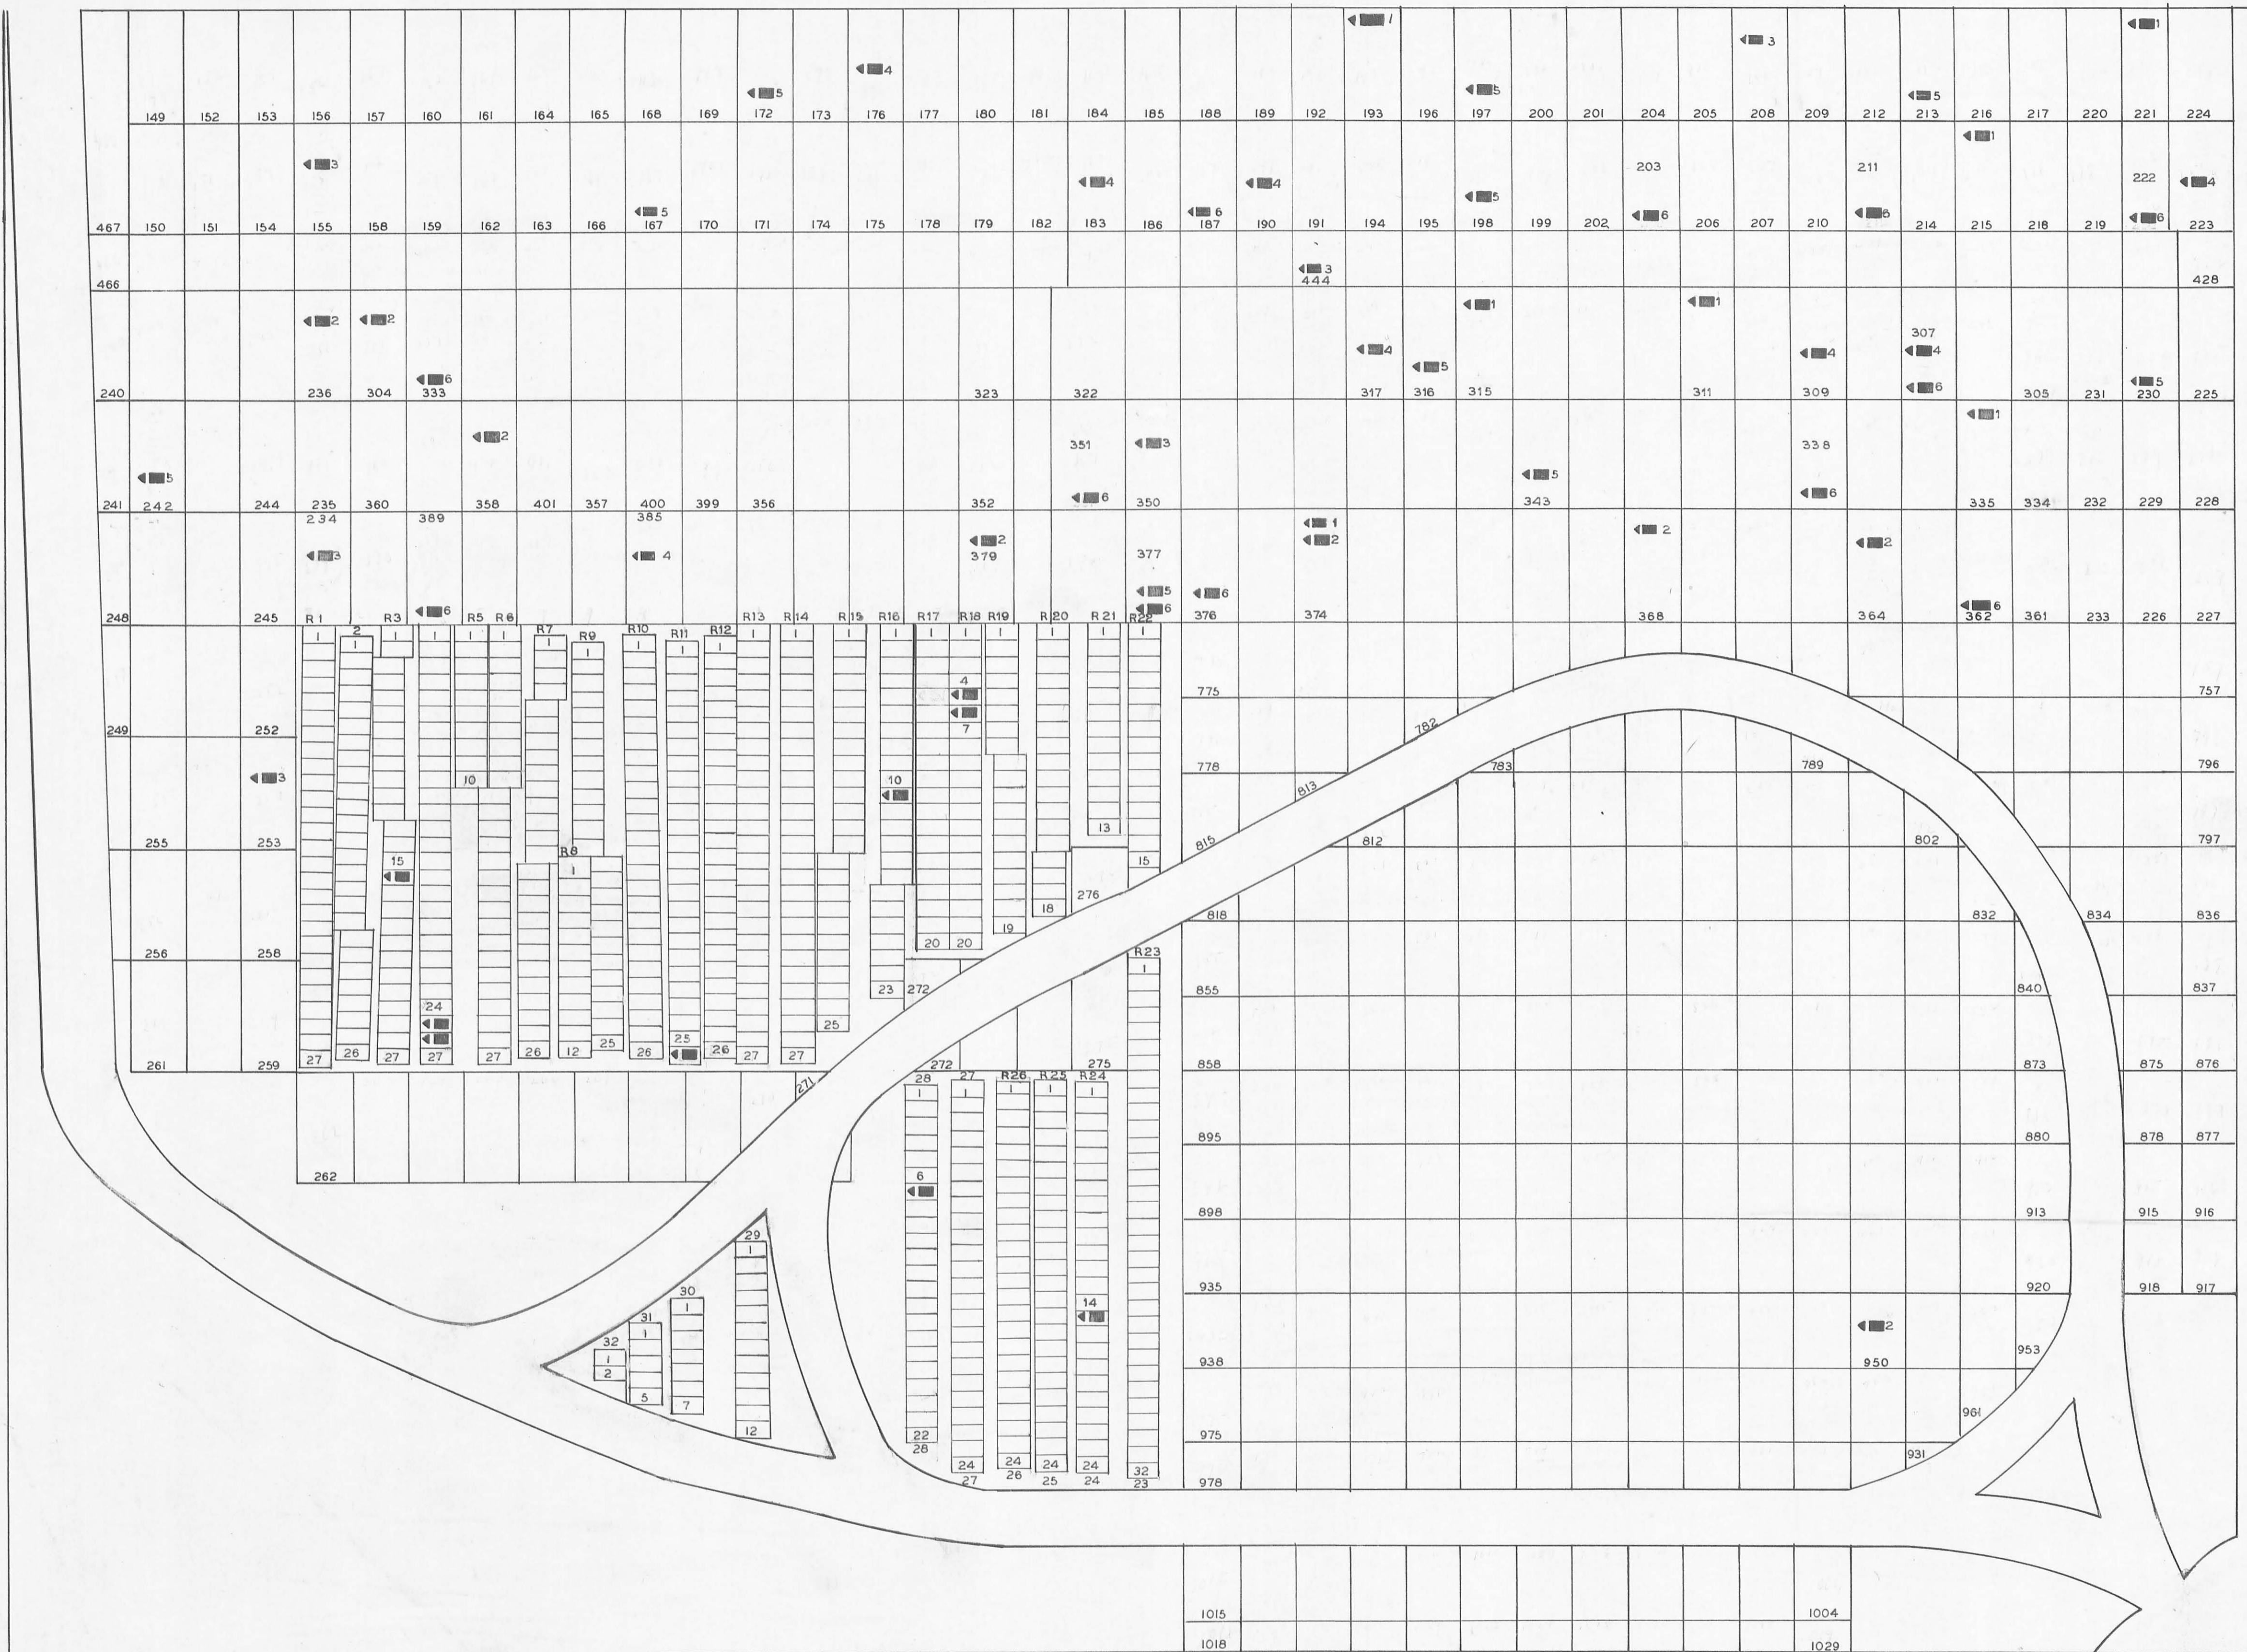


NAME	SEC	L	R	G	W
AXTELL JOHN W	307			6	19
AXTELL THOMAS	307			4	19
BERRY THOS E	358			2	19
BOLINGER DAVID	242			5	19
BROOK JACOB W.	223			4	10
CLARK JAMES A	221			1	19
CLINE GEORGE W	343			5	19
COLLINS JAMES	333			6	19
CLOW THOMAS H	315			1	19
COUSINS JAS.	338			6	19
DAVIS JOHN	155			3	19
DAY ELAM M	364			2	19
GARVER SAM'L	236			2	19
GLENN WM C	176			4	31
GRIFFIN JONATHAN C	203			6	19
HAND CLOISE F	950			2	31
HARROD J H	198			5	19
HUMPHREY CYRUS W	211			6	19
JEFFERS SOLOMON W	379			2	19
KNOX WM		16		11	19
LEASE JOHN B		18		5	19
LEASE SAMUEL S		18		6	19
LEATOR AUGUSTUS S	377			6	19
MARSHALL DANIEL D	308			4	19
MILLER ALEXANDER C	318			5	19
MILLER JAS		11		26	19
MOLLITOR PETER L	197			5	19
MORRIS JOHNSON	222			6	19
MORTON WM	311			1	19
MUSTAIN WARREN	376			5	19
M'CLEARY WILLIAM	304		28	7	19
M'FERSON A H				2	19
NICKELL THOMAS	317			4	19
REED JOSEPH			3	16	19
RUTTER LEVI J	389			6	19
SANDERS MORTIMER E	190			4	19
SANDER S WILLIAM J	183			4	19
STEWART DAVID		4		28	19
STEPHENSON MATTHEW	374			2	19
TARBUTTON GEORGE W	215			1	19
TUDOR JOHN	172			5	19
UNDERWOOD ELIAS	351			6	19
WIBRIGHT WM	234			3	19
WILLIAMS AMOS		24		15	10
WOOD GLEN	253			3	31
WORKMAN HENRY MC.	335			1	19
YOUNG THOMAS	350			3	19
YOUNG WM H	377			5	19

SUPPLEMENTARY LIST					
NAME	SEC	L	R	G	W
BRUBAKER JOSEPH T	167			5	19
COLLINS WILLIAM C	230			5	19
COULTER JAMES A	385			4	19
HAMMOND DANIEL W	187			6	19
HERRON WM T	213			5	19
IRWIN JOHN	368			2	19
STEPHENSON GEORGE	374			1	19
WALLACE DAVID G	208			3	19
WARD JOHN HENAN	444			3	19
FAY	362			6	19
STEWART WILLIAM R.		4		26	19
Decker John R.	193			1	19


 SCALE 1" = 20'

LEGEND
 SEC=SECTION L=LOT R=ROW
 G=GRAVE W=WAR
 * = POSITION UNKNOWN

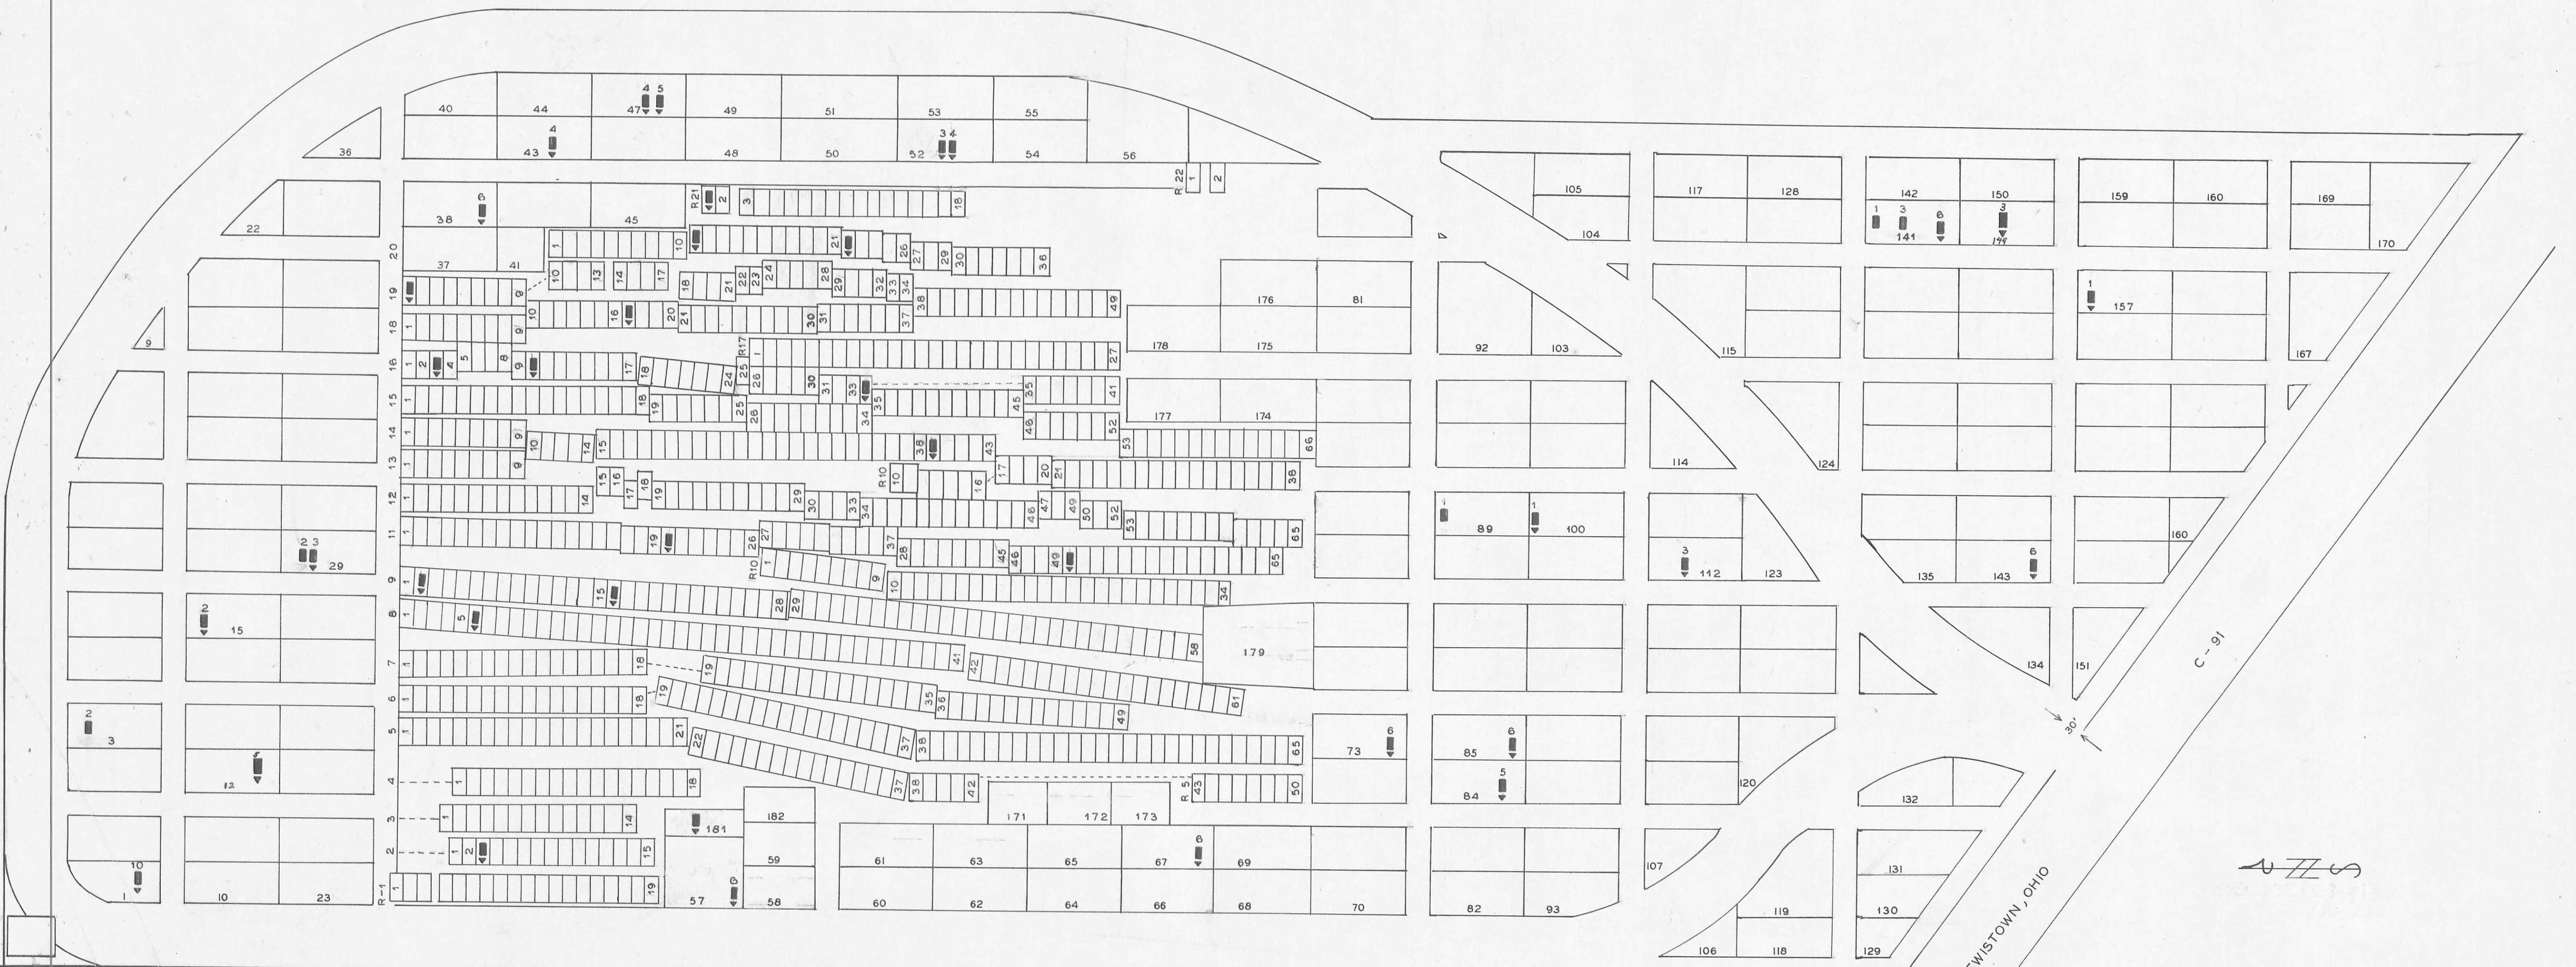

NAME	SEC	L	R	G	W	NAME	SEC	L	R	G	W
ARTHUR JOHN N.	47		4		19	VANNESS GEORGE M.	16		10		19
ARTHUR ORLADO	47		5		31	VANNESS HENRY	19		1		19
BERRY GEO. W.	43		4		19	VORUS ABRAHAM	16		3		19
BLACK WILLIAM	52		4		19	WOOD SAMUEL P.	9		2		19
BLACK WILLIE W.	52		3		25	UNKNOWN SOLDIER			3		2
BOGART JACOB M.	38		6		19	UNKNOWN SOLDIER			29		2
BRIDGEMAN FRANCIS		11	50		19	UNKNOWN SOLDIER			141		3
CASTLE J. W.	1		20		19	UNKNOWN SOLDIER			141		3
CERRY JAMES A.			1		19	HOVER SAMUEL	12		5		5
COWHICK ALEXANDER	100				1	LOWE MOSES H.	149			3	3
DOWNES THOMAS	112		3		19						
GLASSFORD WM. M.		16	34		3						
GRAHAM GEORGE	181				3						
HOPKINS ALMON		9	16		19						
HURTT PERRY FOSTER	57		8		31						
KROUSE JACOB	157		1		19						
MC KEE JAMES E.	143		6		19						
MC KINNON ALFRED M.		18	17		19						
MC KINNON JOHN T.		21	1		19						
MC MILLEN GEORGE W.		85	6		19						
MONROE A. J.		20	22		19						
PATRICK MILTON	84		5		19						
PATRICK SAMUEL J.		73	6		19						
RENICK ROBERT H.		11	20		19						
RIDDLE C. H.	29		3		19						
ROWAND ALFRED		8	6		19						
RUPERT GEORGE	67		6		19						
SANDERS JIM	15		2		2						
SHADE PHILIP		2	3		3						
SICKLEBAUGH VALENTINE		14	39		19						
SMITH S. MEEK	141		6		19						

LEWISTOWN CEMETERY

LOGAN CO. WASHINGTON TWP.


OFFICIAL PROJECT NOS. 465-42-3-467&665-42-3-232

<p>LEGEND</p> <ul style="list-style-type: none"> ① REVOLUTIONARY WAR ⑩ WAR OF 1812 ⑯ WAR WITH MEXICO ⑰ CIVIL WAR ⑳ SPANISH AM. WAR ⑳ WORLD WAR 	<p>HISTORY</p> <p style="text-align: right;">3.0 ACRES</p>
---	-------------------------------------------------------------------

SCALE 1"=20'

S. R. 69



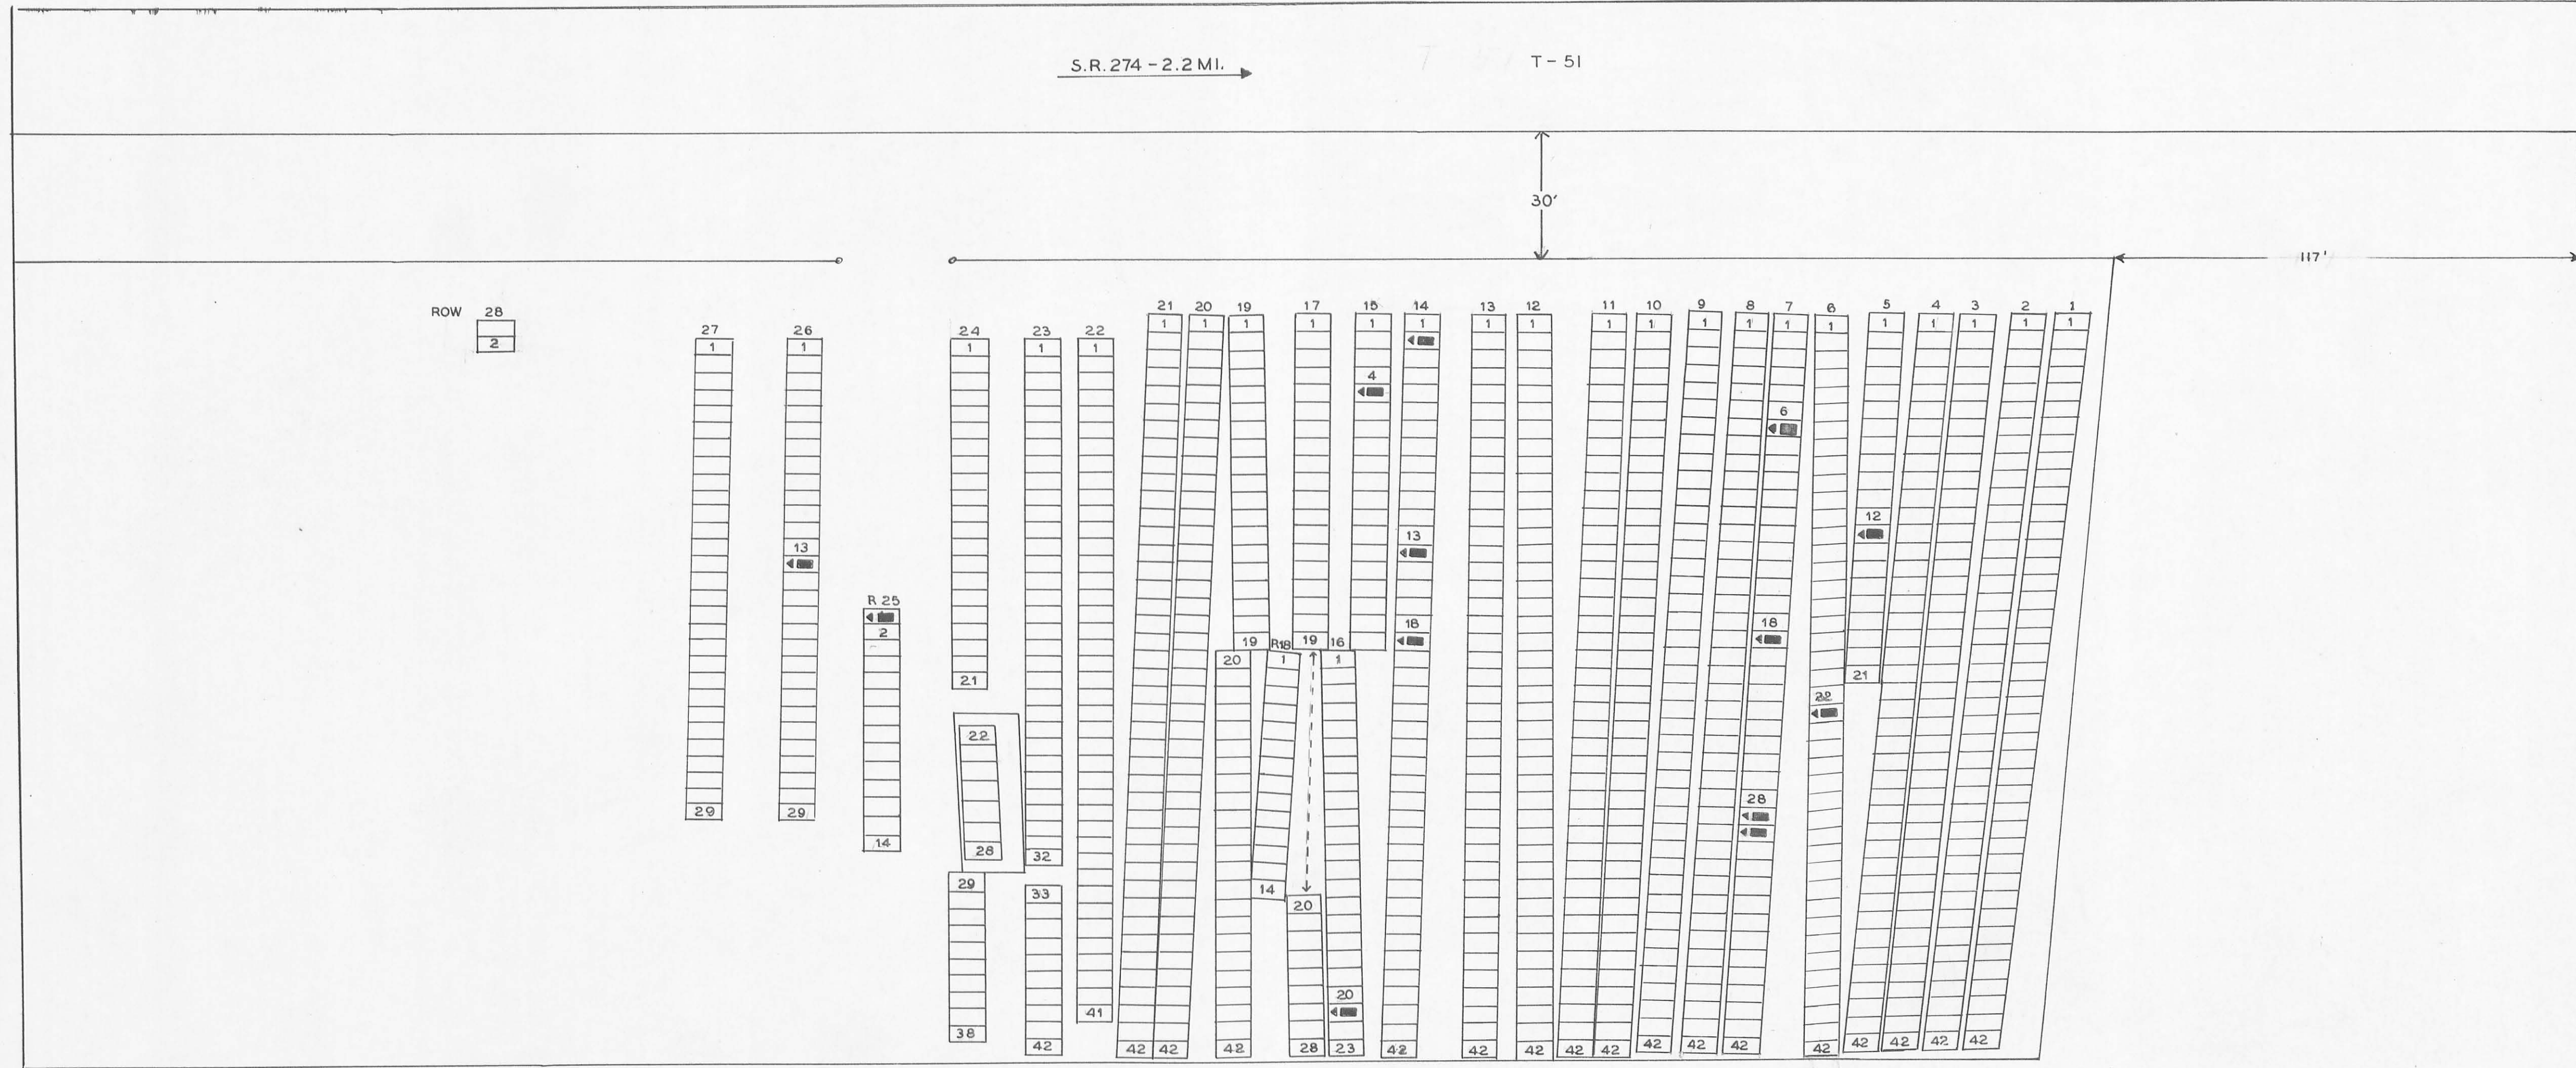

LEGEND
 SEC=SECTION L=LOT R=ROW
 G=GR AVE W=WAR
 X=POSITION UNKNOWN

NAME	SEC	L	R	G	W
CHURCH GEORGE	15		5	19	
CRAIG GEO	16		21	19	
DEERWESTER JOHN	26		14	19	
GARDNER FREEMAN	14			2	
JENKINS JNO	14		19	19	
JINKINS WILLIAM	14		14	19	
LEASE CHARLES W	7		29	31	
LEASE ROBERT P	7		30	31	
MASON SAMUEL	6		23	10	
ROBERTS JAMES A	7		19		
ROGERS PHILOMON	5		13	10	
SNOODY JOHN	7			7	
SUPPLEMENTARY LIST					
ROBERTS GEORGE	25		13		

MIAMI CEMETERY

LOGAN CO. RUSHCREEK TWP.

OFFICIAL PROJECT NOS. 465-42-3-467& 665-423-232

<p>LEGEND</p> <ul style="list-style-type: none"> ① REVOLUTIONARY WAR ⑩ WAR OF 1812 ⑩ WAR WITH MEXICO ⑩ CIVIL WAR ②⑤ SPANISH-AM. WAR ③① WORLD WAR 	<p>HISTORY</p>
---	-----------------------

SCALE 1"=20' 2 - ACRE