

# MIDDLEBURG CEMETERY

LOGAN CO. ZANE TWP.

OFFICIAL PROJECT NOS. 665-42-3-467 & 665-42-3-232

ACRES 6.6

PAGES 4


LEGEND

HISTORY

- ① REVOLUTIONARY WAR
- ⑩ WAR OF 1812
- ⑯ WAR WITH MEXICO
- ⑲ CIVIL WAR
- ⑳ SPANISH-AMERICAN WAR
- ⑳ WORLD WAR

46-17-1

1" = 30'

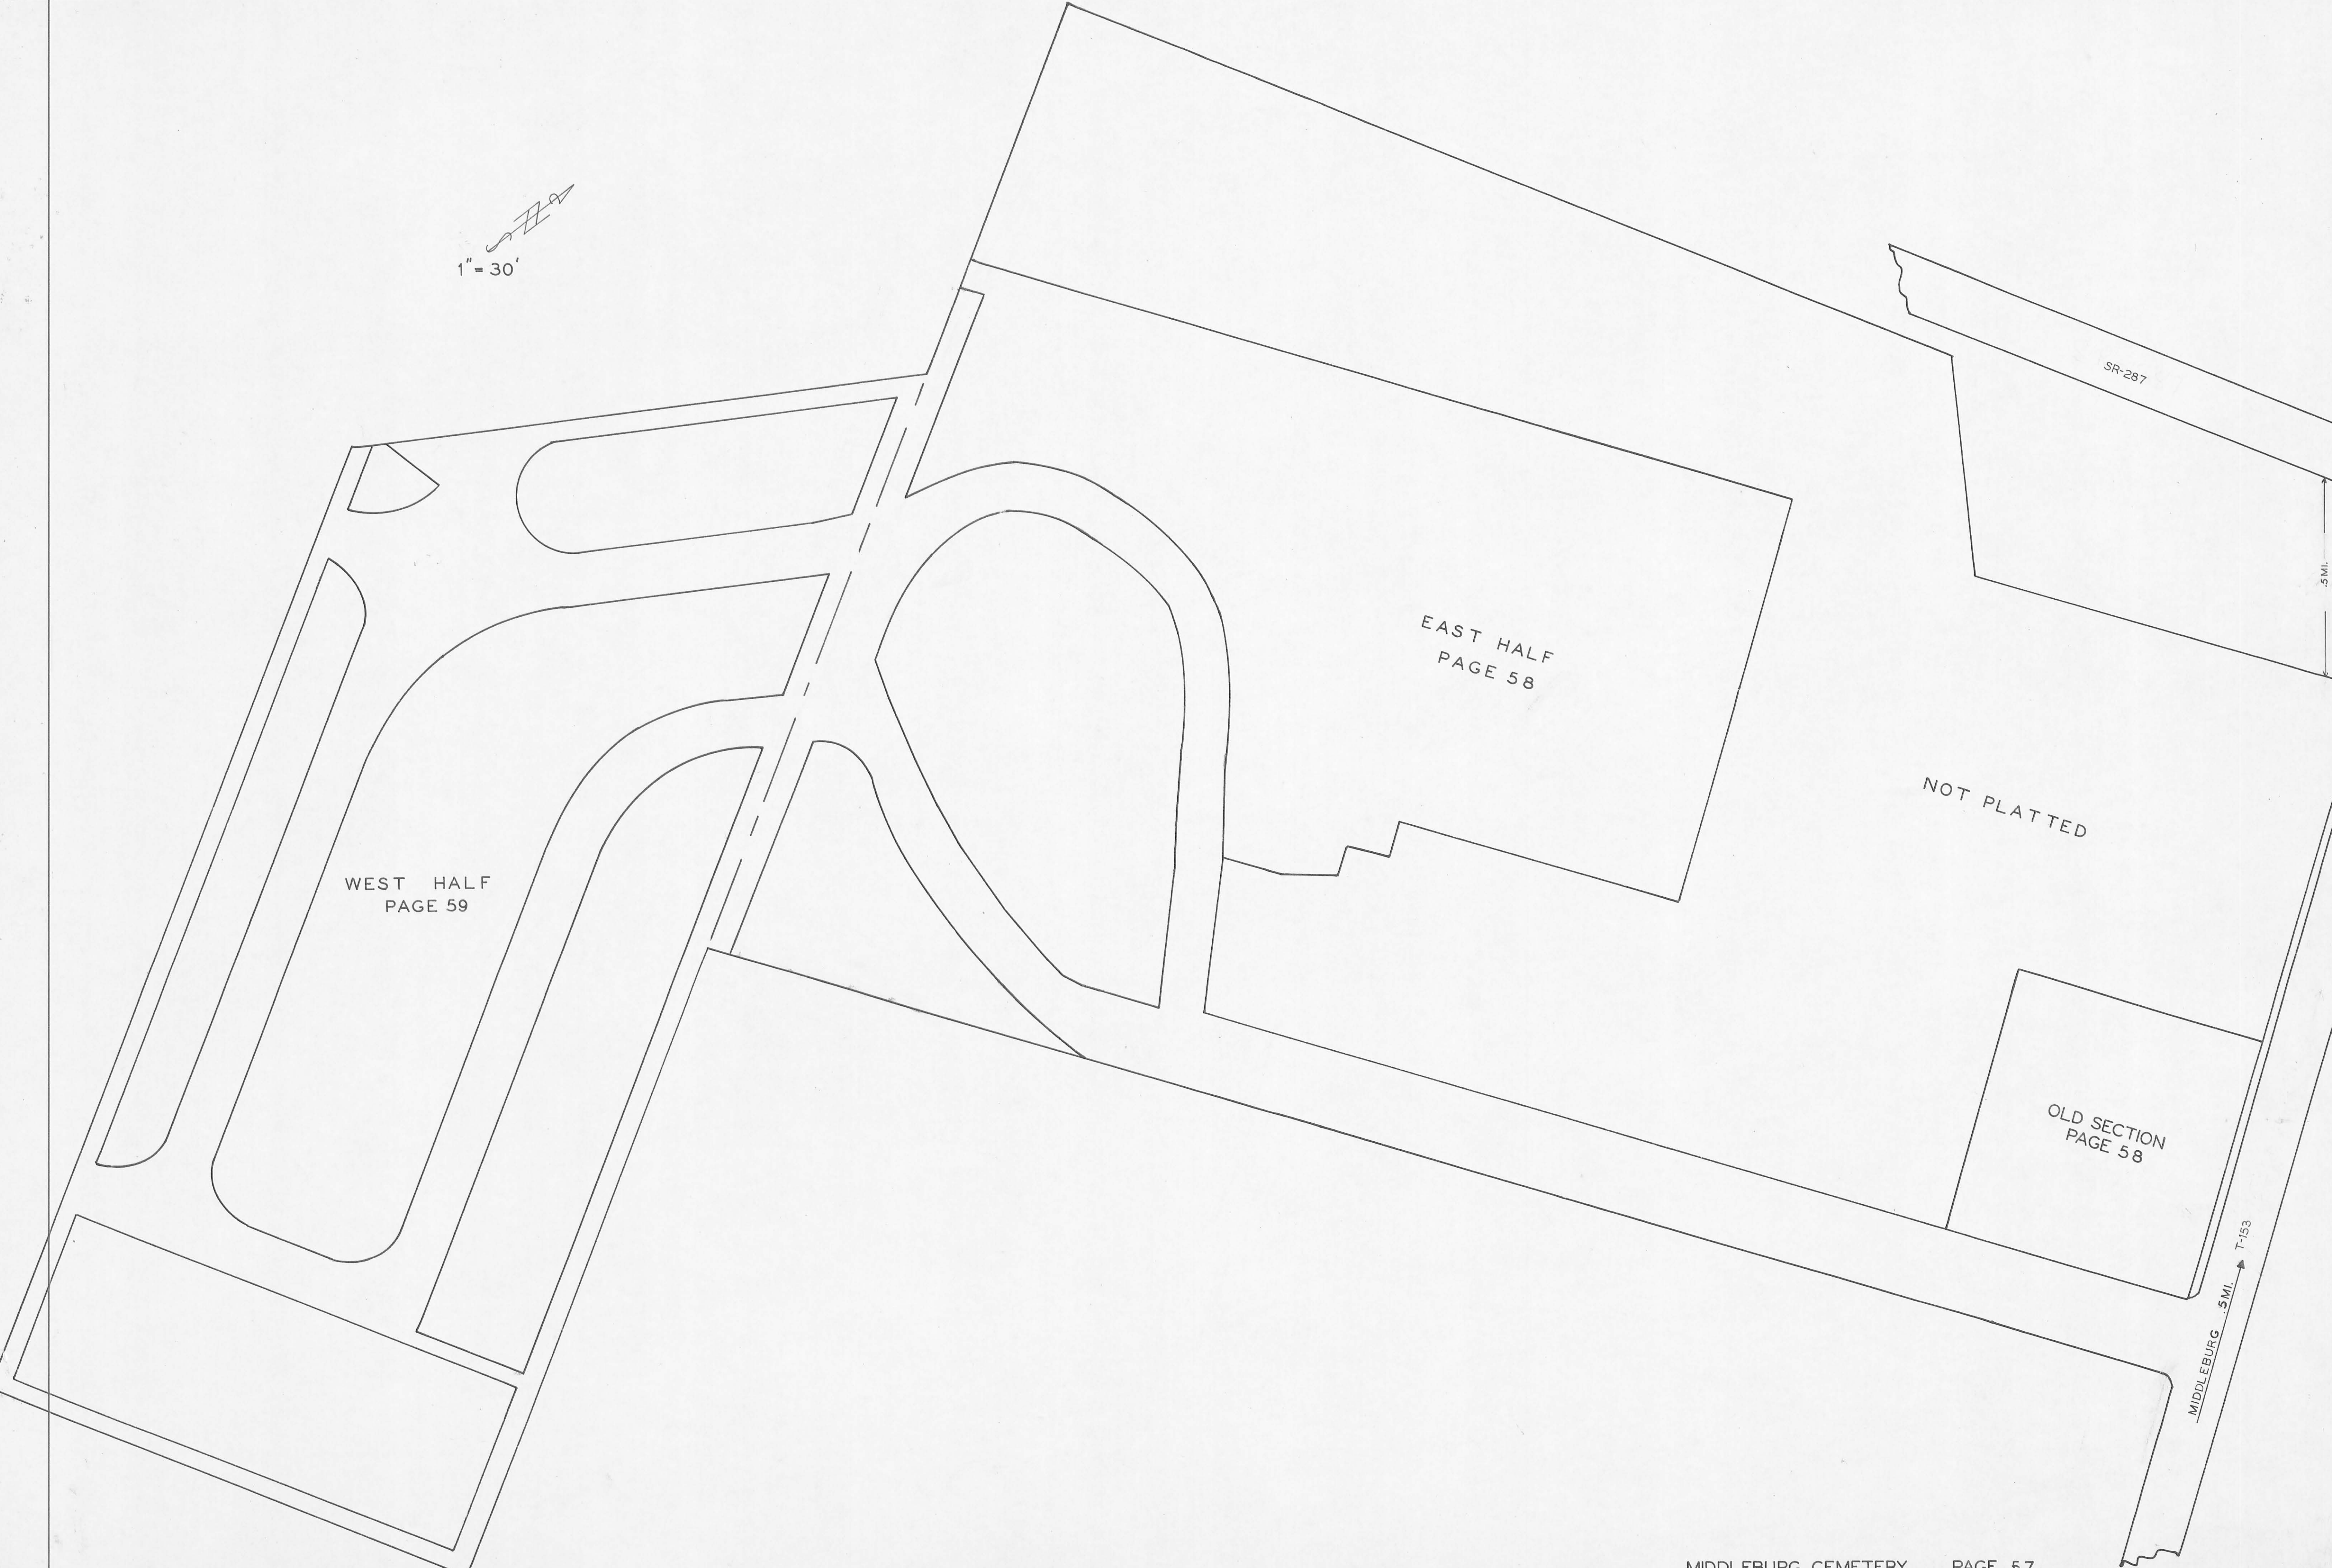

WEST HALF  
PAGE 59

EAST HALF  
PAGE 58

NOT PLATTED

OLD SECTION  
PAGE 58

MIDDLEBURG .5 MI. T-153


SR-287

.5 MI.



LEGEND  
 SEC-SECTION L-LOT R-ROW  
 G-GRAVE W-WAR  
 \*-POSITION UNKNOWN

SCALE 1" = 20'


NAME	SEC	L	R	G	W	NAME	SEC	L	R	G	W	
BALLINGER HENRY M	15			4	19	WARE J W				6	17	19
BELL HENRY C	12			4	19	WEST ALONZO P	103				3	19
BIRKETT JOHN C	55			2	19	WIRICK GEORGE W	156				3	19
BLACKWELL C G	132			5	19							
CARPENTER E	45			5	19							
COX NATHAN C	75			2	19							
CURL HARRISON	31			4	19							
DOBBS W M			2	20	19							
EVANS MOSES	83			3	19							
GRUBBS BENJ			1	2	19							
GRUBBS B S			2	10	19							
GRUBBS JAMES M	97			2	19							
GRUBBS THOMAS S			4	18	19							
GRUBS WM			3	11	10							
HAINES JOEL	39			4	19							
HENRY ALEXANDER	77			2	19							
HOFFRIGHTER HENRY	40			5	19							
INSKEEP JOHN	111			3	19							
INSKEEP HOWARD	58			4	31							
INSKEEP MARION	58			2	19							
LANE WILLIAM	33			5	19							
LOSEY ANDREW	24			4	19							
MC DONALD JAMES	30			6	19							
MC WADE THOMAS	88			4	19							
MARQUIS RICHARD	23			5	19							
MILLEDGE JOHN	26			5	19							
NORVIEL ELI	201			4	19							
POOL ISRAEL	38			6	19							
POOL JOS. H	64			1	19							
RALEY JAMES	66			2	19							
REA GUY A	117			1	25							
REA JAMES H	117			2	19							
RICHARDSON J H	42			5	19							
SANDERS MALON			8	7	19							
SHARP J B			9	3	19							
SHARP MERLE L	130			4	31							
SMITH DAVID	163			3	19							
STARRICK WILLIAM H	128			4	19							
STRATTON DAVID	55			5	19							
TALLMAN LEVI P	150			3	19							
TEETS JAMES	74			4	19							
WINTRODE JACOB J.	17			5	19							

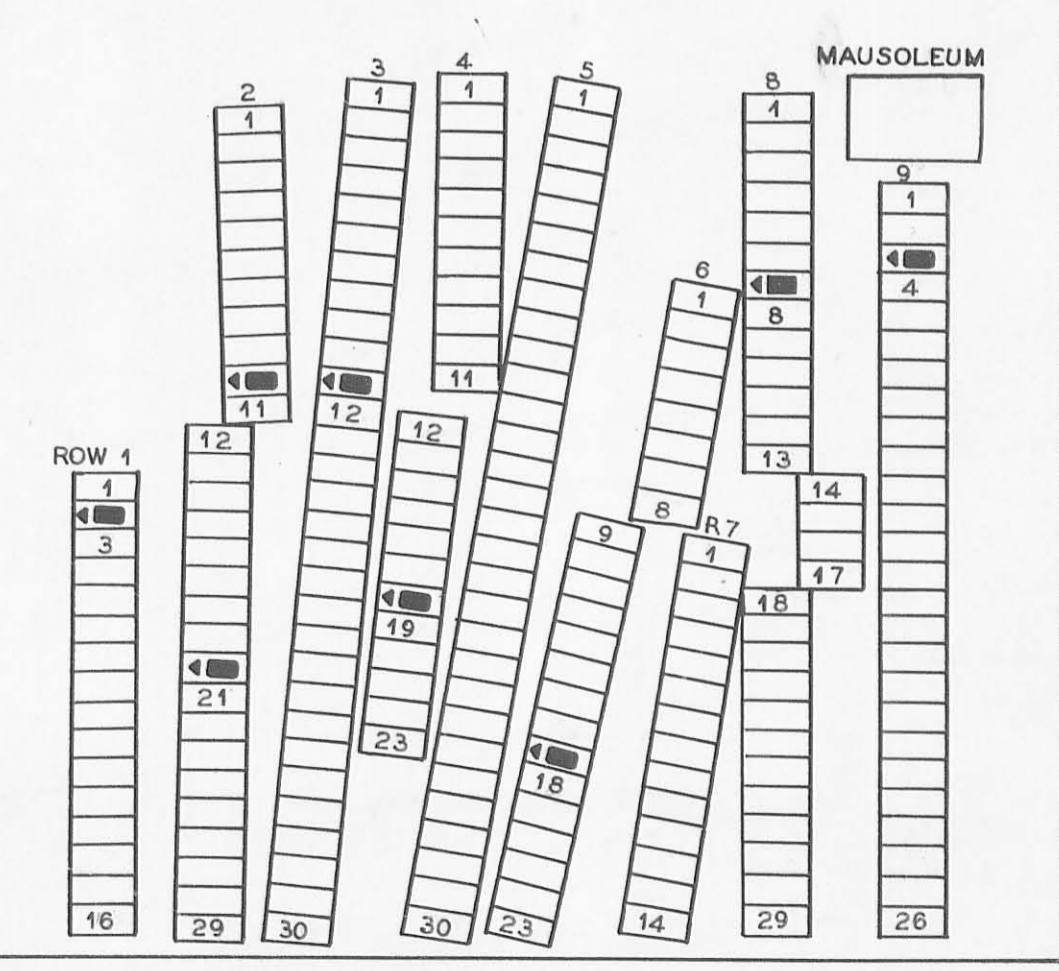

SCALE 1" = 20'

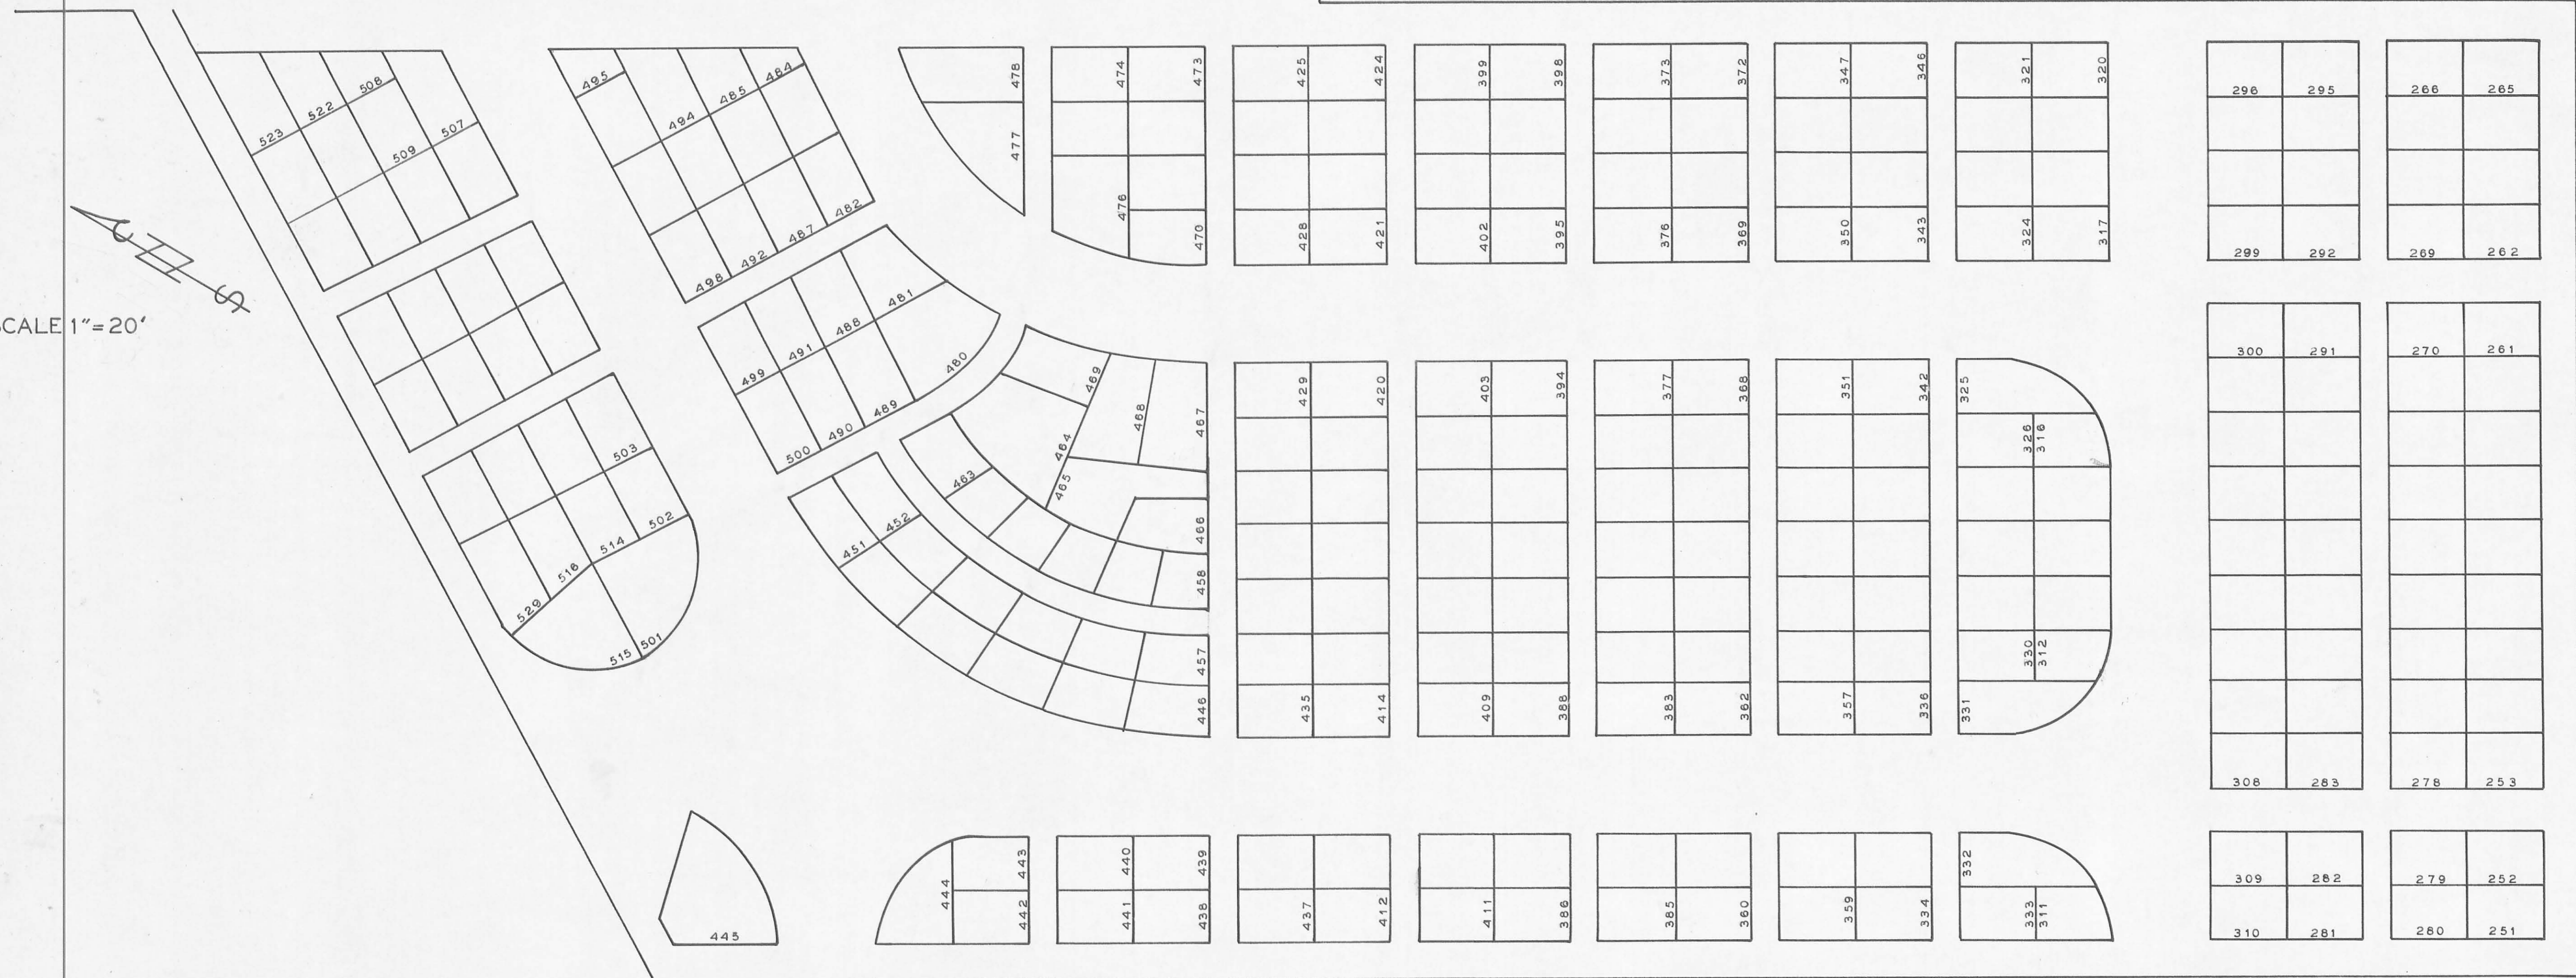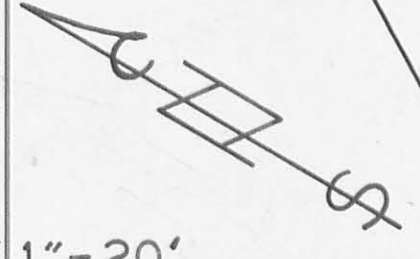

NAME	SEC	L	R	G	W
BRANSON ROBERT	11		25	10	
CAMPBELL ARTHUR T.	18		48	19	
DAWSON THOMAS H.	4B		39	19	
DIXON THOMAS	17		12	19	
EICHER DAVID U.	9		14	19	
HAINES BENJAMIN	14		29	10	
HAINES HUDSON M.	4B		31	19	
MOORE HENRY	11		17	10	
PAINTER WM.	16		38	16	
SHARP ALLEN	9		5	10	
SHARP HUDSON F.	4A		5	19	
SHARP JOHN D.	7		22	19	
SHARP DAVID	7		6	10	
THOMPSON MAHLON	1		22	19	
WALLACE RICHARD	12		2	10	

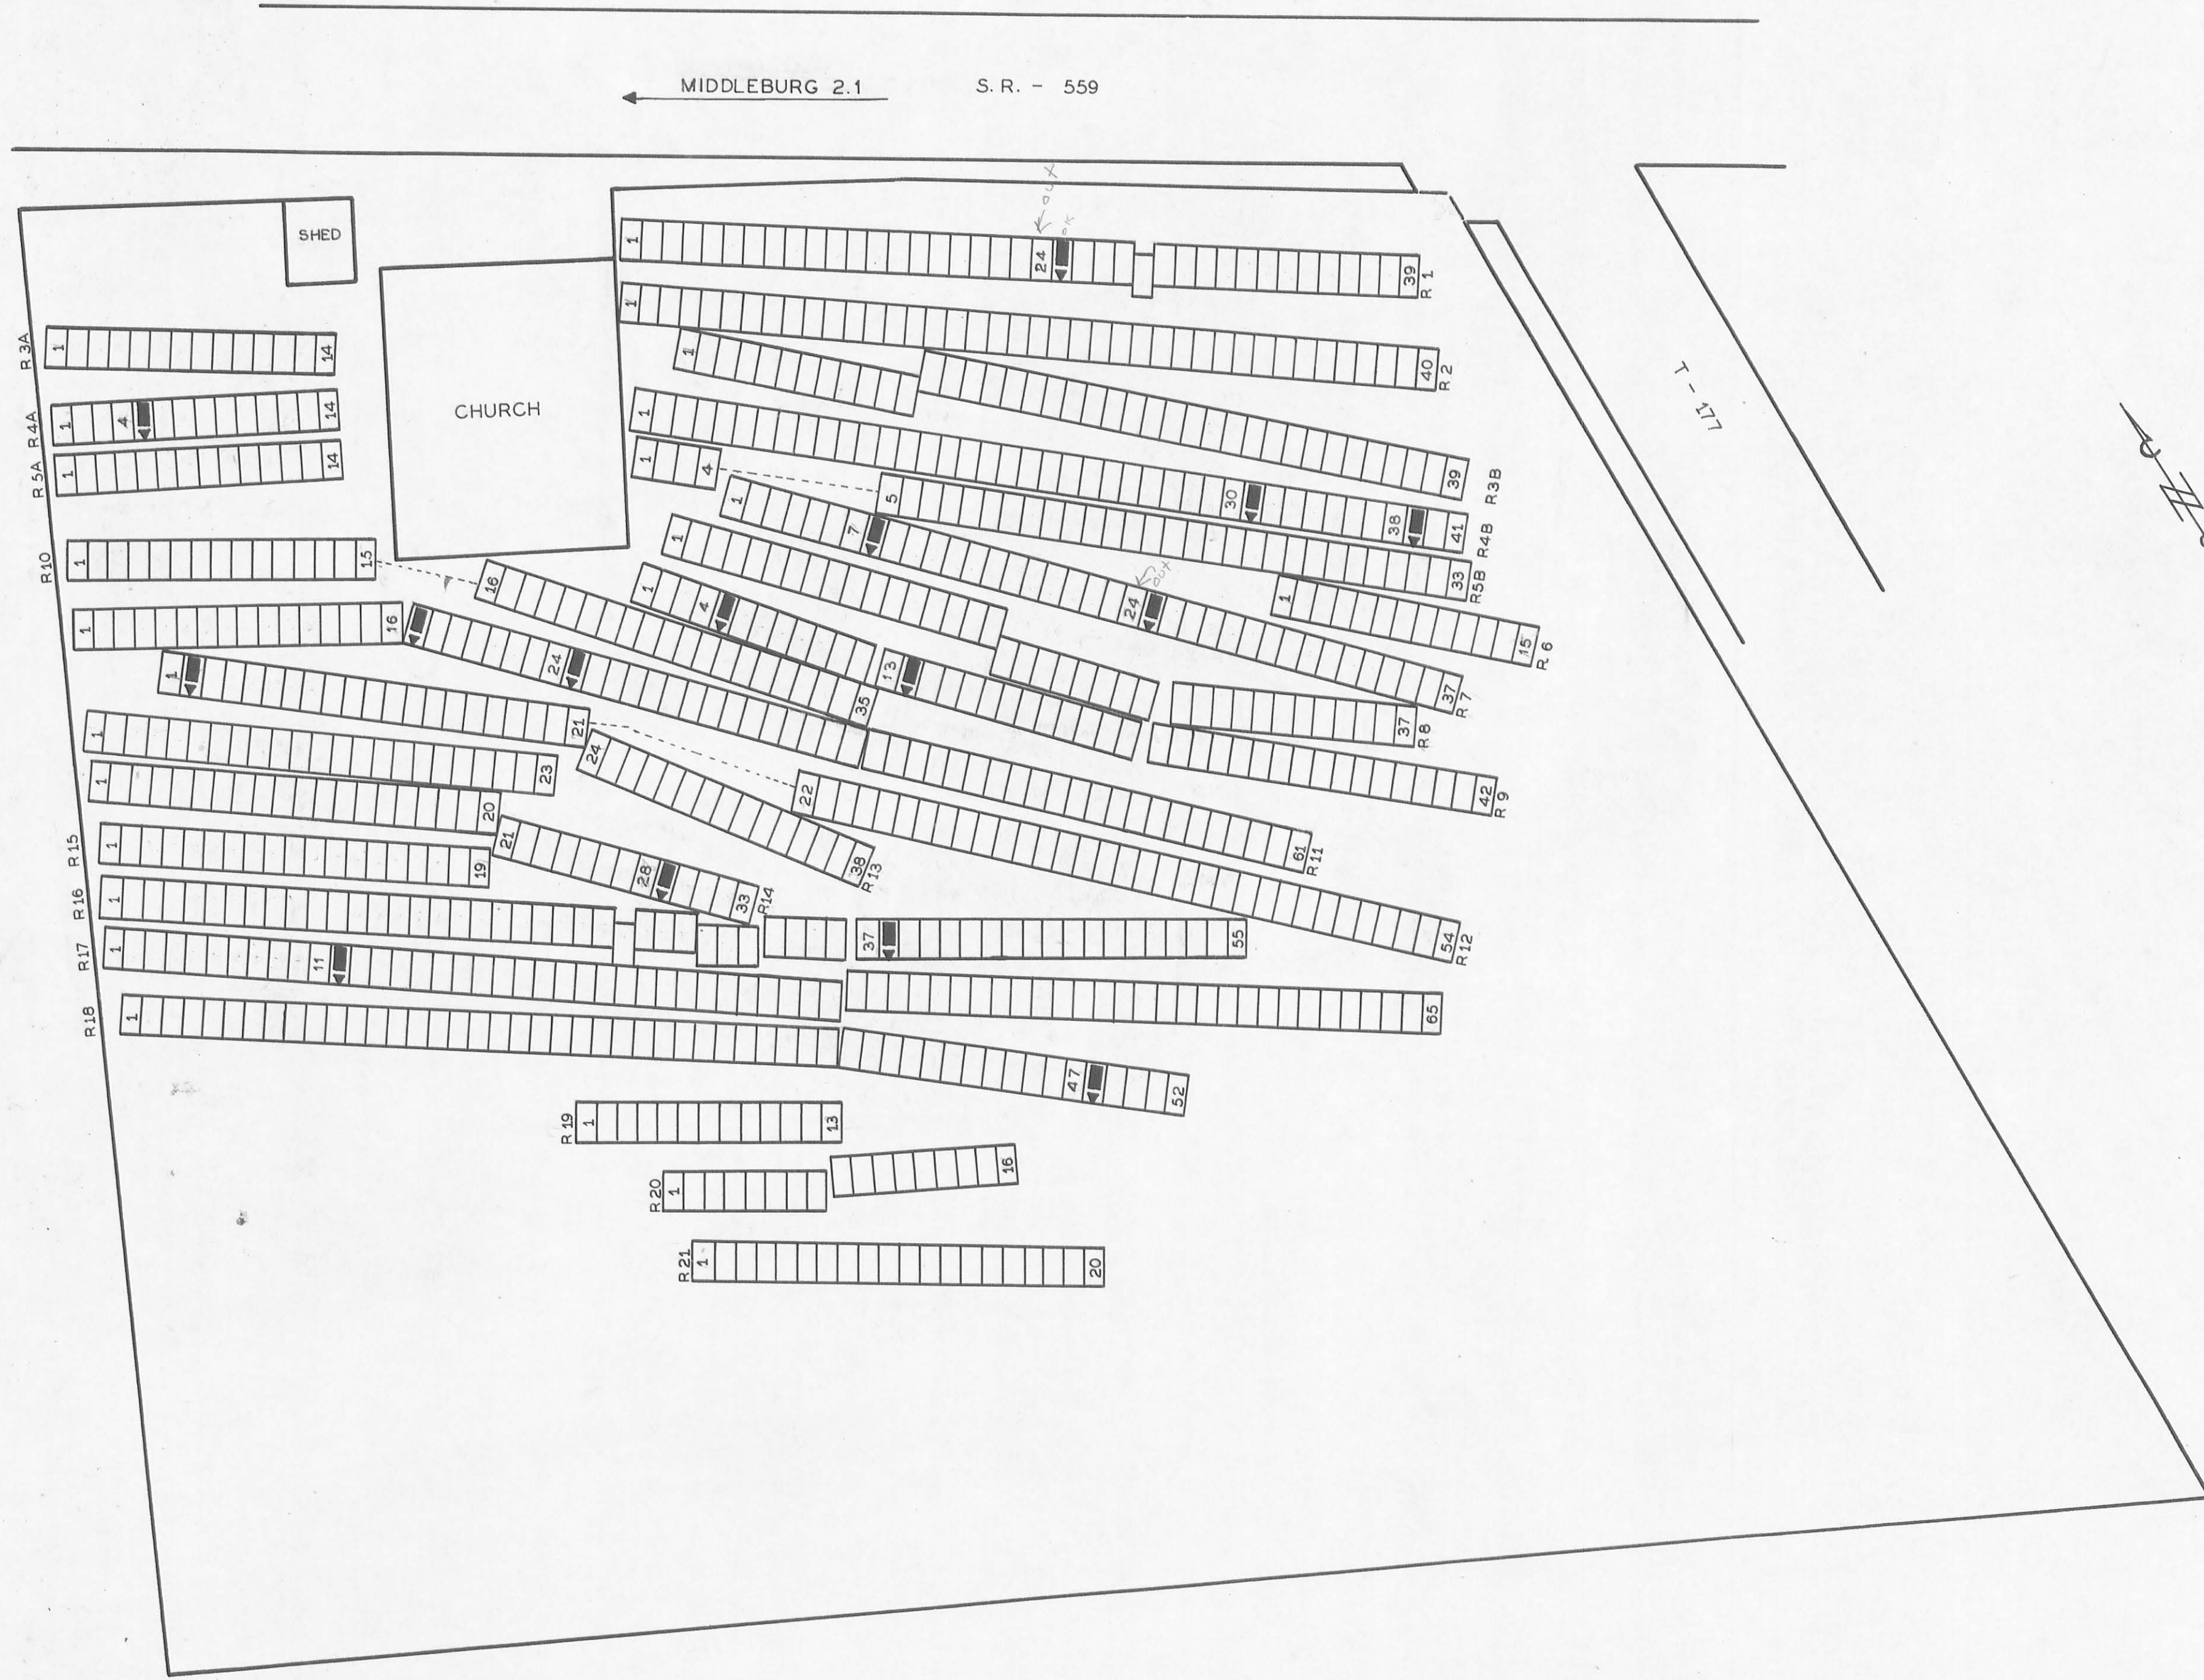

LEGEND  
 SEC=SECTION L=LOT R=ROW  
 G=GRAVE W=WAR  
 X=POSITION UNKNOWN

**MT. MORIAH  
 CEMETERY**



LOGAN CO. ZANE TWP.

OFFICIAL PROJECT NO.465-42-3-467&665-42-3-232

<p><b>LEGEND</b></p> <p>① REVOLUTIONARY WAR</p> <p>⑩ WAR OF 1812</p> <p>⑪ WAR WITH MEXICO</p> <p>⑲ CIVIL WAR</p> <p>⑳ SPANISH AM. WAR</p> <p>㉓ WORLD WAR</p> <p>SCALE 1" = 20'</p>	<p><b>HISTORY</b></p> <p>2.0 ACRES</p>
--	--

NAME	SEC	L	R	G	W
BEAN WILLIAM M.	58			1	19
CARTER RALPH E.	17			2	34
CHAMBERLAIN WM. R.	64			3	19
HALE JACOB W.	73			2	19
HAYES JOHN N.	74			5	19
MC MILLEN THOMAS R.			10	6	19
MEYERS JOHN.			7	37	19
MOORE ANDREW.	56			4	19
MOORE ARCHIBALD.			9	36	19
MOORE CYRUS A.			14	34	19
NEWELL HUGH.			1	36	10
NEWELL JAMES.	55			1	19
NEWELL JOHN.	121			17	19
PACKER WILLIAM H.			2	45	19
SWEET JOSHUA.			11	24	10
THOMPSON JAMES H.	63				1
MOHR JOSEPH			4		10

T - 201      S.R. 508 - 4MI. →

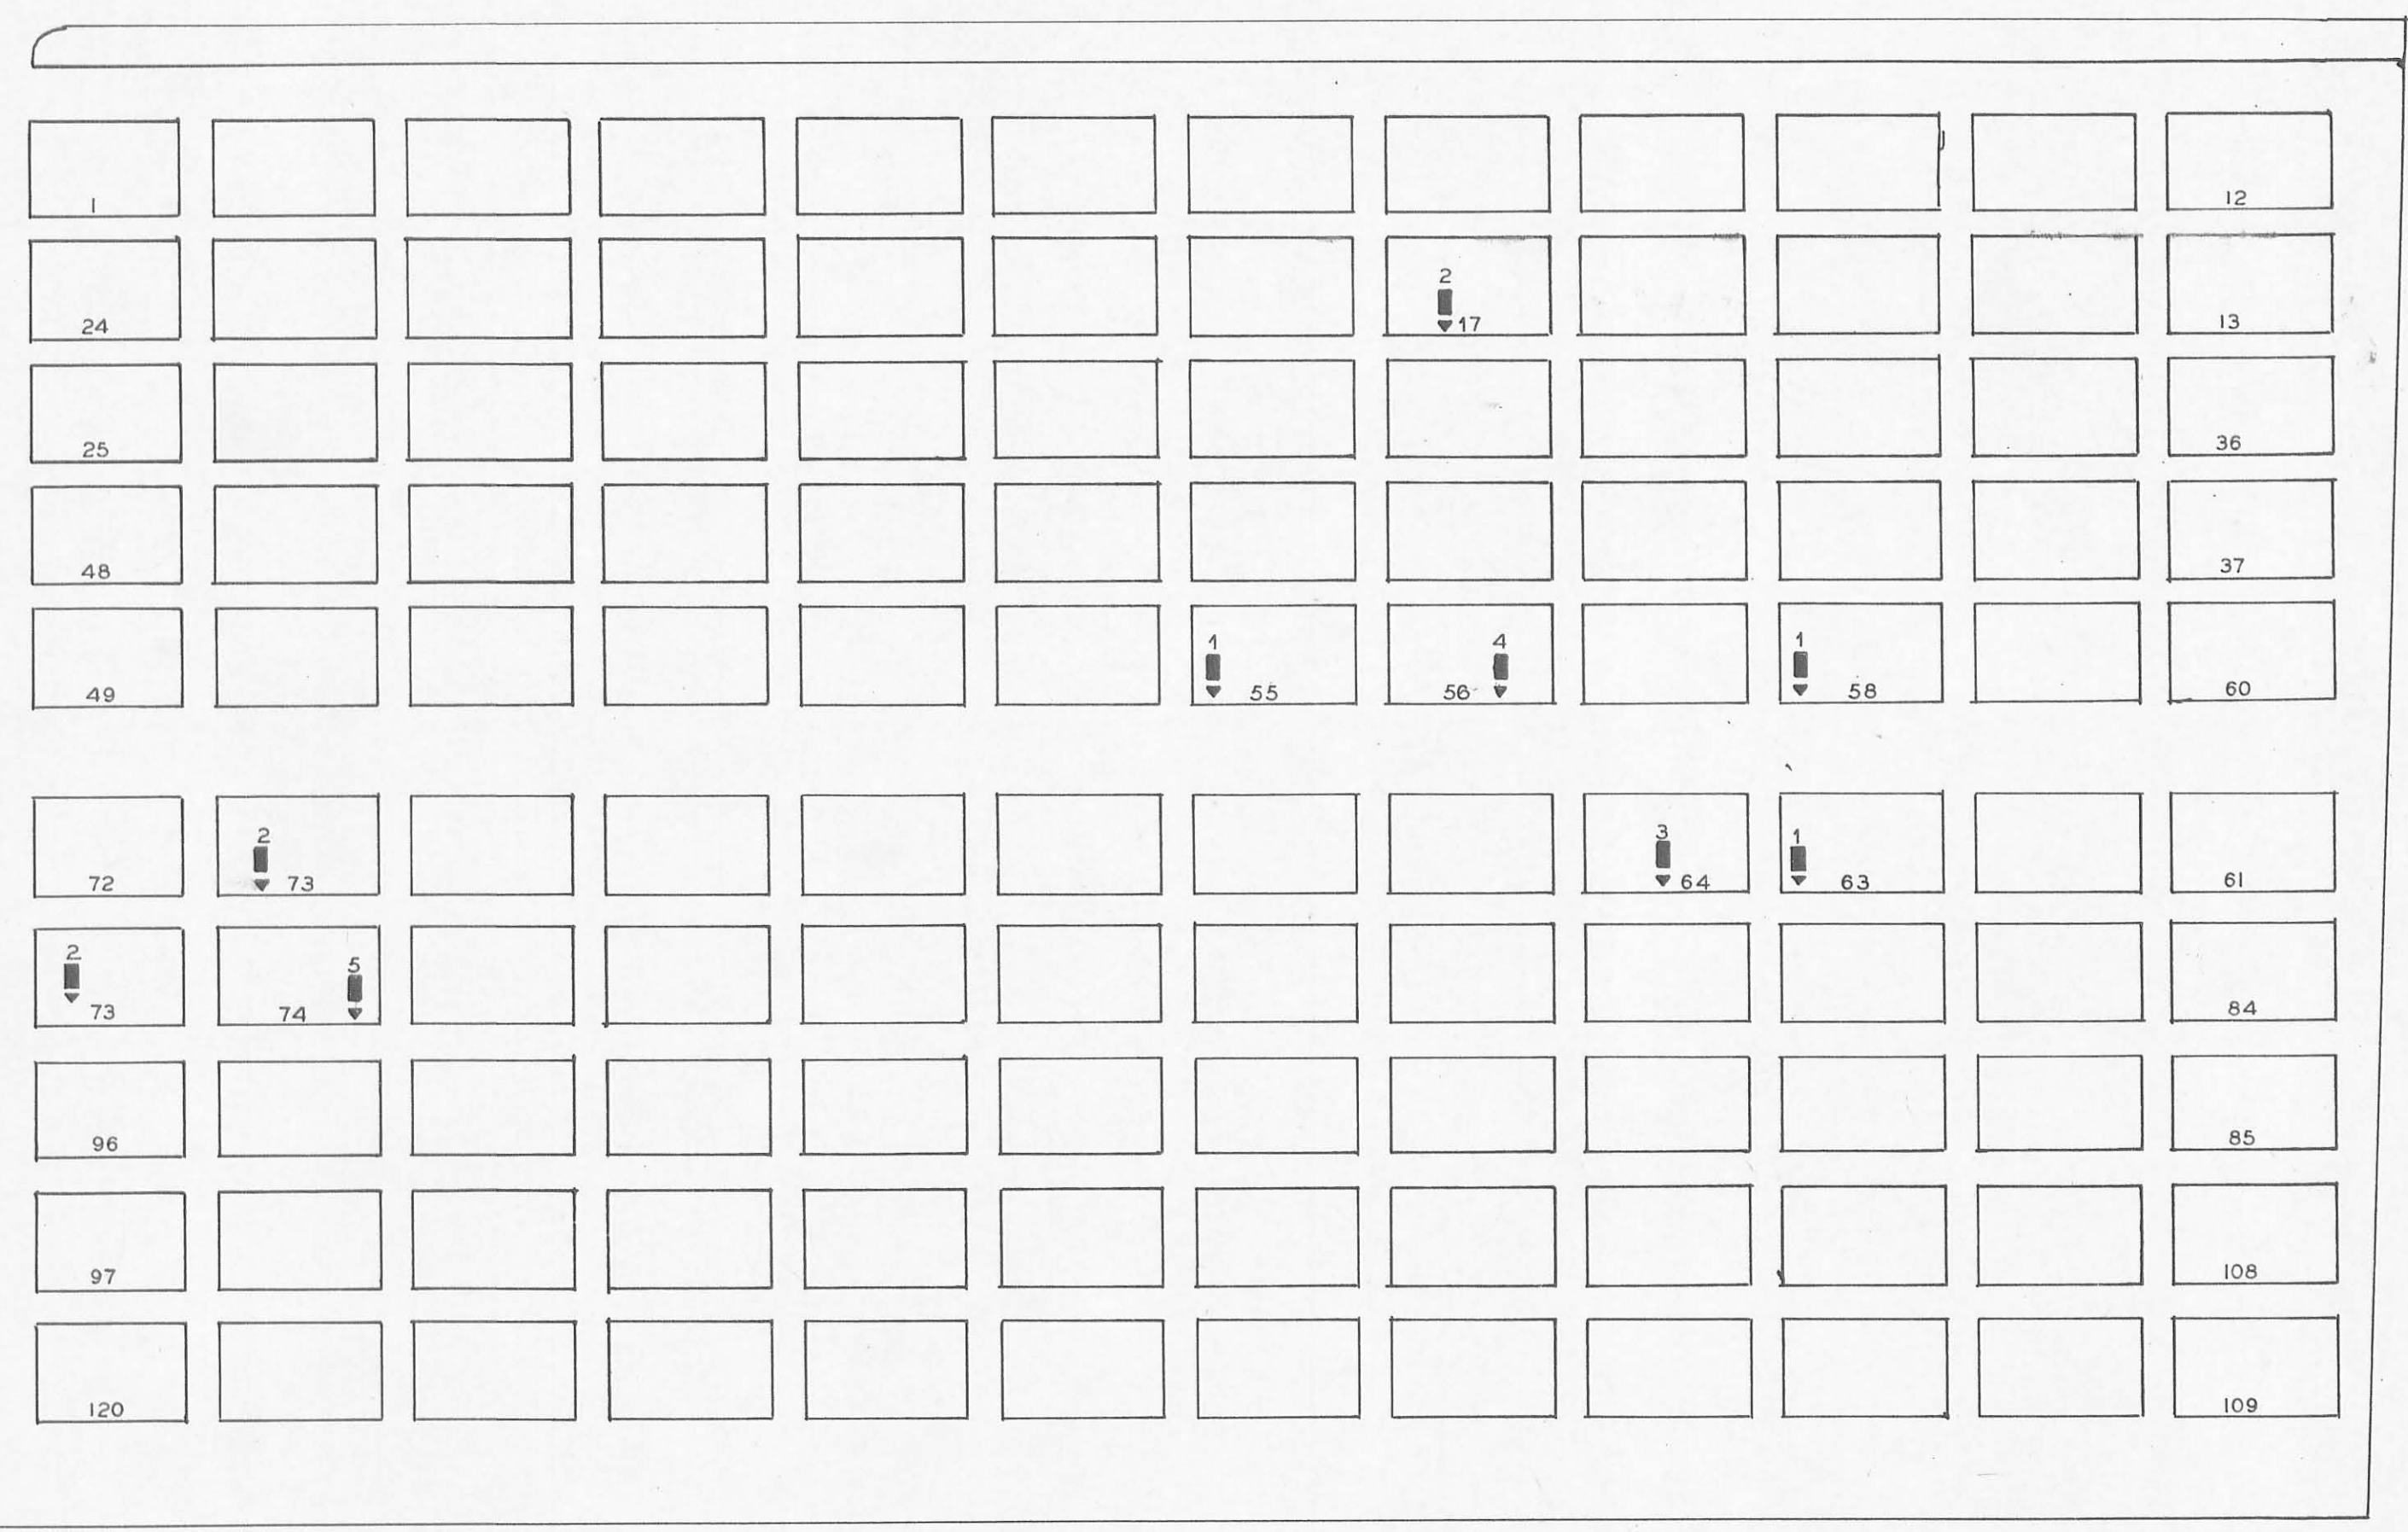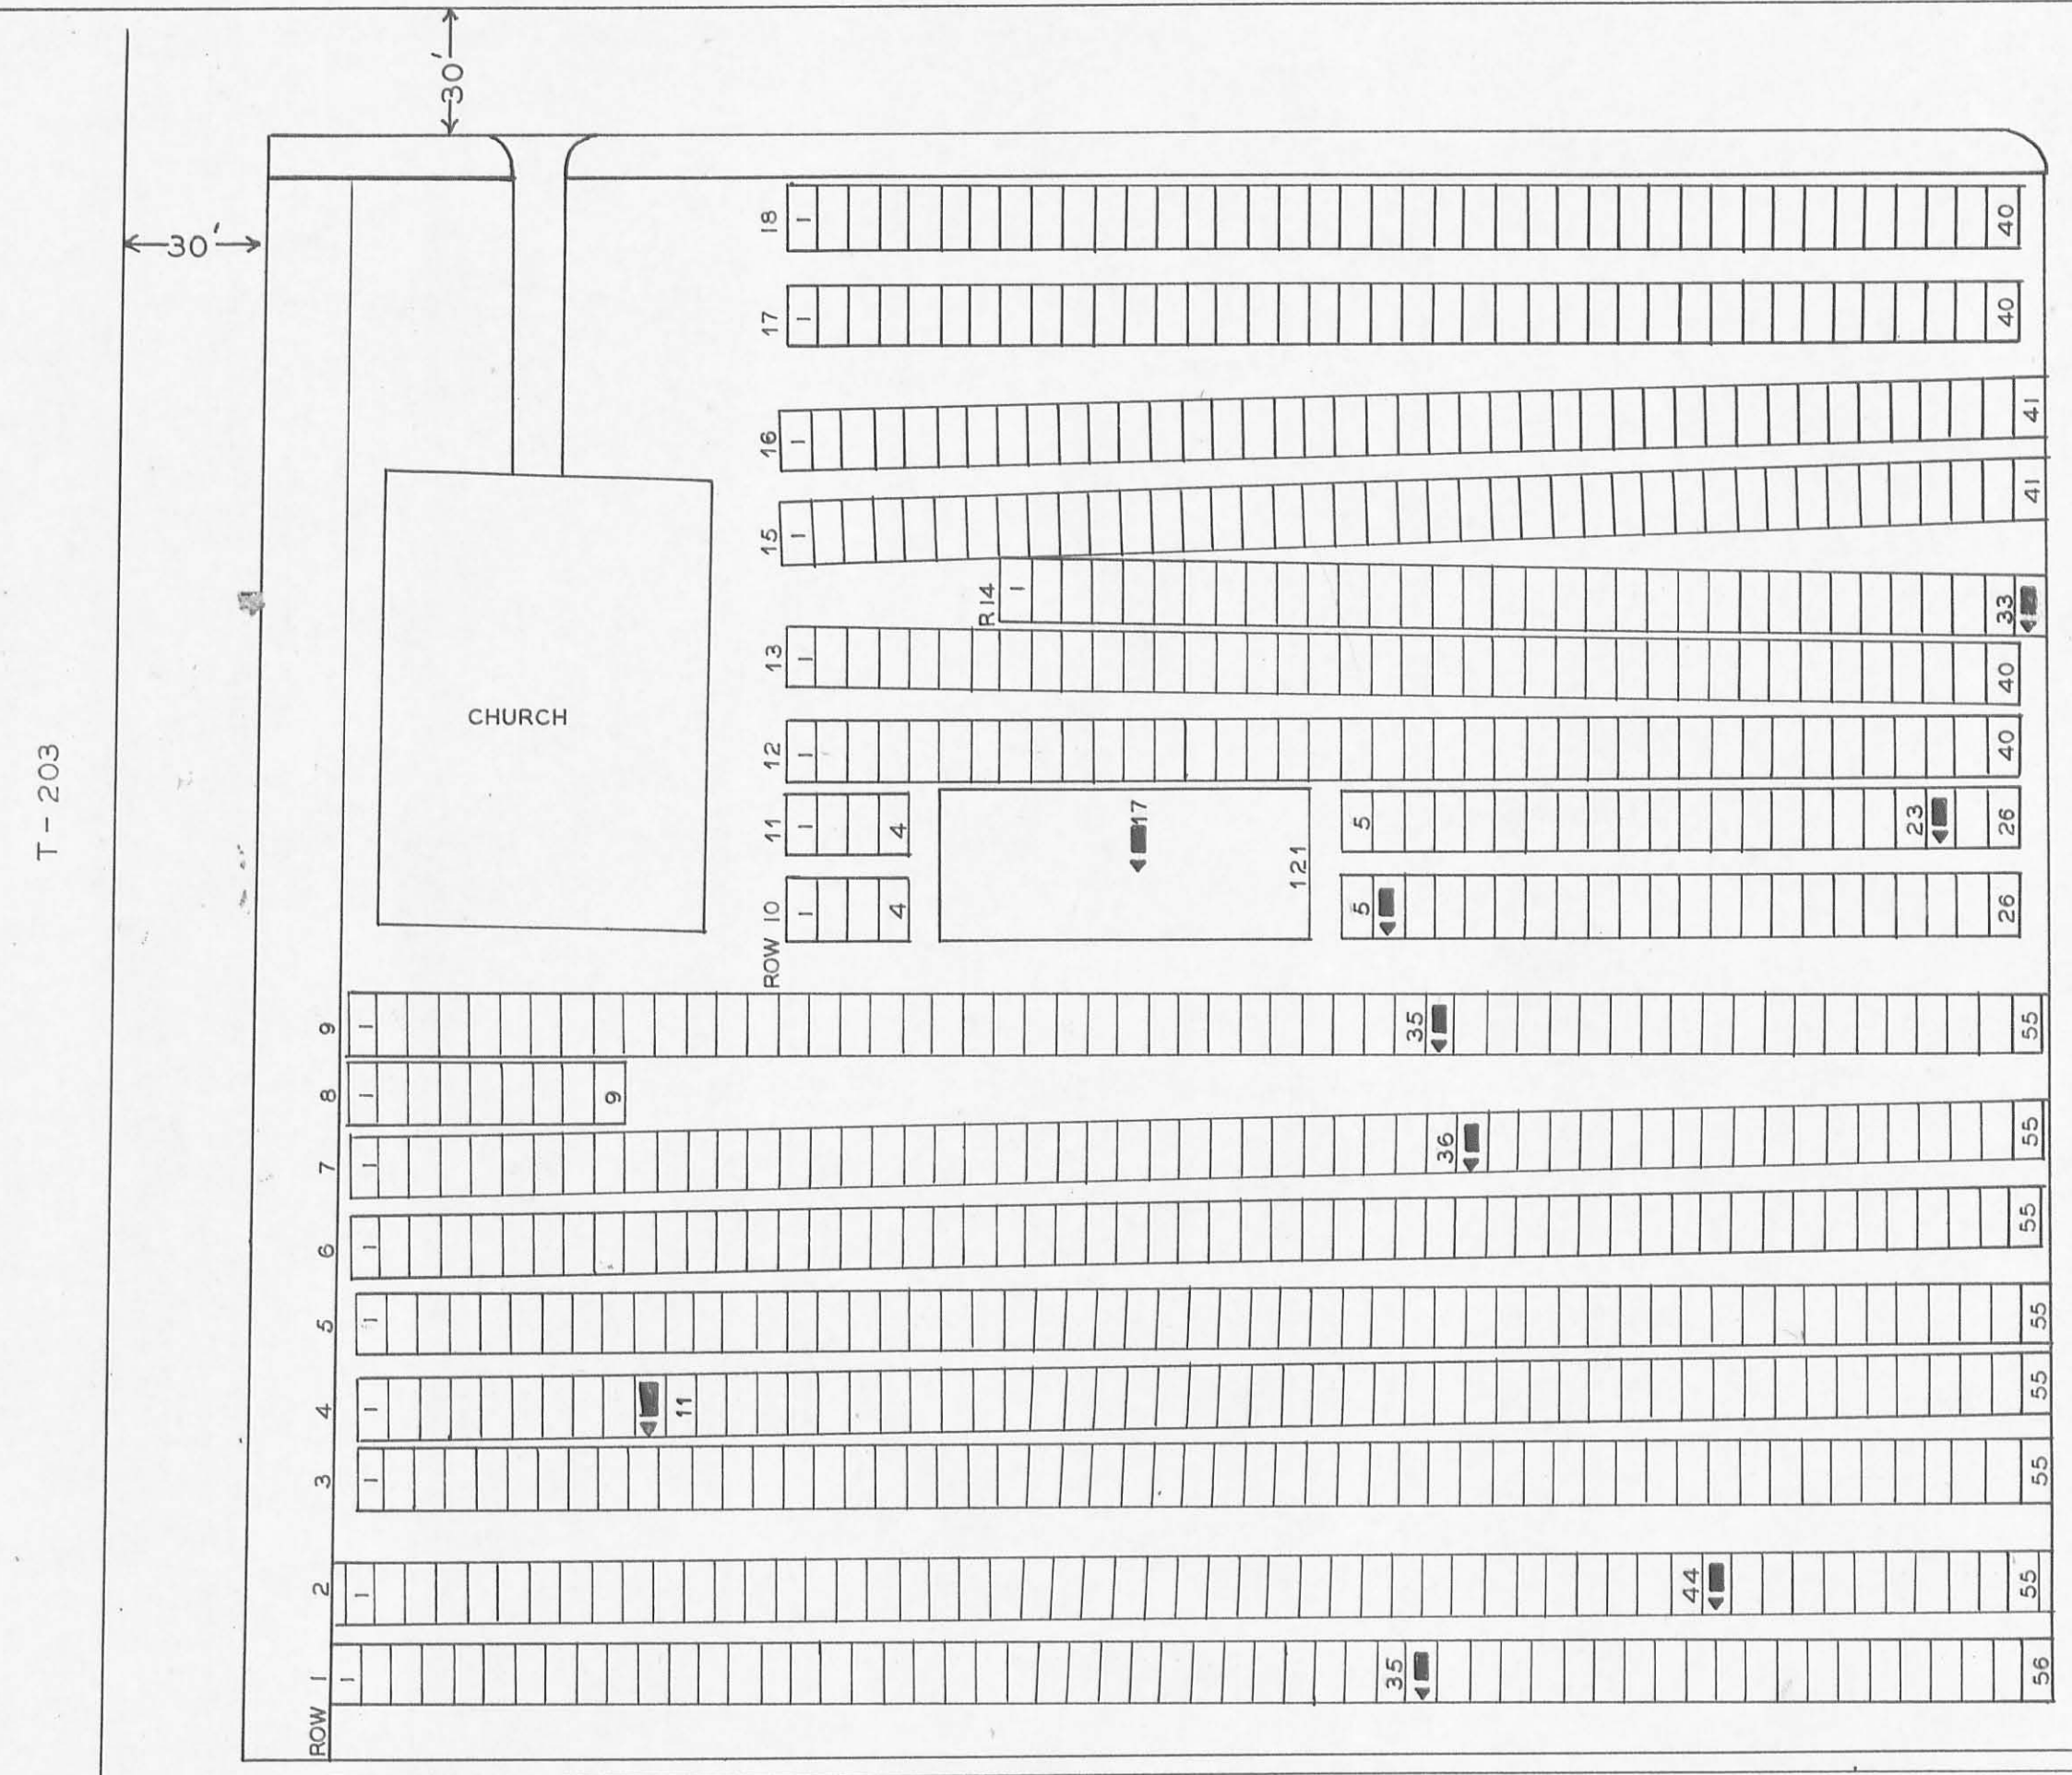

NEW PHILADELPHIA  
CEMETERY



LOGAN CO. UNION TWP.

OFFICIAL PROJECT NOS. 465-42-3-467&665-42-3-232

<p>LEGEND</p> <p>① REVOLUTIONARY WAR</p> <p>⑩ WAR OF 1812</p> <p>⑮ MEXICAN WAR</p> <p>⑲ CIVIL WAR</p> <p>⑳ SPANISH AM. WAR</p> <p>㉑ WORLD WAR</p> <p>SCALE 1"=20'</p>	<p>HISTORY</p> <p style="text-align: right;">2.5 ACRES</p>
---	--

LEGEND  
SEC=SECTION L=LOT R=ROW  
G=GRAVE W=WAR  
\*-POSITION UNKNOWN

NAME	SEC	L	R	G	W
ATKINSON W C	115			1	19
COLLINS JOHN	82			1	19
CORWIN MILTON		6		16	
CRANKLETON JAMES	98			3	19
CRANKLETON WILLIAM	90			1	19
DUNLAP SAMUEL			9	15	10
ROGERS SAMUEL J			13	18	19
SIMPSON SAMUEL		104		2	19
SLONECKER DAVID B		111		2	19
SLONECKER HENRY		94		3	19
UNANGST MICHAEL			4		5
Rice Robert L.			36		3

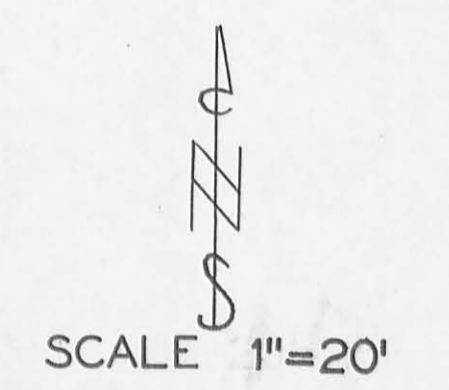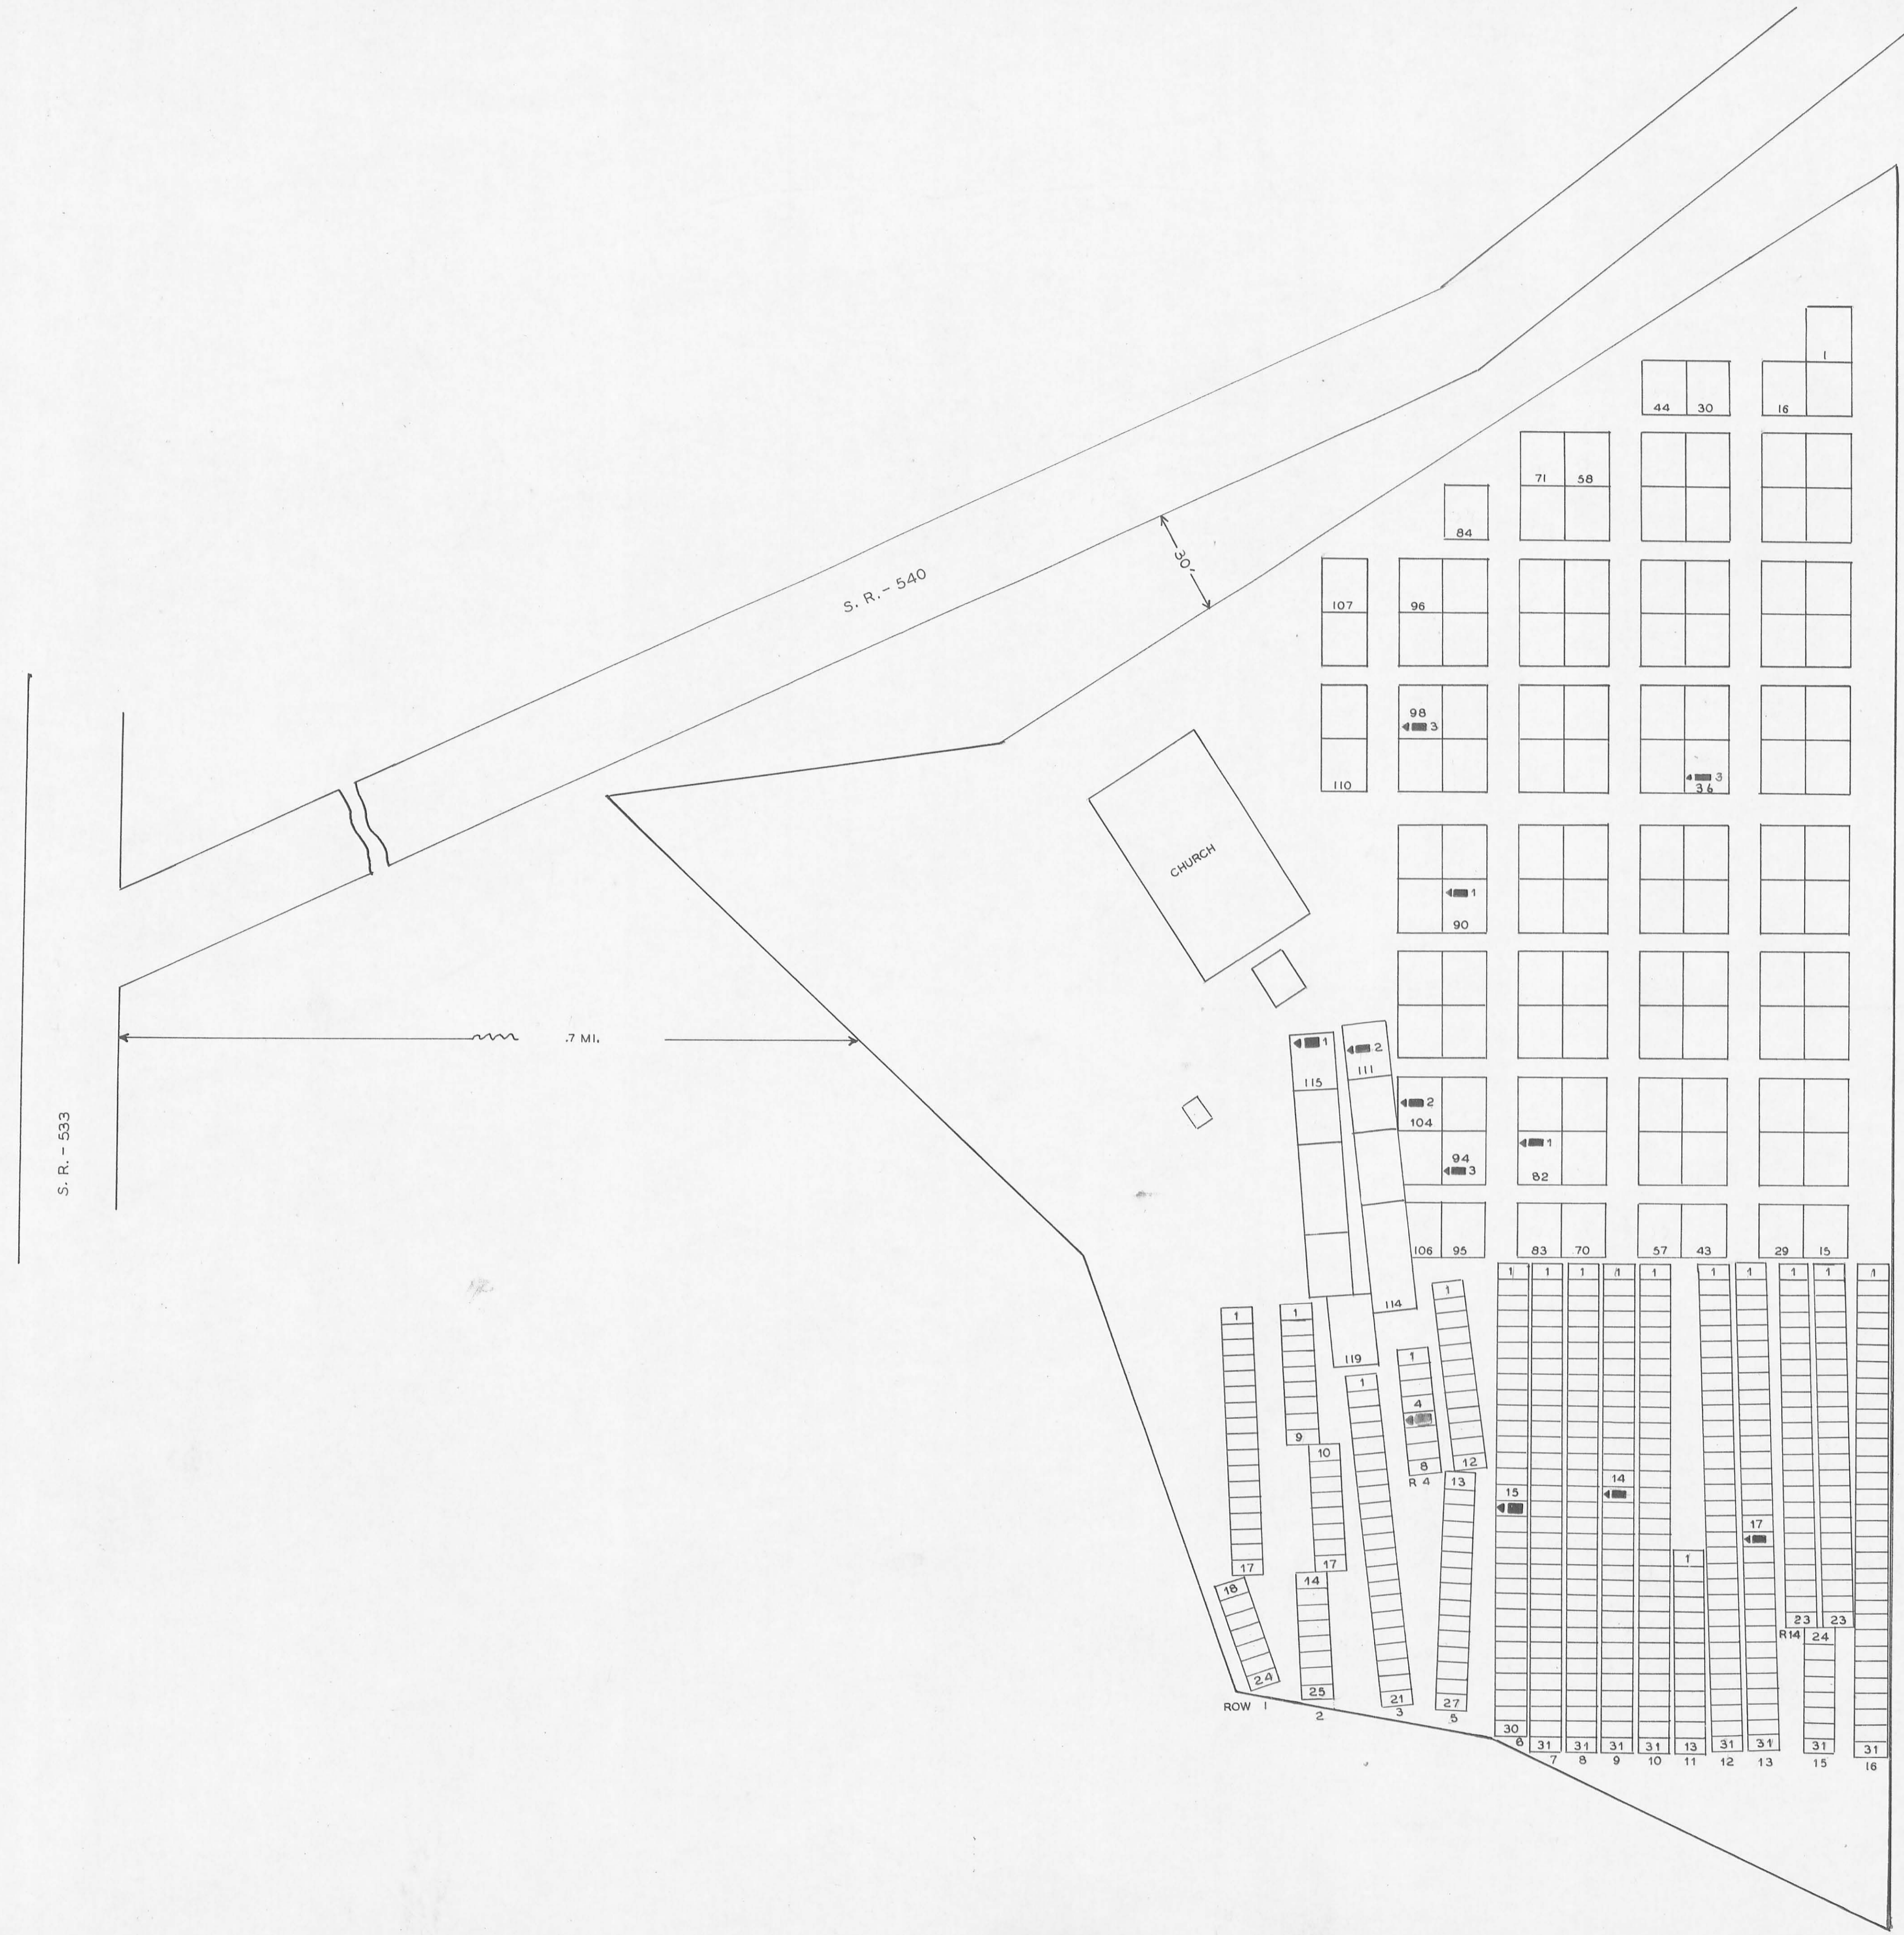

## NEW SALEM CEMETERY

LOGAN CO. JEFFERSON TWP.

OFFICIAL PROJECT NOS. 465-42-3-467&665-42-3-232

LEGEND	HISTORY
① REVOLUTIONARY WAR	
⑩ WAR OF 1812	
⑯ MEXICAN WAR	
⑲ CIVIL WAR	
⑳ SPANISH AM. WAR	
㉑ WORLD WAR	

ACRES 2.00

46-4-6

NAME	SEC	L	R	G	W
BARNETT JOHN			7	35	19
BOYD ROBERT			8	27	10
CAMPBELL JOHN			18	7	19
CLARK ALVIN	146			6	
CLARK ROBERT S	146			3	19
COFFELT AARON C	127			4	19
COOKE C W	206			3	19
CRAWFORD JOHN	133			4	10
GRAY HUGH		24		23	19
GRAY JAMES		24		27	
GRAY JAMES R		24		22	19
GRAY ROBERT W		24		28	19
JOHNSTON JAMES S	90			5	19
JOHNSTON JOHN B	151			3	19
JOHNSTON MARTIN	28			22	19
JOHNSTON WILLIAM C	46			4	19
LIGGETT ALEXANDER	114			3	19
M'CUNE JAMES	102			5	19
MURPHY JOSEPH A	26			16	16
PATTERSON ABRAHAM G.	191			4	19
PATTERSON ABRAHAM	115			6	19
POLLOCK WILLIAM	207			6	10
REED JAMES L	18			3	19
STEPHENSON JOHN	9			6	19
STEWART THOMAS W	143			5	19
TRUMBULL ROBERT H.	164			4	19
VANCE JAMES W	18			33	19
WYNEGAR HENRY	19			4	19
WYSONG JAMES M	28			4	19
ZUPP PHILLIP	94			3	19
SUPPLEMENTARY LIST					
RITCHIEY C.C.	125			3	
MC KUNE DAVID	2			33	



636  
S. R. 1

**NORTHWOOD CEMETERY**  
LOGAN CO. MC-ARTHUR TWP.

OFFICIAL PROJECT NOS. 465-42-3-467&665-42-3-232


<p><b>LEGEND</b></p> <p>① REVOLUTIONARY WAR</p> <p>⑩ WAR OF 1812</p> <p>⑯ WAR WITH MEXICO</p> <p>⑰ CIVIL WAR</p> <p>⑳ SPANISH AM. WAR</p> <p>㉑ WORLD WAR</p>	<p><b>HISTORY</b></p>
--	-----------------------

SCALE 1 = 20      ACRES 4.00

LEGEND  
SEC=SECTION L=LOT R=ROW  
G=GRAVE W=WAR  
X=POSITION UNKNOWN

46-7-4 Ho-4 46-7-4



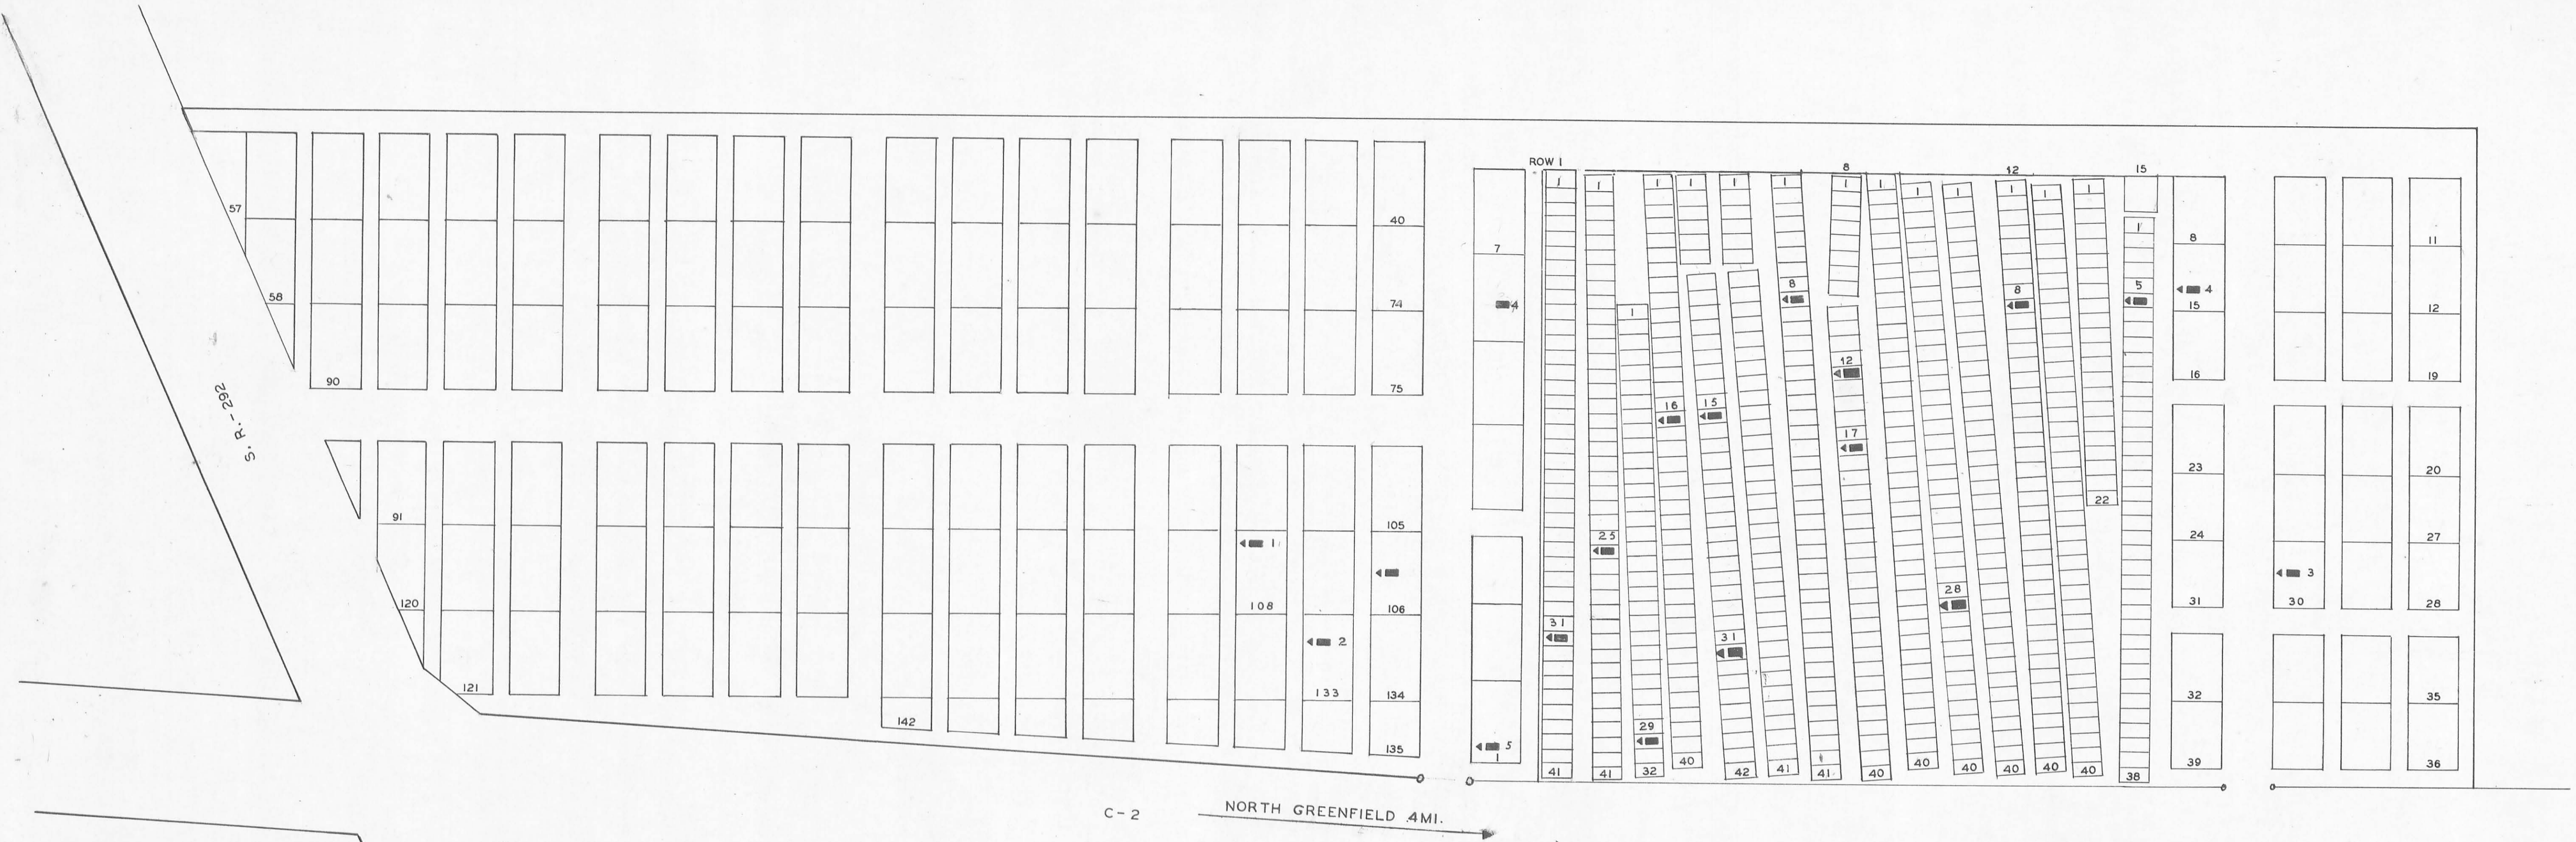

NAME	SEC	L	R	G	W
AMERINE JOHN W.	106		3	19	
BRAKE JAMES A.	6		4	19	
BUSHONG JAMES	30		3	19	
GWYNN JOHN	108		1	19	
HAINES JOS.		5	16	10	
HARRIMAN DAVID H.		4	17	19	
HARRIMAN HOWARD		1	32	25	
HUMPHREYS JACOB		3	30	19	
MITCHELL LEONARD H.		2	26	19	
MOORE J. B.			5		
MOORE SAMUEL		7	9		
MOORE SYLVESTER		15	6	19	
ORR HARVEY H.		12	9	19	
SALTZ SAMUEL H.	133		2	19	
TURNER WILLIAM	15		4	19	
VAN VOORHIS JOHN C.	8		18	19	

SUPPLEMENTARY LIST

FISHER WILLIAM	10	29
ROBERTS WILLIAM B.	5	32

NAME	R	G
HEISLER ISIAH	R8	G13

NORTH GREENFIELD  
CEMETERY  
LOGAN CO. PERRY TWP.

OFFICIAL PROJECT NOS. 465-42-3-467 & 665-42-3-2-32

LEGEND	HISTORY
①	REVOLUTIONARY WAR
⑩	WAR OF 1812
⑮	WAR WITH MEXICO
⑲	CIVIL WAR
⑳	SPANISH AM. WAR
㉑	WORLD WAR

SCALE 1 = 20      ACRES 2.5

6775

NAME	SEC	L	R	G	W
PIATT A.S.	MAUSOLEUM B		8C		19
PIATT DONN	MAUSOLEUM A		6C		31
PIATT HAROLD WM.		6		57	19
PIATT KENTUCK B.		6		39	19
PIATT RIVEROAK J.	MAUSOLEUM B		2C		19
PIATT WILLIAM MCCOY		8		58	19
PIATT CHARLES B.	MAUSOLEUM B	11C			19
PIATT HERSCHEL A.		8		56	31

T - 47













30'

S.R. 275 - 3MI.

MAUSOLEUM B

MAUSOLEUM A

CHAPEL

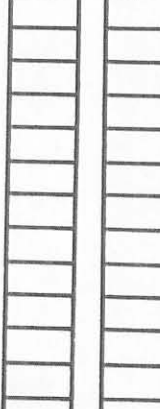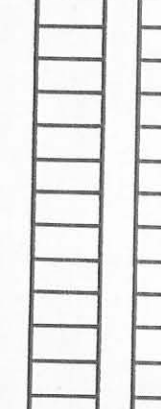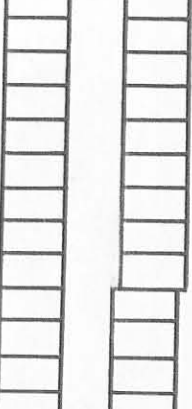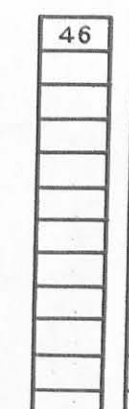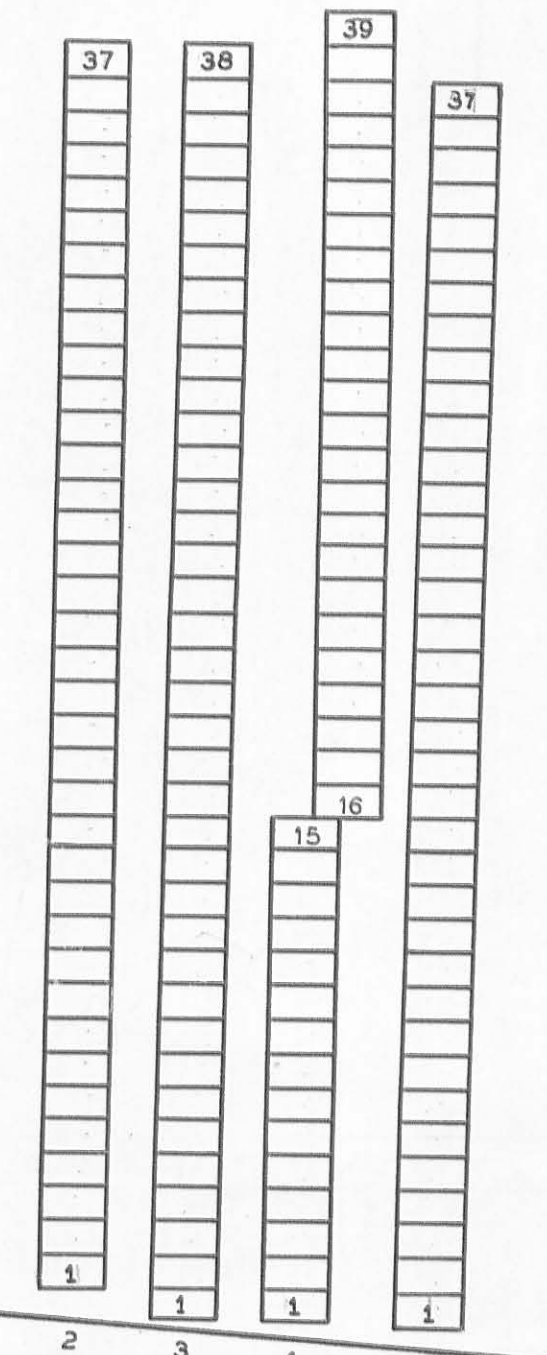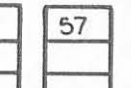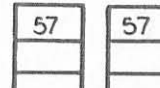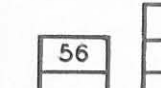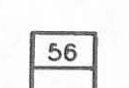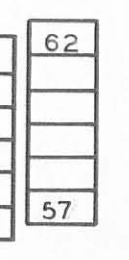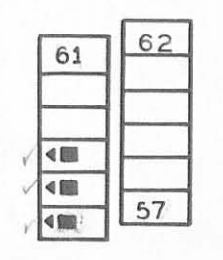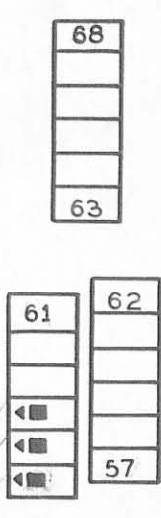

ROW 1

2

3

4

5

6

7

8

9

10

11

12

T - 175

LEGEND  
 SEC=SECTION L=LOT R=ROW  
 G=GRAVE W=WAR C=CRYPT  
 X=POSITION UNKNOWN

## PIATT CEMETERY

LOGAN CO. MONROE TWP.

OFFICIAL PROJECT NOS. 465-42-3-467 & 665-42-3-232

LEGEND	HISTORY
<ul style="list-style-type: none"> <li>① REVOLUTIONARY WAR</li> <li>⑩ WAR OF 1812</li> <li>①⑥ WAR WITH MEXICO</li> <li>①⑨ CIVIL WAR</li> <li>②⑤ SPANISH-AM. WAR</li> <li>③① WORLD WAR</li> </ul>	

SCALE 1" = 20' 4.4 ACRE

A-Z

46-9-4